



- LEGEND**
- PROP. TYPE "H" INLET (MOD.)
 - EXIST. RUNWAY OR TAXIWAY LIGHT
 - EXIST. INLET
 - EXIST. JUNCTION BOX
 - EXIST. ELECTRICAL VAULT
 - EXIST. UNDERGROUND POWER
 - EXIST. POWER POLE W/ GUY WIRE

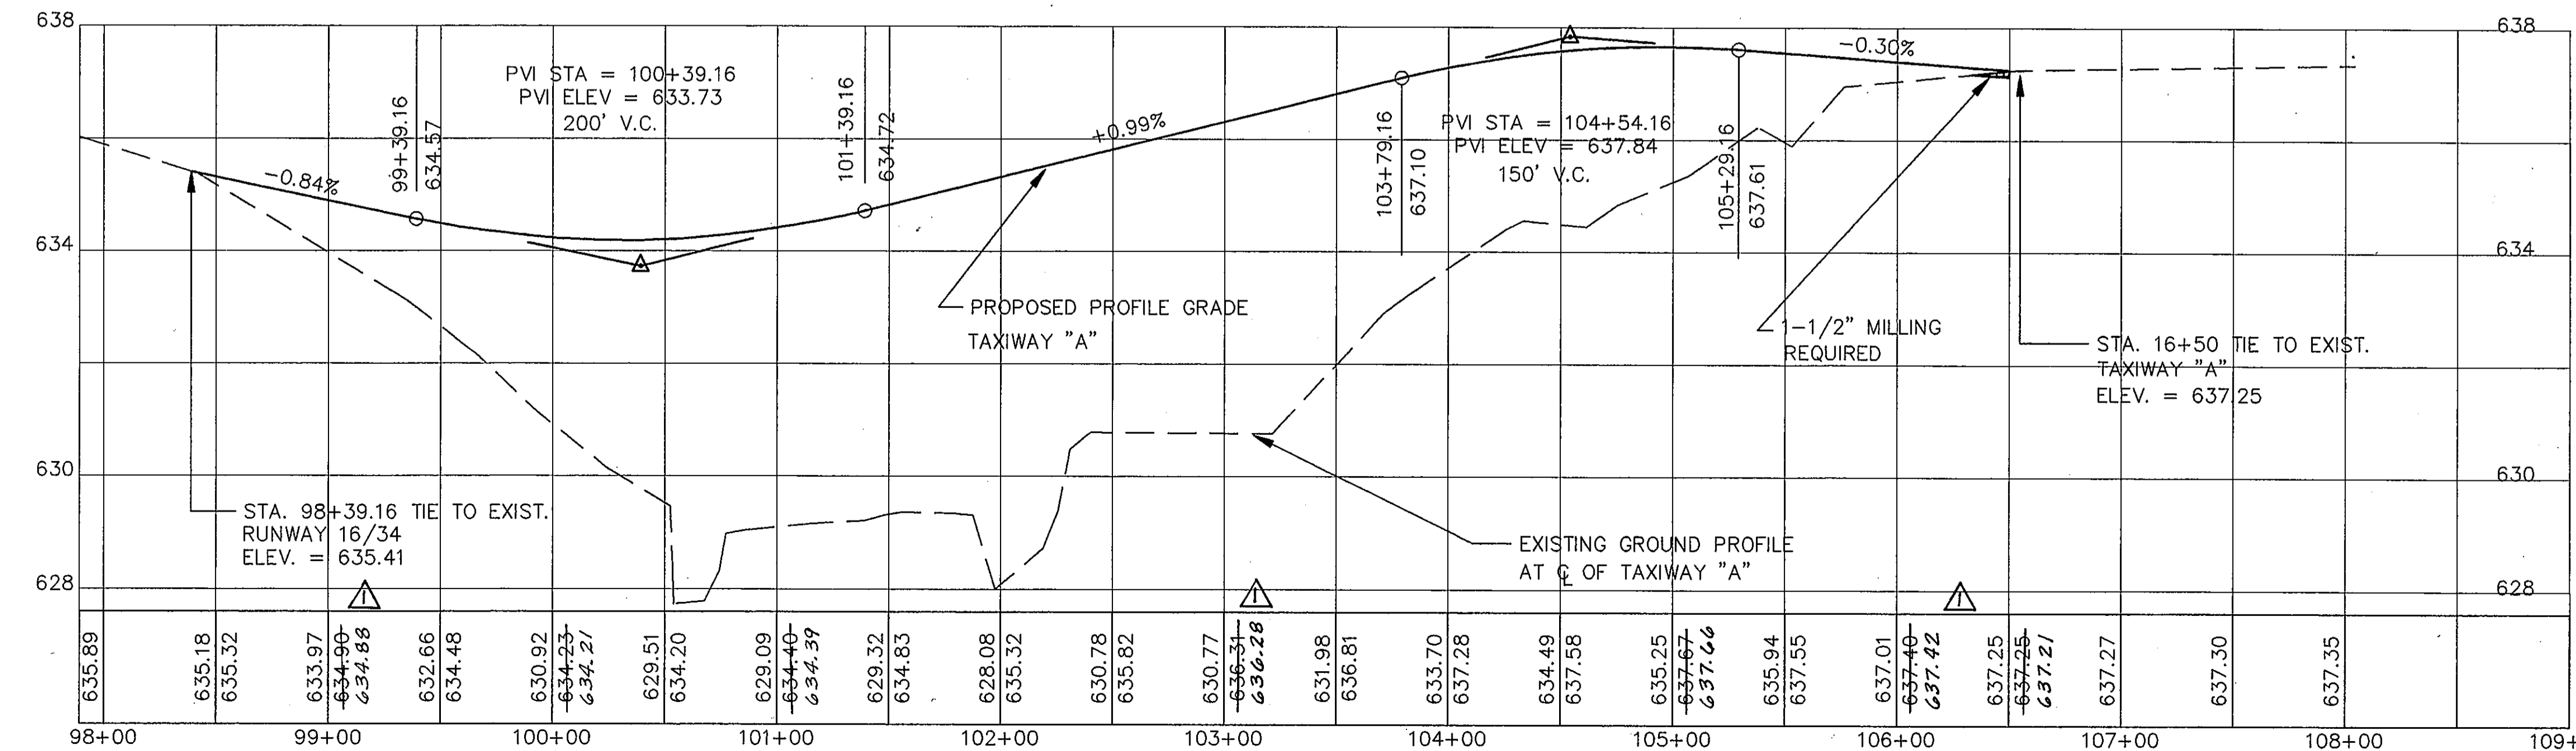

CAUTION UNDERGROUND UTILITIES
 CONTACT UTILITY COMPANIES FOR
 LOCATION PRIOR TO CONSTRUCTION
 ANY DAMAGE TO EXISTING FACILITIES
 WILL BE THE SOLE RESPONSIBILITY
 OF THE CONTRACTOR. ANY REPAIRS
 OR DAMAGES SHALL BE PAID FOR
 BY THE CONTRACTOR AT NO EXPENSE
 TO THE OWNER.

AS BUILT
 OCT 20 1995

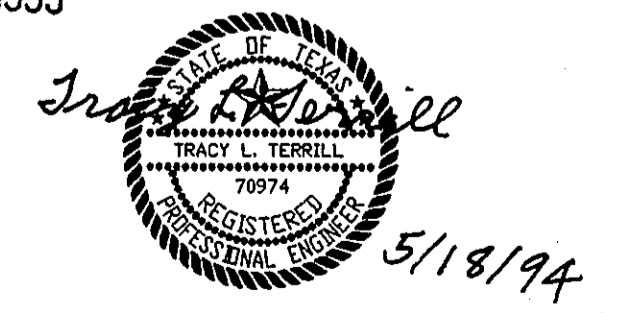

THE SEAL APPEARING ON THIS
 DOCUMENT WAS AUTHORIZED BY
 TRACY L. TERRILL, P.E.
 70974, DN MAY, 1994.

DESIGN: T.L.T.	A.I.P. NO. 3-48-0063-06	<table border="1"> <tr> <th>Date</th> <th>Revisions</th> <th>By</th> </tr> <tr> <td>4-20-95</td> <td>AS BUILT CHANGES</td> <td>JRH</td> </tr> </table>	Date	Revisions	By	4-20-95	AS BUILT CHANGES	JRH
Date	Revisions		By					
4-20-95	AS BUILT CHANGES		JRH					
DRAWN: M.J.G.	BID NO. 94-33							
CHECKED: L.D.T.	JOB NO. Y8024.60							
SCALE:								

Greiner, Inc.
 Greiner, Inc.
 Fort Worth, Texas
 Engineers, Architects
 and Planners

ADDISON AIRPORT

TAXIWAY "A" EXTENSION
 STA. 97+93.11 TO STA. 106+50
 SHEET 10
 DATE: MAY, 1994