



LEGEND

PROP. TYPE "H" INLET (MOD.)	
EXIST. RUNWAY OR TAXIWAY LIGHT	
EXIST. INLET	
EXIST. JUNCTION BOX	
EXIST. ELECTRICAL VAULT	
EXIST. UNDERGROUND POWER	
EXIST. POWER POLE W/ GUY WIRE	

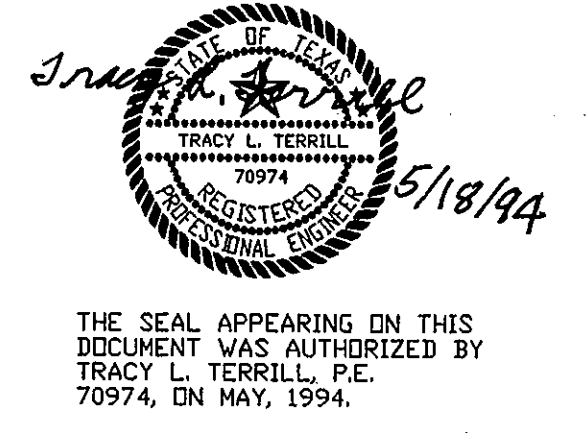

AS BUILT
OCT 20 1995

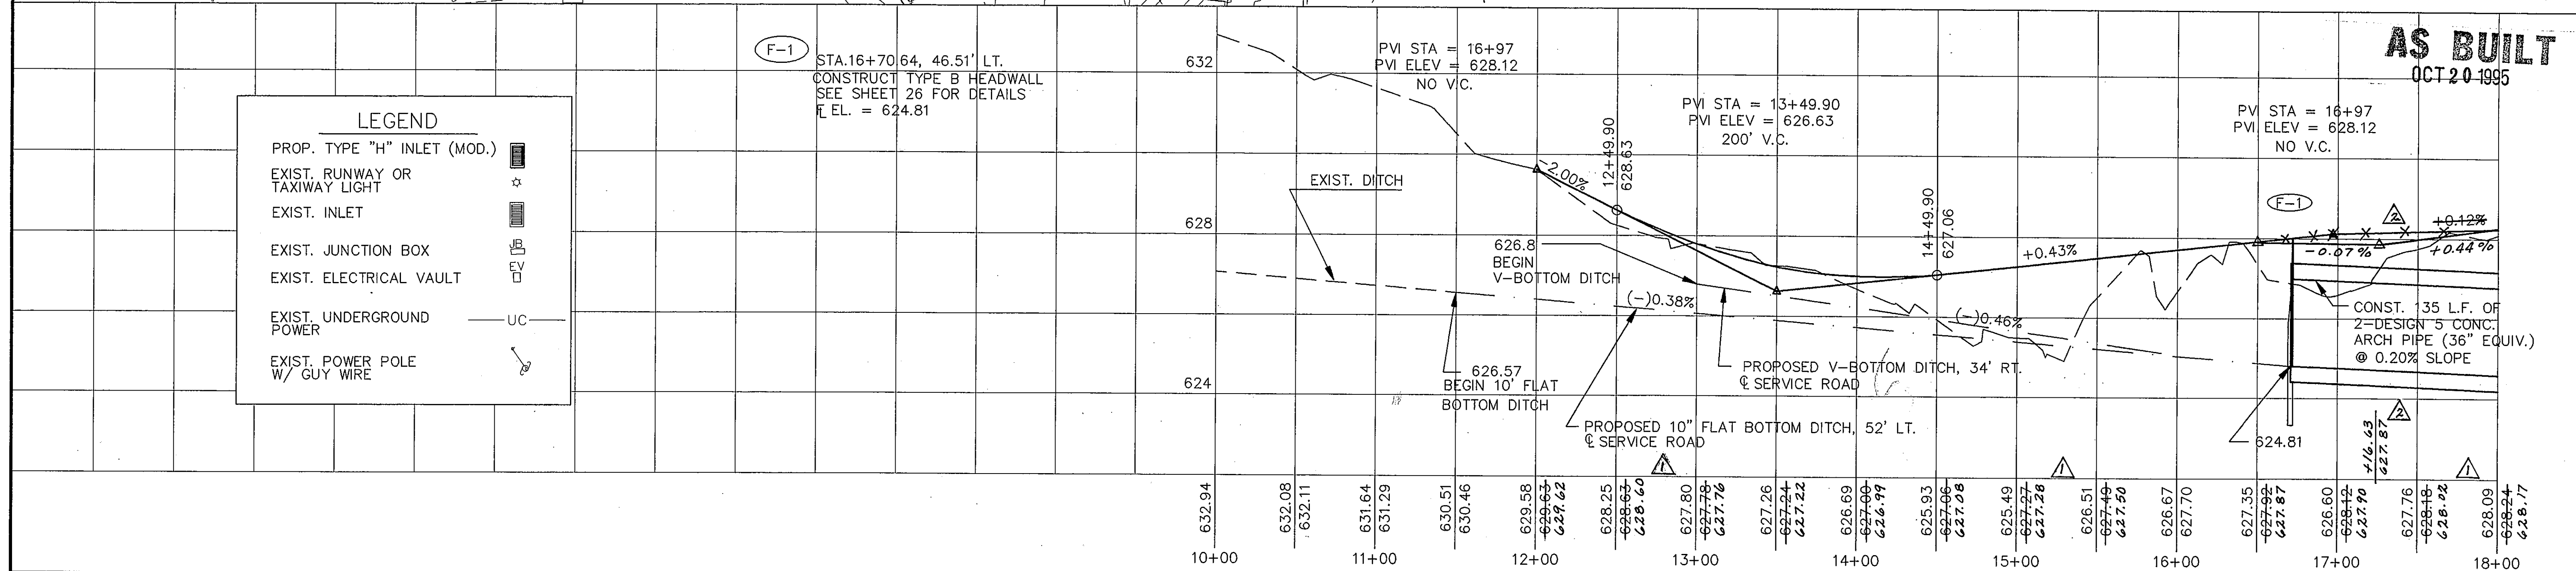

DESIGN: T.L.T.	A.I.P. NO. 3-48-0063-06	4-20-95	AS-BUILT CHANGES	JRH
DRAWN: M.J.G.	BID NO. 94-33	11-29-95	FIELD CHANGE CONC. FLUME	JRH
CHECKED: L.D.T.	JOB NO. Y8024.60	Date	Revisions	By
SCALE: 1"=50'				

Greiner, Inc.
 Greiner, Inc.
 Fort Worth, Texas

Engineers, Architects
 and Planners

ADDISON AIRPORT

NEW SERVICE RD. & DRAINAGE IMPROVEMENTS
 STA. 10+00 TO STA. 18+00

SHEET 11
 DATE: MAY 1994