


EXISTING CLEAR ZONE
500' X 1010' X 1700'
SLOPE 34:1

EL. 629'
EL. 625'
EL. 629'
EL. 630'
EL. 629'
EL. 630'

(E3) (E2) (F1) (E1) (A7) (A6) (A5) (C1) (A4) (A3) (B1) (A2)

AS BUILT
OCT 20 1995

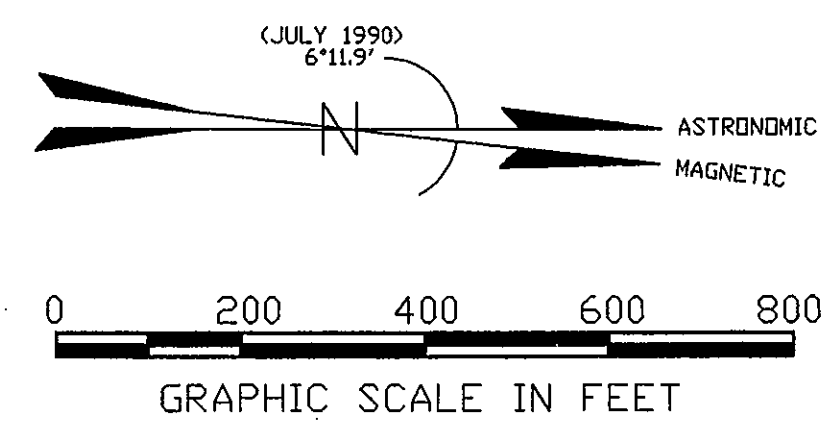

THE SEAL APPEARING ON THIS DOCUMENT WAS AUTHORIZED BY TRACY L. TERRILL, P.E. 70974, ON MAY, 1994.

DESIGN: T.L.T.	A.I.P. NO. 3-48-0063-06	Date
DRAWN: M.J.G.	BID NO. 94-33	Revisions
CHECKED: L.D.T.	JOB NO. Y8024.60	By
SCALE: 1" = 200'		

Greiner, Inc.
Greiner, Inc.
Fort Worth, Texas

Engineers, Architects
and Planners



ADDISON AIRPORT

DRAINAGE AREA MAP