
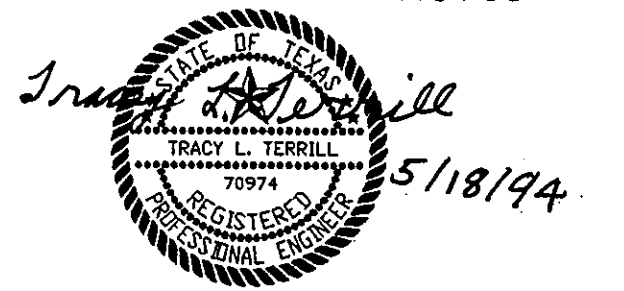
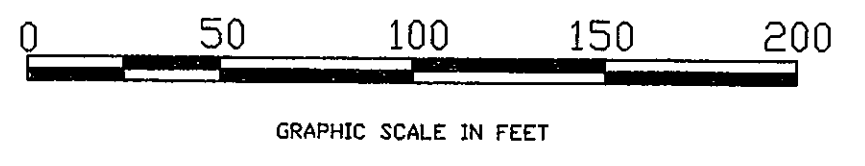


HORIZONTAL CONTROL			
PT. NO.	NORTHING	EASTING	TYPE OF POINT
1	477773.035	2203038.163	1/2" IRON ROD W/CAP
2	478710.418	2202689.863	1/2" IRON ROD W/CAP
3	478588.476	2202361.721	1/2" IRON ROD W/CAP
4	477651.099	2202710.045	1/2" IRON ROD W/CAP
5	477182.308	2202884.220	CUT "X" TOP OF CURB
6	477296.787	2203215.098	CUT "X" TOP OF CURB

CENTERLINE CONTROL FOR SERVICE ROAD			
PT. NO.	NORTHING	EASTING	STA. & OFFSET FROM BASELINE OF SURVEY
10	477809.9127	2202430.5333	"B" STA. 102+46.32, 206.69 LT.
11	477674.2987	2202481.8936	"B" STA. 101+01.31, 205.78 LT.
12	477357.9703	2202630.6350	"B" STA. 97+52.97, 176.53 LT.
13	477224.9155	2202775.8732	"B" STA. 95+77.66, 86.72 LT.
14	477220.8988	2202958.3007	"B" STA. 95+10.36, 82.88 RT.
15	477348.2860	2203263.4475	"A" STA. 95+23.39, 63.26 RT.
16	477621.5730	2203382.1513	"A" STA. 97+38.23, 269.71 RT.
17	478544.3370	2203039.2840	"A" STA. 107+22.62, 269.70 RT.

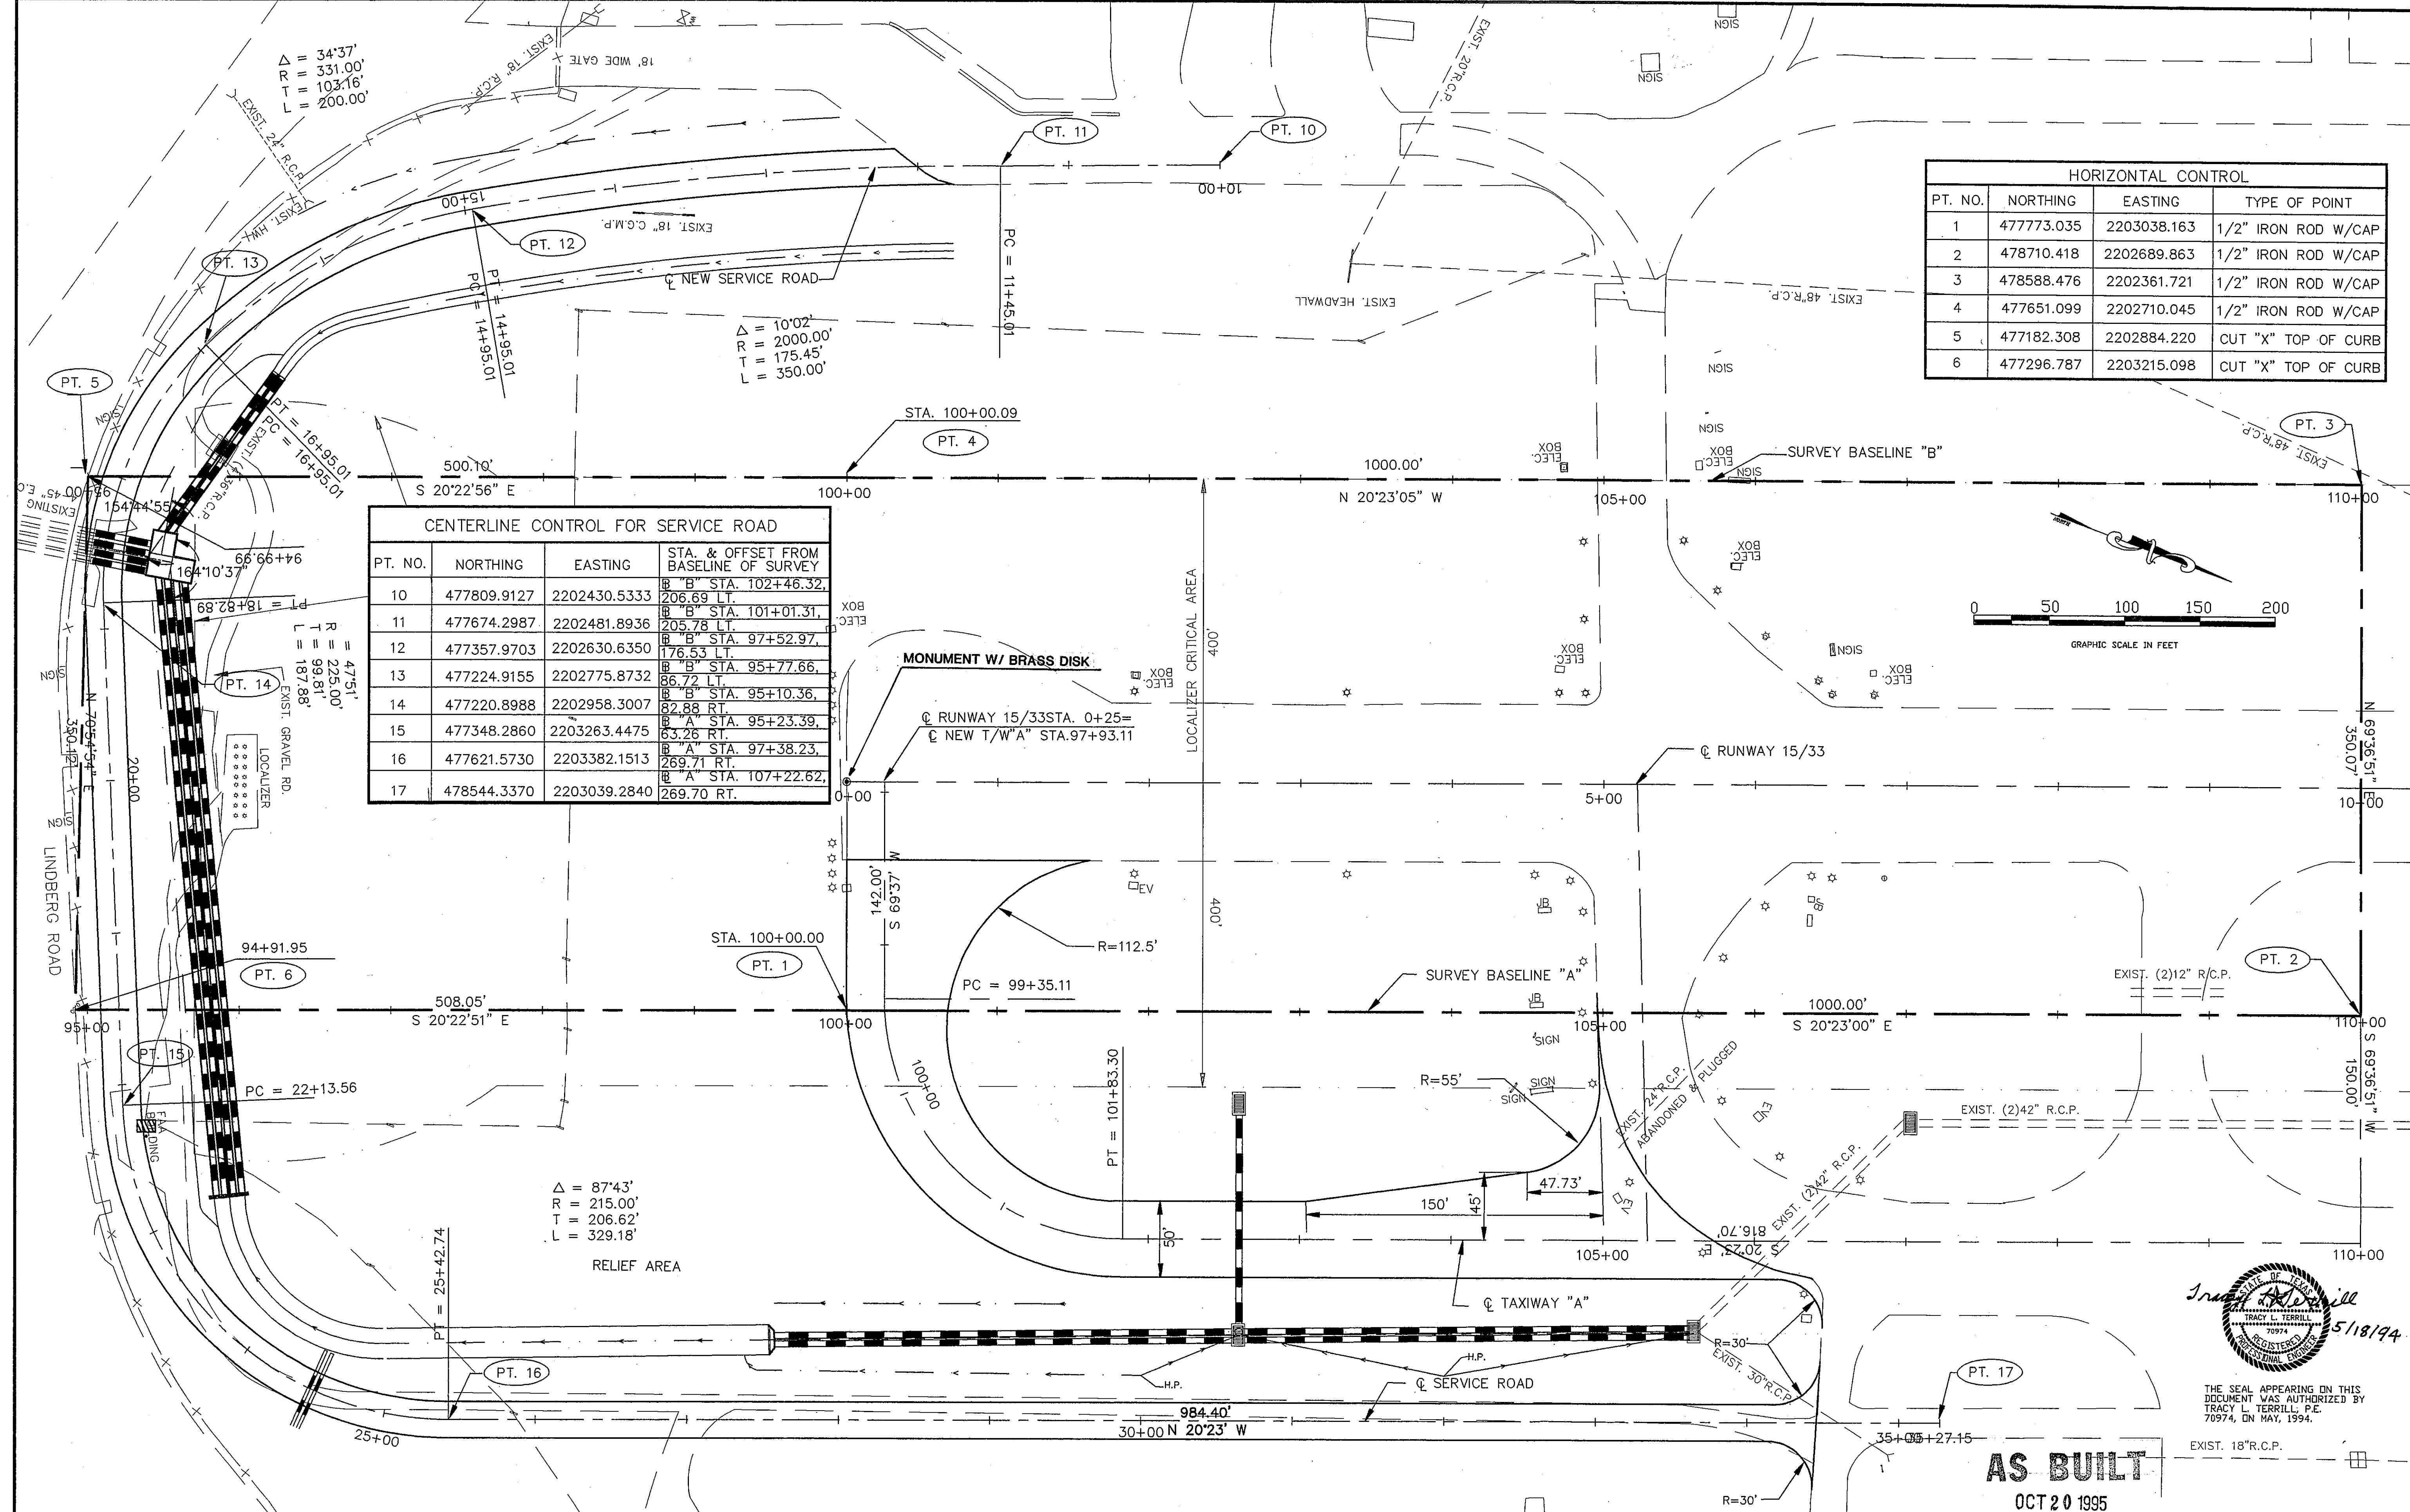


THE SEAL APPEARING ON THIS DOCUMENT WAS AUTHORIZED BY TRACY L. TERRILL, P.E. 70974, ON MAY, 1994.

AS BUILT
OCT 20 1995

DESIGN: T.L.T.	A.L.P. NO: 3-48-0063-06	Date	Revisions	By
DRAWN: M.J.C.	BID NO: 94-33			
CHECKED: L.D.T.	JOB NO: Y8024.60			
SCALE: 1"=50'				

Greiner, Inc.
Greiner, Inc.
Fort Worth, Texas

Engineers, Architects
and Planners

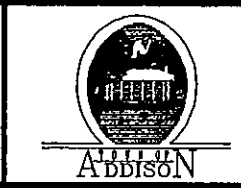

ADDISON AIRPORT

HORIZONTAL CONTROL LAYOUT

SHEET
9
DATE: MAY, 1994