




SOUTH SERVICE ROAD TYPICAL SECTION
N.T.S.

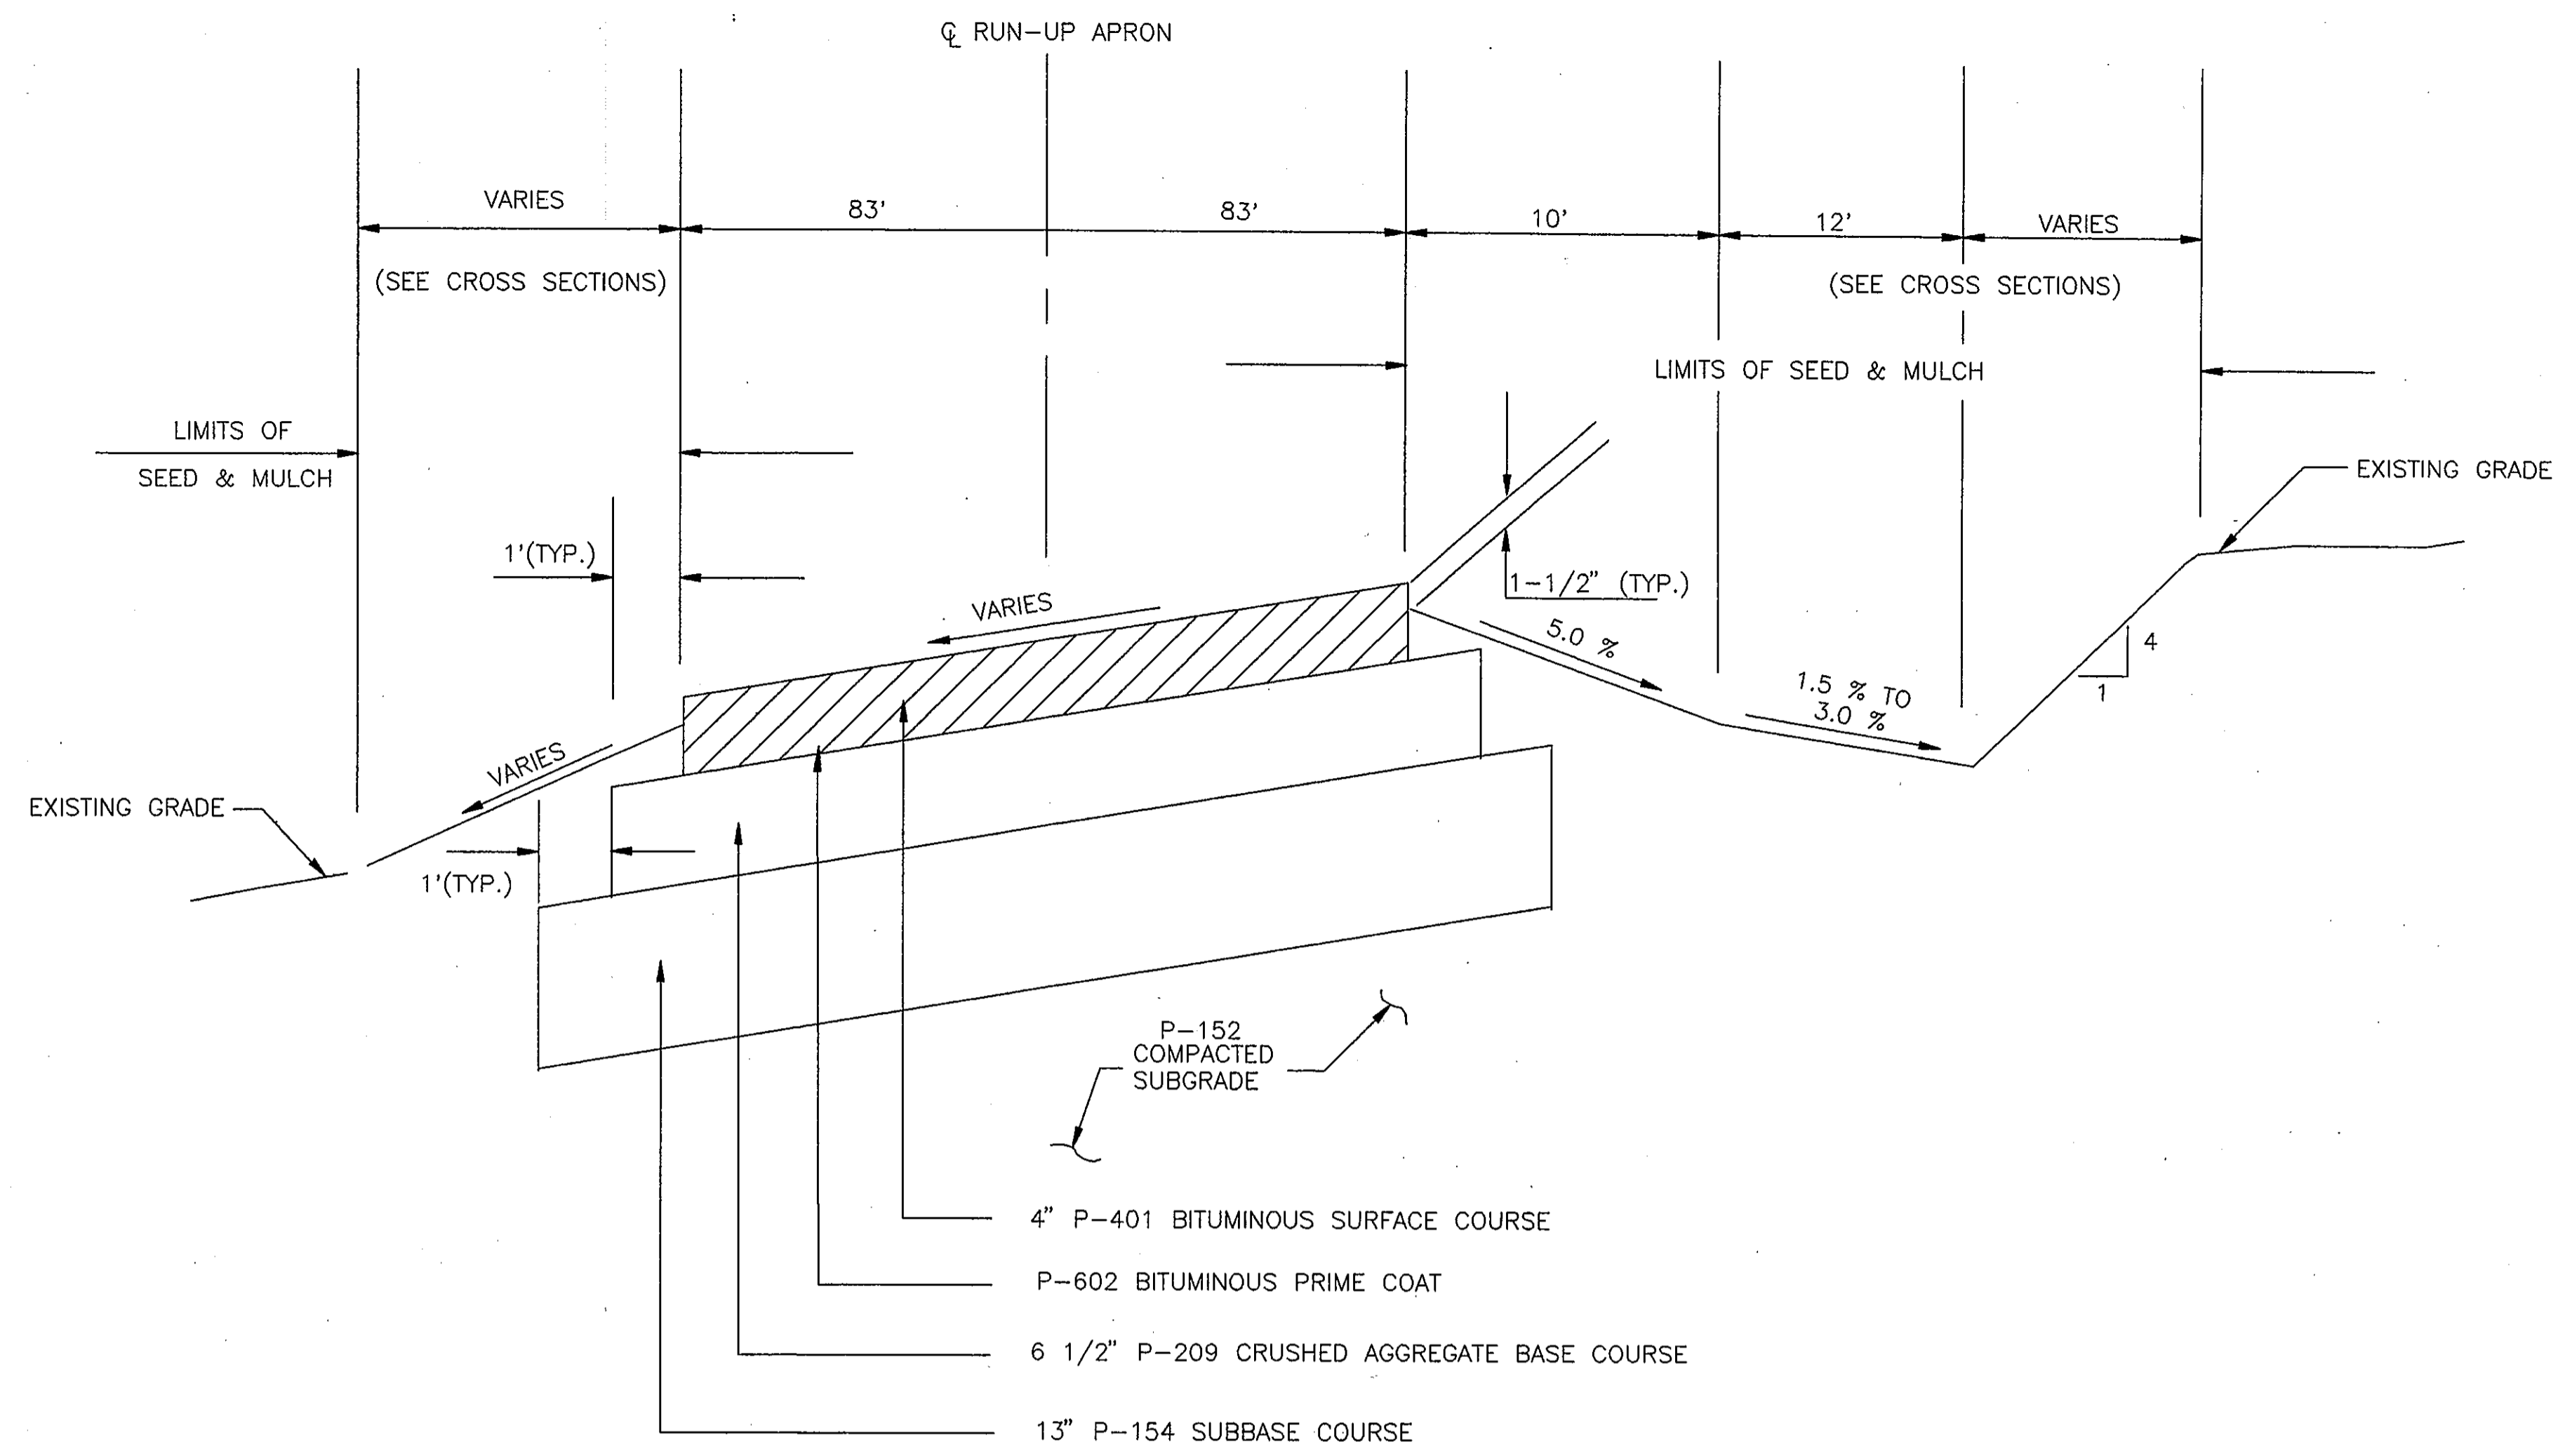

RUN-UP APRON TYPICAL SECTION
N.T.S.

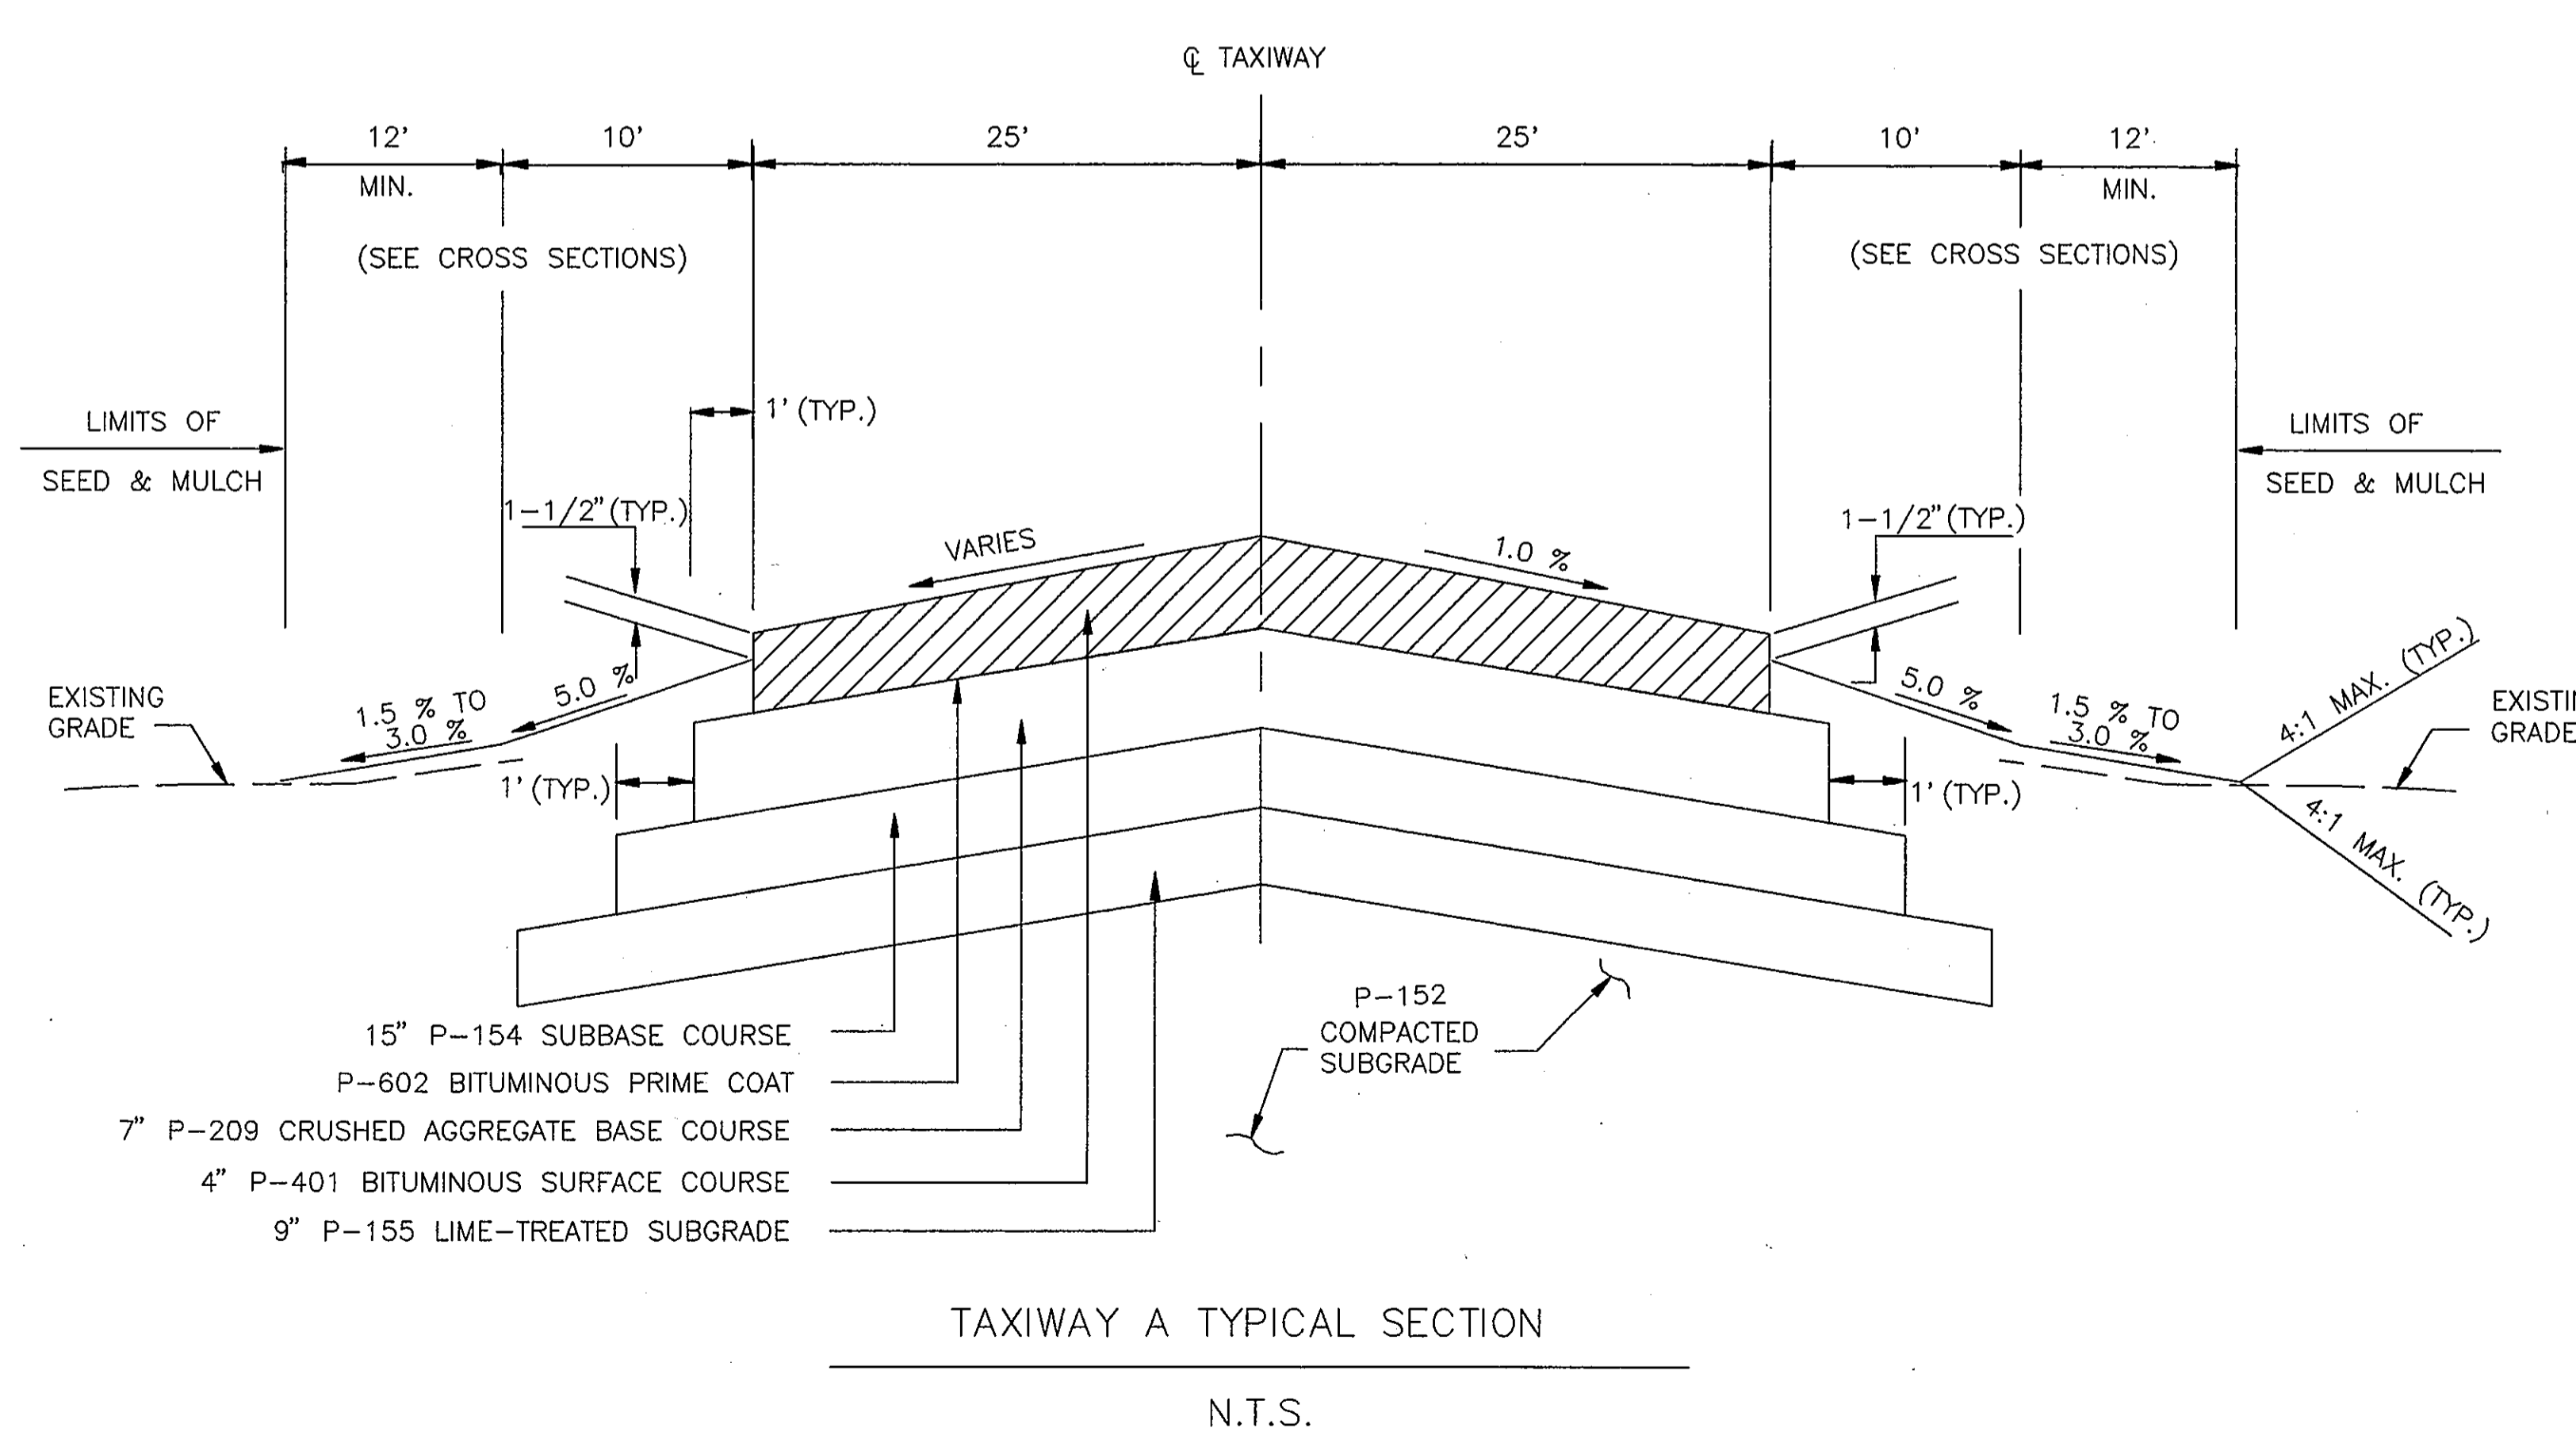

TAXIWAY A TYPICAL SECTION
N.T.S.

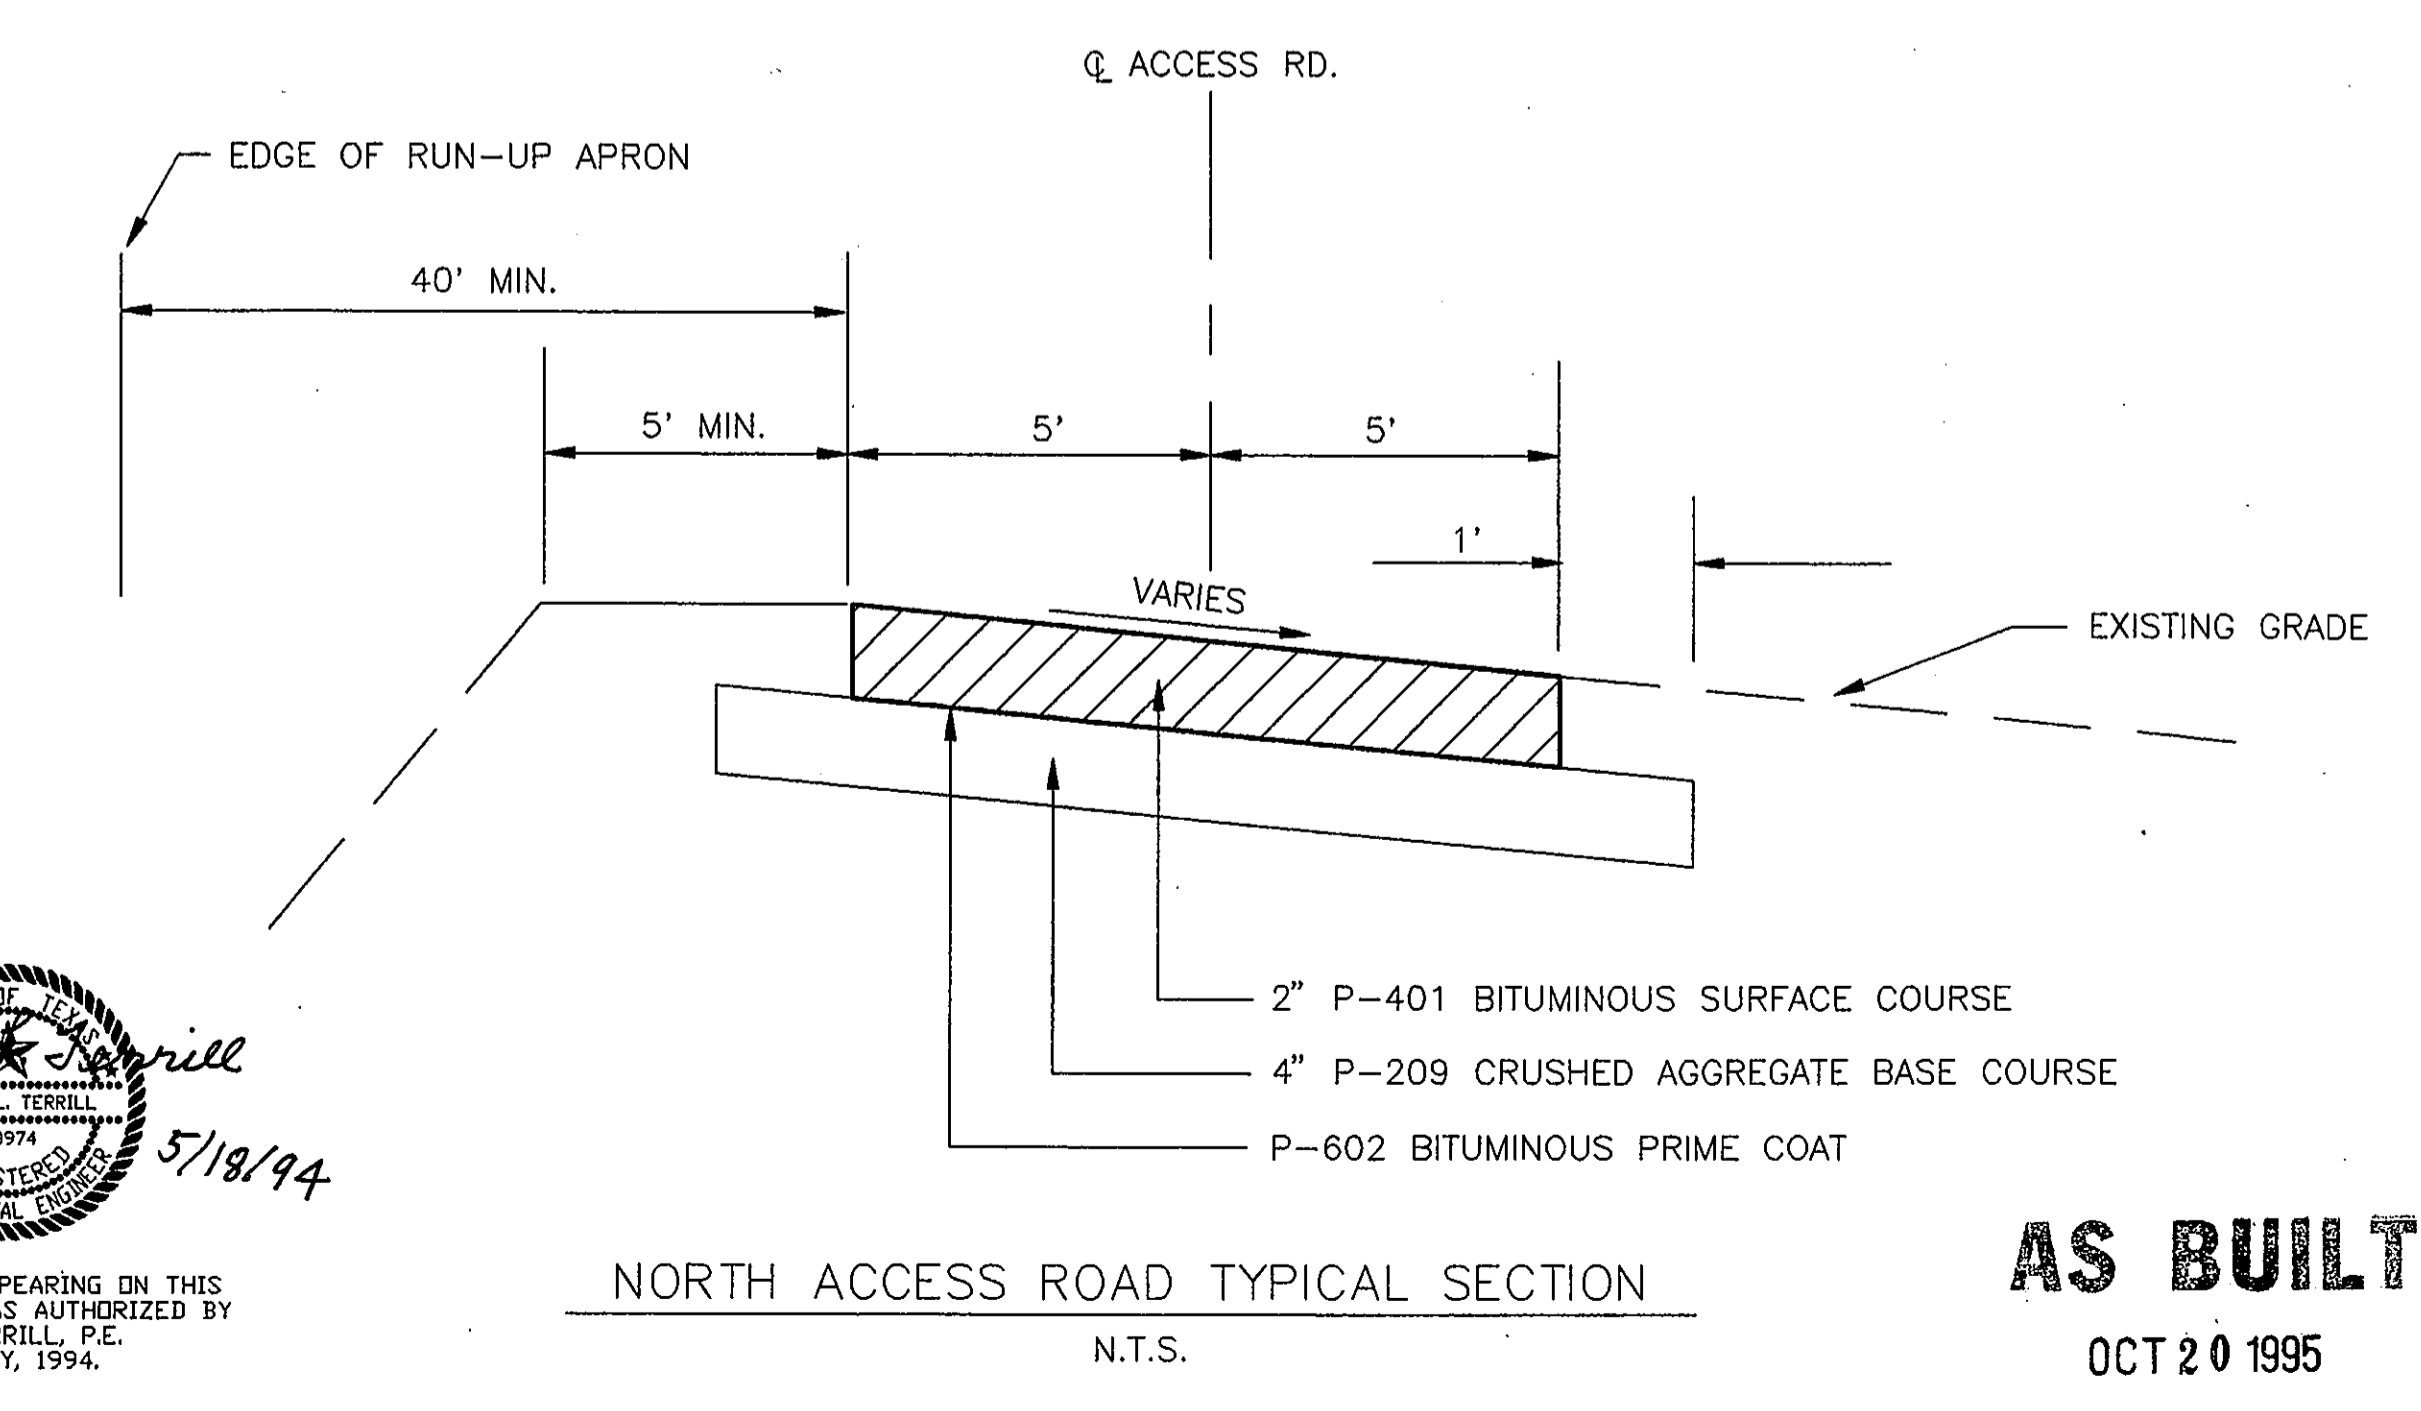

NORTH ACCESS ROAD TYPICAL SECTION
N.T.S.



THE SEAL APPEARING ON THIS DOCUMENT WAS AUTHORIZED BY TRACY L. TERRILL, P.E. 70974, IN MAY, 1994.

AS BUILT
OCT 20 1995

DESIGN: T.L.T.	A.I.P. NO. 3-48-0063-06	Date
DRAWN: J.R.H.	BID NO. 94-33	Revisions
CHECKED: L.D.T.	JOB NO. 18024.60	By
SCALE: AS NOTED		

Greiner, Inc.
Greiner, Inc.
Fort Worth, Texas

Engineers, Architects
and Planners



ADDISON AIRPORT

TYPICAL SECTIONS

SHEET 6

DATE: MAY, 1994