


- GENERAL NOTES
1. THE BEAMS AND WALLS ADJACENT TO GRATES SHALL BE MODIFIED AS SHOWN.
 2. THE GRATES SHALL BE INCLUDED IN THE PRICE FOR THE JUNCTION BOX.
 3. ANCHOR BOLTS FOR THE GRATE MOUNTING ARE SET BACK FARTHER FROM THE EDGE OF CONCRETE THAN STANDARD DETAIL. CONTRACTOR SHALL EXERCISE CARE TO PLACE ANCHOR BOLTS IN THE PROPER POSITION.

AS BUILT
OCT 20 1995

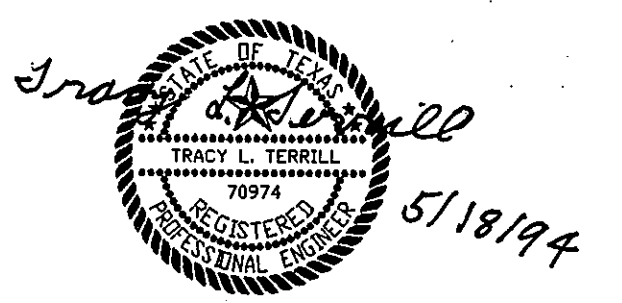

THE SEAL APPEARING IN THIS DOCUMENT WAS AUTHORIZED BY TRACY L. TERRILL, P.E. 70974, IN MAY, 1994.

DESIGN: T.L.T.	A.L.P. NO. 3-48-0063-06	Date	Revisions	By
DRAWN: M.J.G.	BID NO. 94-33			
CHECKED: L.D.T.	JOB NO. Y2024.60			
SCALE: NOT TO SCALE				

Greiner, Inc.
Greiner, Inc.
Fort Worth, Texas

Engineers, Architects
and Planners



ADDISON AIRPORT

GRATE DETAILS FOR JUNCTION BOX

SHEET
22

DATE: MAY, 1994