


AS BUILT
OCT 20 1995

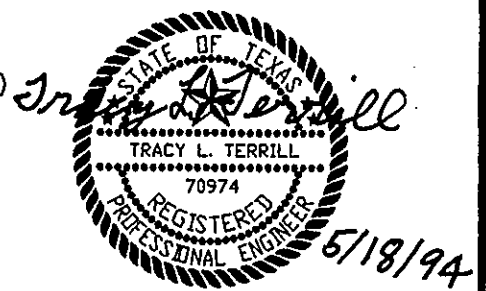


THE SEAL APPEARING ON THIS DOCUMENT WAS AUTHORIZED BY TRACY L. TERRILL, P.E. 70974, ON MAY, 1994.

DESIGN: <u>T.L.T.</u>	A.I.P. NO: <u>3-48-0063-06</u>	Date	Revisions	By
DRAWN: <u>M.J.C.</u>	BID NO: <u>94-33</u>			
CHECKED: <u>L.D.T.</u>	JOB NO: <u>Y8024.60</u>			
SCALE: 1"=50' HORIZ. 1"=2' VERT.				

Greiner, Inc.
Greiner, Inc.
Fort Worth, Texas

Engineers, Architects
and Planners

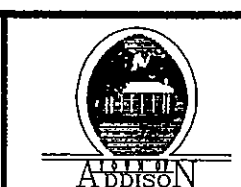

ADDISON AIRPORT

TAXIWAY "A" AND DRAINAGE SECTIONS
STA. 98+43.11 TO STA. 103+04.10