


**AS BUILT**

OCT 20 1995

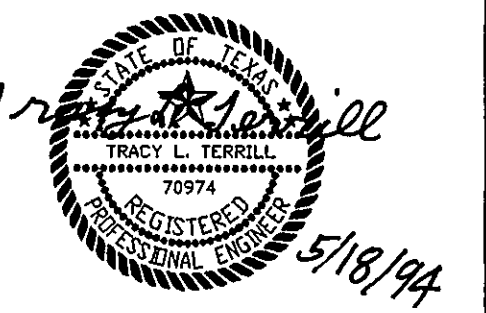

THE SEAL APPEARING ON THIS DOCUMENT WAS AUTHORIZED BY TRACY L. TERRILL, P.E. 70974, ON MAY, 1994.

DESIGN: T.L.T.	A.L.P. NO. 3-48-0063-06	Date
DRAWN: M.J.G.	BID NO. 94-33	Revisions
CHECKED: L.D.T.	JOB NO. Y8024.80	By
SCALE: 1"=50' HORIZ. 1"=2' VERT.		

**Greiner, Inc.**  
Greiner, Inc.  
Fort Worth, Texas

Engineers, Architects  
and Planners



**ADDISON AIRPORT**

TAXIWAY "A" AND DRAINAGE SECTIONS  
STA. 103+50 TO STA. 106+50