


AS BUILT

OCT 20 1995

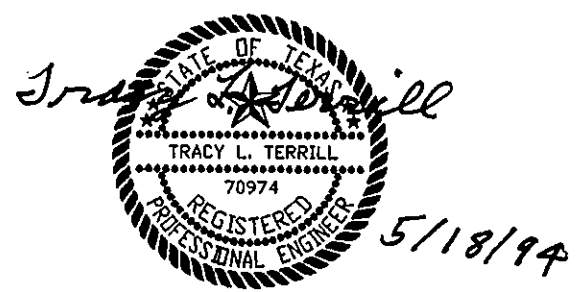

THE SEAL APPEARING ON THIS DOCUMENT WAS AUTHORIZED BY TRACY L. TERRILL, P.E. 70974, DN MAY, 1994.

DESIGN: T.L.T.	A.I.P. NO. 3-48-0063-06	Date	Revisions	By
DRAWN: M.J.C.	BID NO. 94-33			
CHECKED: L.D.T.	JOB NO. Y8024.60			
SCALE: 1"=50' HORIZ. 1"=2' VERT.				

Greiner, Inc.
Greiner, Inc.
Fort Worth, Texas
Engineers, Architects
and Planners



ADDISON AIRPORT

TAXIWAY "C" PROFILE AND SECTIONS
STA. 2+50 TO STA. 3+50

SHEET
41
DATE: MAY, 1994