


**AS BUILT**  
OCT 20 1995

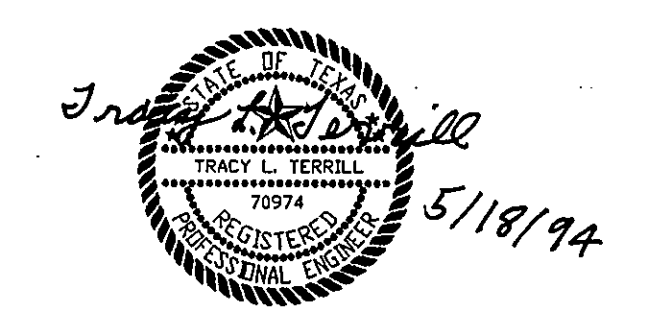


THE SEAL APPEARING ON THIS DOCUMENT WAS AUTHORIZED BY TRACY L. TERRILL, P.E. 70974, DN MAY, 1994.

DESIGN: T.L.T.	A.I.P. NO. 3-48-0063-06	Date	Revisions	By
DRAWN: M.J.C.	BID NO. 94-33			
CHECKED: L.D.T.	JOB NO. Y8024.60			
SCALE: 1" = 50' HORIZ. 1" = 2' VERT.				

**Greiner, Inc.**  
Greiner, Inc.  
Fort Worth, Texas

Engineers, Architects  
and Planners

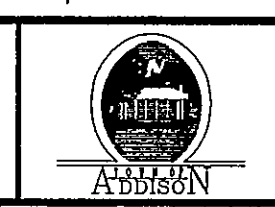

# ADDISON AIRPORT

SERVICE ROAD AND DRAINAGE SECTIONS  
STA. 32+00 TO STA. 34+45.67