


**SW3P LEGEND**


—#— SILT FENCE

////// COMPOST MULCH SOCK

**NOTE:**  
1. CONTRACTOR IS RESPONSIBLE FOR UTILITY LOCATION PRIOR TO CONSTRUCTION.

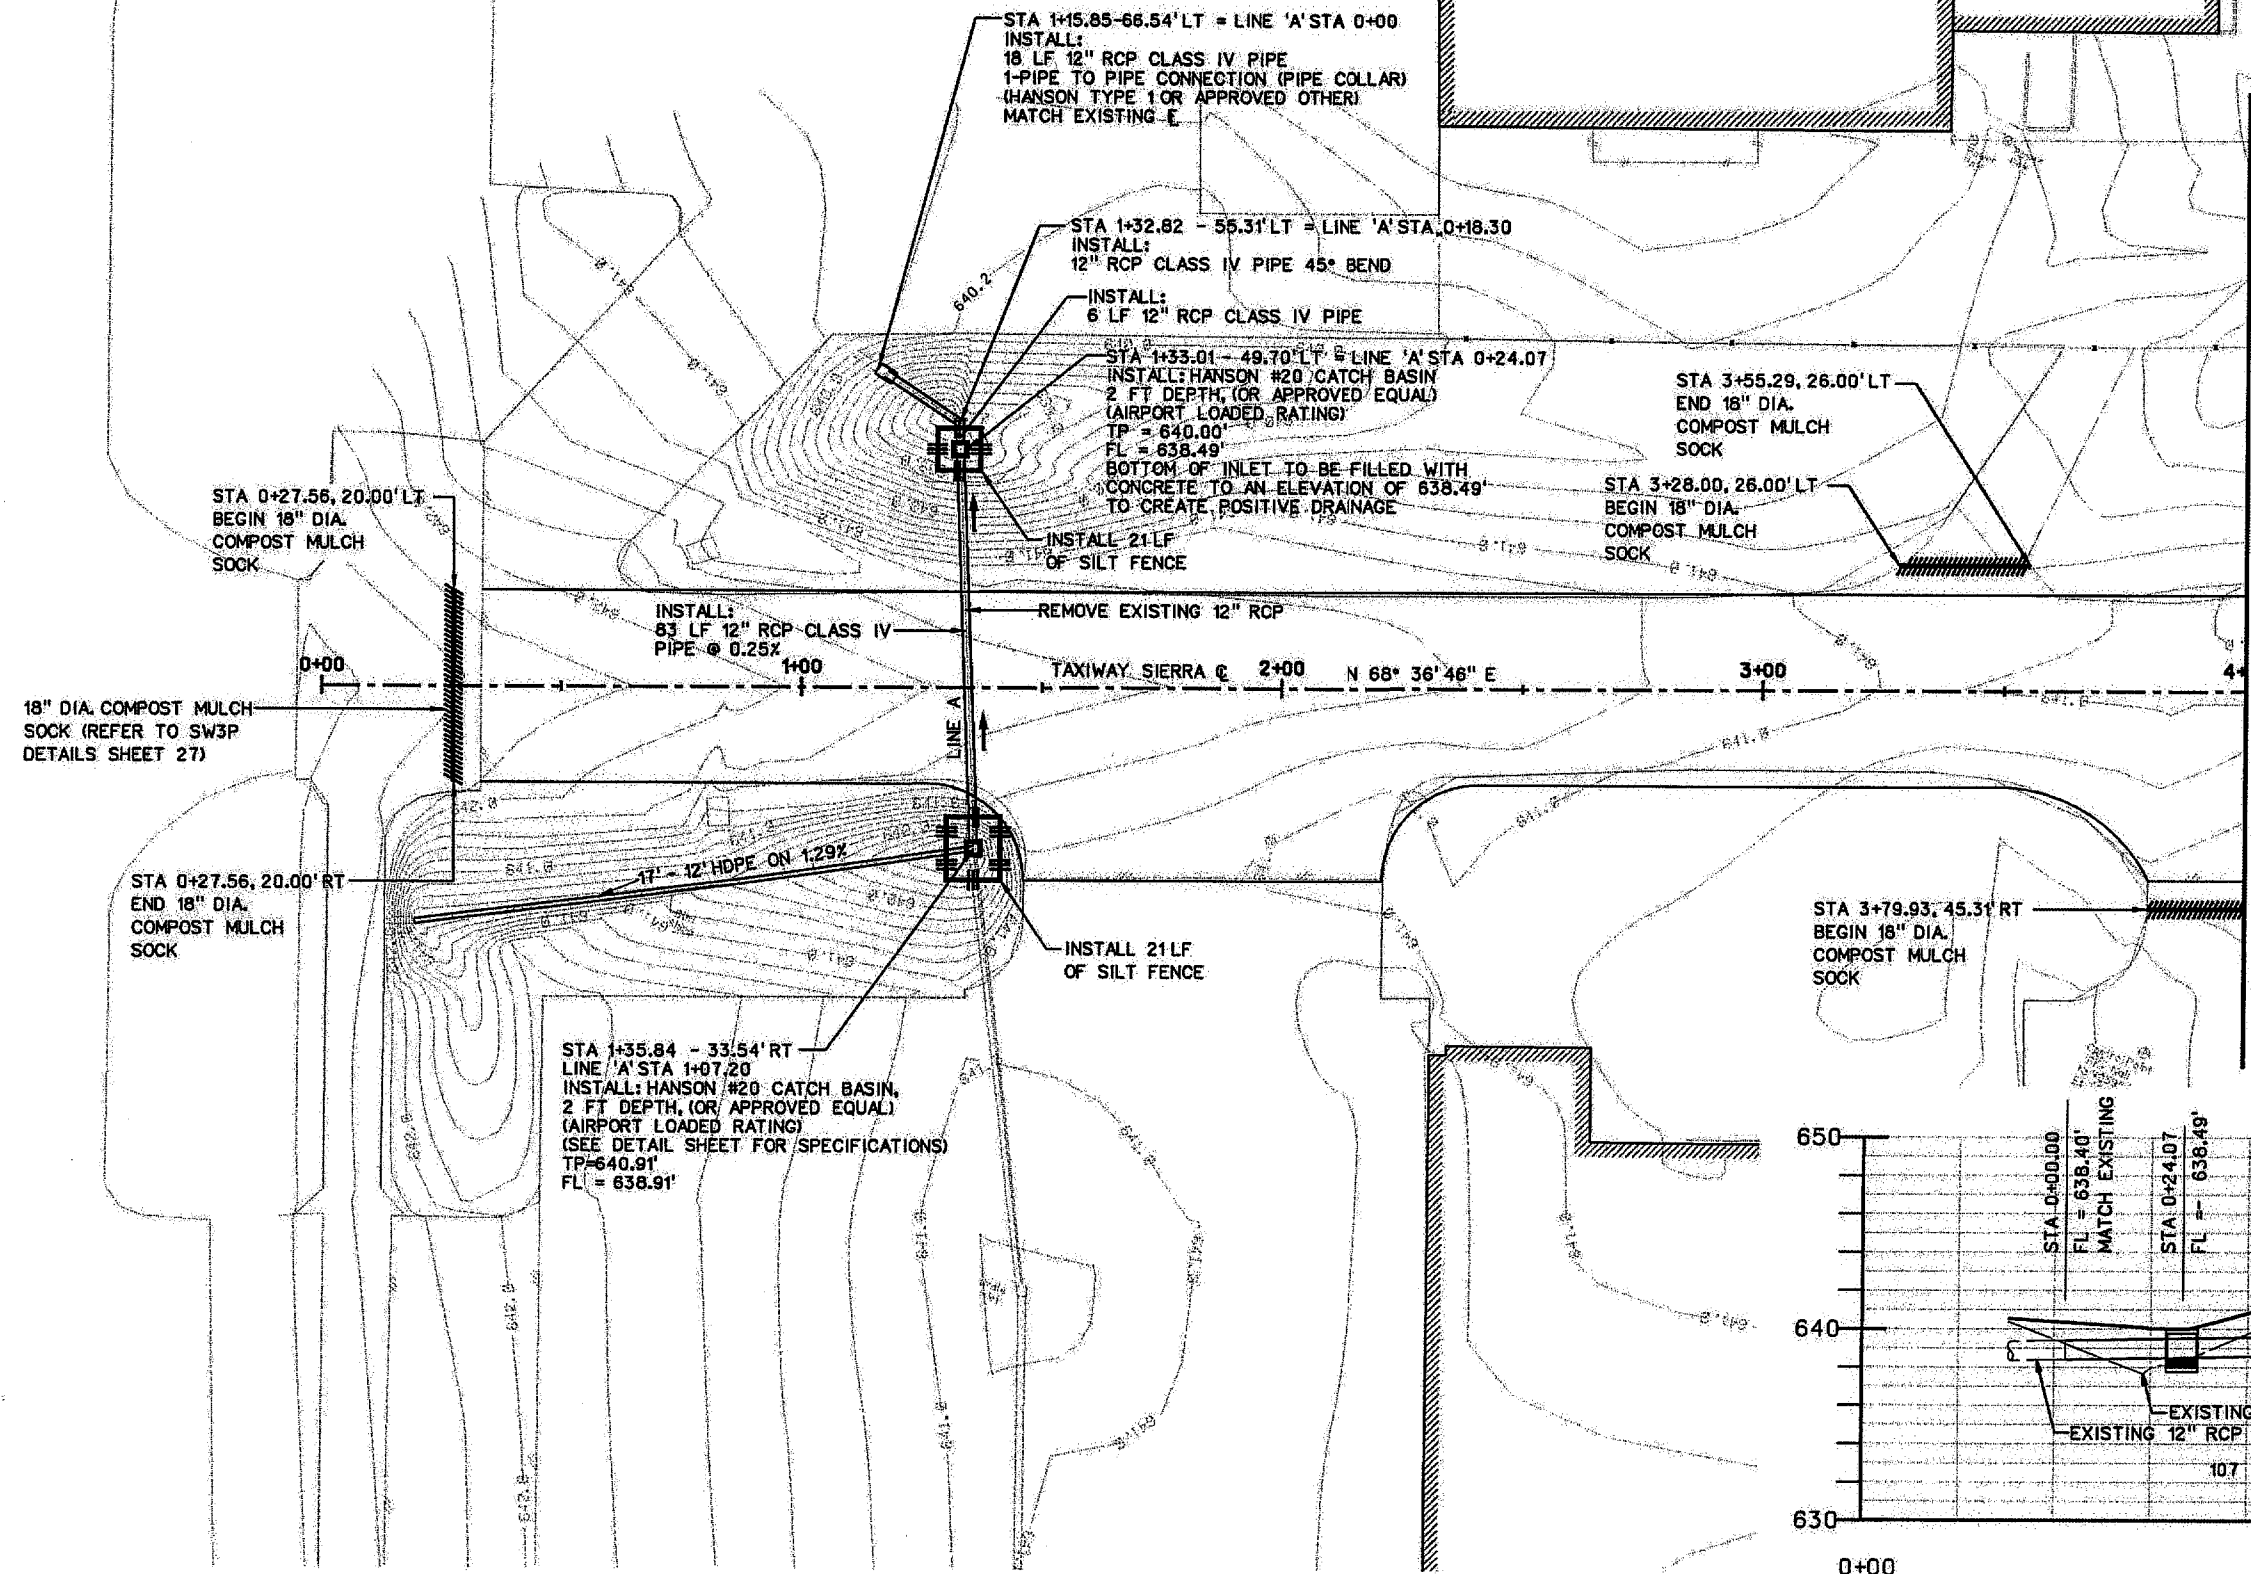

# AS BUILT PLANS

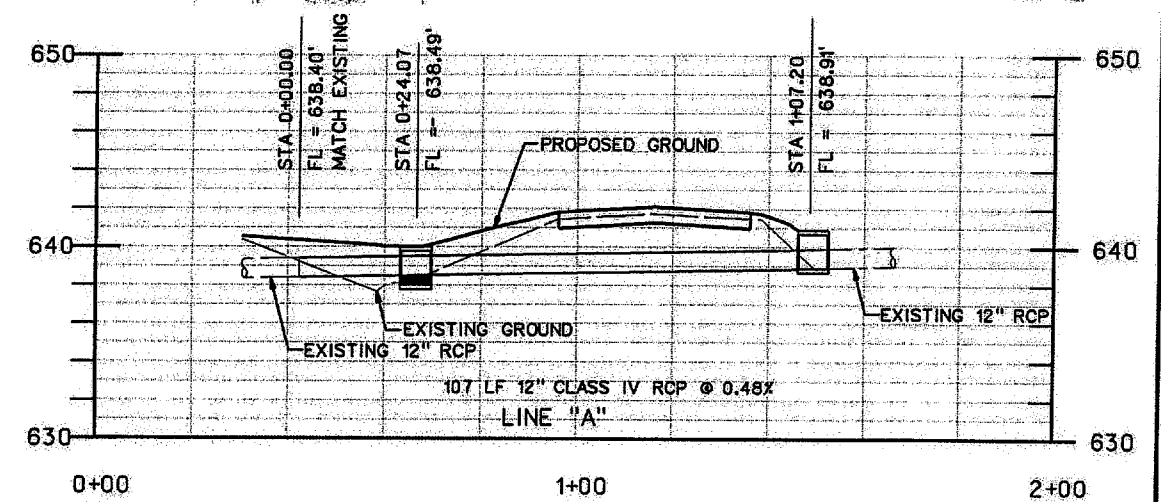

13-JUN-2008 10:53  
G:\15601\Cad\Sheets\TWS\dp01.dgn

NO.	DATE	REVISION	APPROV.	NO.	DATE	REVISION	APPROV.

THE SEAL APPEARING ON THIS DOCUMENT WAS AUTHORIZED BY J.S. NICEVANDER, P.E. 67843 ON OCTOBER 26, 2007.



**HNTB**  
HNTB Corporation  
The HNTB Companies  
Engineers Architects Planners

DESIGN: JSN  
CHECK: MMH  
DRAWN: CCH  
DATE: SEPTEMBER 2007  
SCALE:

PROJECT NO. 45601



TOWN OF ADDISON TAXIWAY SIERRA	SHEET 18 OF 28
DRAINAGE AND SW3P PLAN	18
TOWN OF ADDISON, TEXAS	DP-1