



NOTE:
TYPICALLY USED WHERE THE LIMIT OF CONSTRUCTION IS ADJACENT TO THE EDGE OF PAVEMENT OF AN ACTIVE TAXIWAY OR TAXILANE.

LOW-PROFILE WATER FILLED PLASTIC BARRICADE
N.T.S.

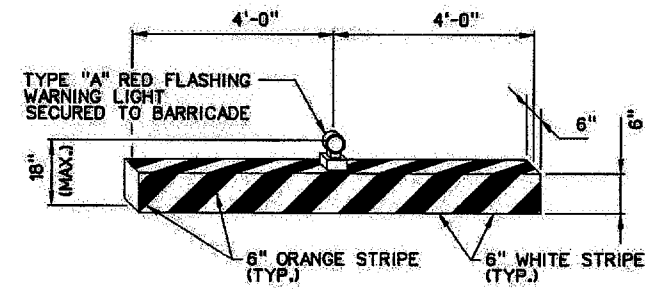

NOTE: BARRICADES SHALL BE PLACED CONTINUOUSLY, END TO END.

BARRIER DETAIL
N.T.S.

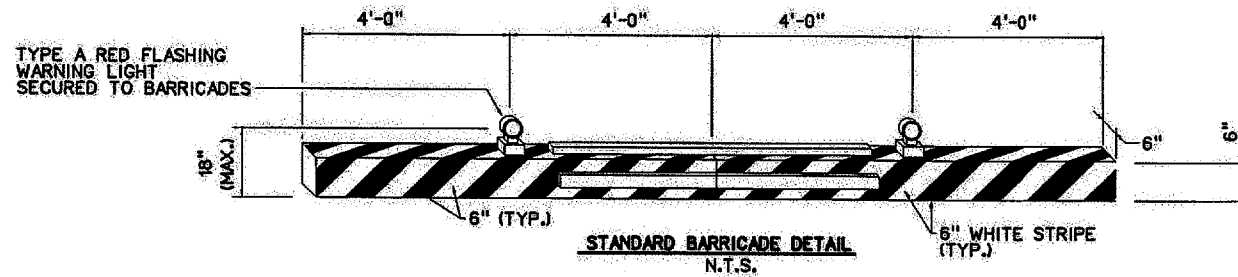

NOTE:
BARRICADES SHALL BE PLACED CONTINUOUSLY, END TO END AND CONNECTED WITH "2X4" STRAPS ON THE TOP AND BOTH SIDES.

STANDARD BARRICADE DETAIL
N.T.S.

LOW LEVEL LIGHTED BARRICADE NOTES:

1. PLACEMENT AND MAINTENANCE OF BARRICADES SHALL BE CONSIDERED SUBSIDIARY TO ITEM TS-005 "MAINTENANCE OF TRAFFIC".
2. SUFFICIENT SANDBAGS SHALL BE PLACED ON EACH SUPPORT BRACE TO KEEP BARRICADE IN PLACE AT ALL TIMES.
3. CONTRACTOR SHALL DISPOSE OF SANDBAGS OFF-SITE UPON COMPLETION OF CONSTRUCTION.
4. BARRICADES SHALL BE PLACED AT 10' INTERVALS ALONG OPERATIONAL PAVEMENT ADJACENT TO CONSTRUCTION OR AS DIRECTED BY THE ENGINEER.
5. CONTRACTOR SHALL BE RESPONSIBLE FOR REMOVING BARRICADES UPON COMPLETION OF CONSTRUCTION OPERATIONS.
6. THE CONTRACTOR SHALL PROVIDE CONTINUOUS MAINTENANCE FOR ALL TEMPORARY MARKING AND BARRICADES NECESSARY FOR THE PROGRESS OF THE WORK, AT NO ADDITIONAL COST TO THE OWNER.
7. BARRICADES SHALL BE COVERED WITH REFLECTIVE SHEETING OR OTHER MATERIAL AS DIRECTED BY THE ENGINEER.
8. BARRICADES SHALL CONFORM TO FAA AC 150/5370-2E

AS BUILT PLANS

13-JUN-2008 10:54
G:\45601\cod\Sheet\ts\ts.dgn

NO.	DATE	REVISION	APPROV.	NO.	DATE	REVISION	APPROV.

THE SEAL APPEARING ON THIS DOCUMENT WAS AUTHORIZED BY J.S. NICEWANDER, P.E. 87843 ON OCTOBER 26, 2007.



HNTB		HNTB Corporation The HNTB Companies Engineers Architects Planners	
DESIGN CHECK	JSN MAH	PROJECT NO.	45601
DRAWN CHECK	CCH MAH		
DATE	SEPTEMBER 2007		
SCALE			



TOWN OF ADDISON		SHEET 22 OF 28
TAXIWAY SIERRA		
BARRICADE DETAILS		22
TOWN OF ADDISON, TEXAS		DT-1