
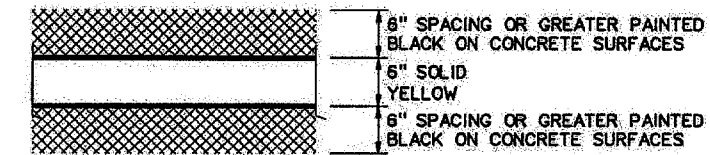


**NON-MOVEMENT AREA MARKINGS**  
N.T.S.

**NON-MOVEMENT AREA MARKINGS NOTES:**

IN ORDER TO INCREASE THE VISIBILITY OF MARKINGS AT AIRPORTS THE CONTRAST OF A MARKING ON CONCRETE PAVEMENT SURFACES AND LIGHT COLORED PAVEMENTS CAN BE INCREASED BY OUTLINING ALL EDGES OF THE MARKING WITH A BLACK BORDER THAT IS 6 INCHES OR GREATER IN WIDTH.

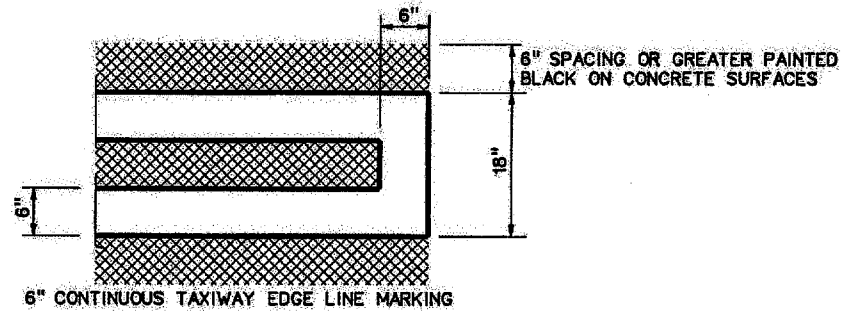


**STRIPING**  
N.T.S.

**STRIPING NOTES:**

ALL STRIPING SHALL HAVE TYPE I STRIPING MEDIA.

REFER TO ITEM 666 OF TEXAS STANDARD SPECIFICATIONS (2004)

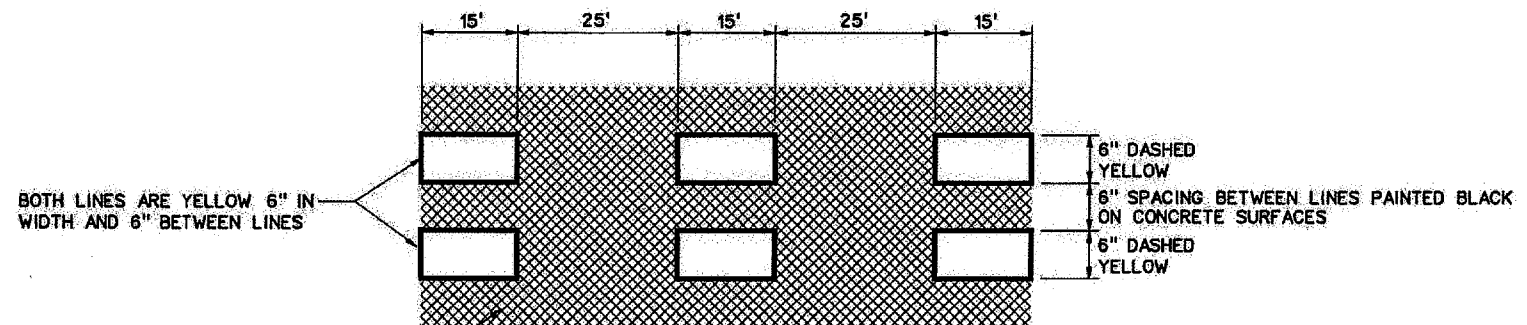

**DASHED TAXIWAY EDGE LINE MARKINGS**  
N.T.S.

**DASHED TAXIWAY EDGE LINE MARKINGS NOTES:**

SEE NON-MOVEMENT AREA MARKINGS NOTES ABOVE

**AS BUILT PLANS**

**NOTE:**

THE CONTRACTOR SHALL PROVIDE CONTINUOUS MAINTENANCE FOR ALL TEMPORARY MARKINGS NECESSARY FOR THE PROGRESS OF THE WORK, AT NO ADDITIONAL COST TO THE OWNER.

13-JUN-2008 10:54  
G:\45601\Cad\Sheets\Twsif05.dgn

NO.	DATE	REVISION	APPROV.	NO.	DATE	REVISION	APPROV.

THE SEAL APPEARING ON THIS DOCUMENT WAS AUTHORIZED BY J.S. NICEWARDER, P.E. 87843 ON OCTOBER 26, 2007.



<b>HNTB</b>		HNTB Corporation The HNTB Companies Engineers, Architects, Planners	
DESIGN CHECK	JSN MAH	PROJECT NO.	45601
DRAWN CHECK	CCH MAH		
DATE	SEPTEMBER 2007		
SCALE			



TOWN OF ADDISON		SHEET 26 OF 28
TAXIWAY SIERRA		
PAVEMENT MARKING DETAILS		26
TOWN OF ADDISON, TEXAS		DT-5