



**INDEX OF DRAWINGS**

- 1 TITLE SHEET
- 2 AIRPORT LAYOUT PLAN
- 3-4 SUMMARY OF QUANTITIES AND GENERAL CONTRACT NOTES
- 4A SUMMARY OF QUANTITIES - ADDITIVE ALTERNATE NO. 3
- 5 PHASING PLAN
- 6 CONCRETE PAVEMENT TYPICAL SECTIONS
- 7 ASPHALT PAVEMENT TYPICAL SECTIONS
- 8 DRAINAGE AREA MAP
- 9 HORIZONTAL AND VERTICAL CONTROL LAYOUT
- 10 PAVEMENT DEMOLITION PLAN
- 11-13 TAXIWAY "B" PLAN AND PROFILES
- 14 TAXIWAY "C, E & F" PROFILES
- 15-18 GRADING PLANS
- 19 STORM DRAIN PROFILES
- 20 JOINT LAYOUT PLAN
- 21 JOINT DETAILS
- 22 MISCELLANEOUS DETAILS
- 23 HORIZONTAL INLET TYPE H DETAILS
- 24 GRATE TYPE H DETAILS
- 25 MANHOLE TYPE M DETAILS
- 26-27 PAVING DETAILS
- 28-29 BORING LOGS
- 30 UTILITY PLAN
- 31 PAVEMENT MARKING PLAN
- 32 PAVEMENT MARKING DETAILS
- 33-40 ELECTRICAL PLAN
- 41-43 ELECTRICAL PLAN - ADDITIVE ALTERNATE NO. 3/4
- 44-47 TAXIWAY "B" CROSS SECTIONS
- 48-52 CONNECTOR TAXIWAY CROSS SECTIONS

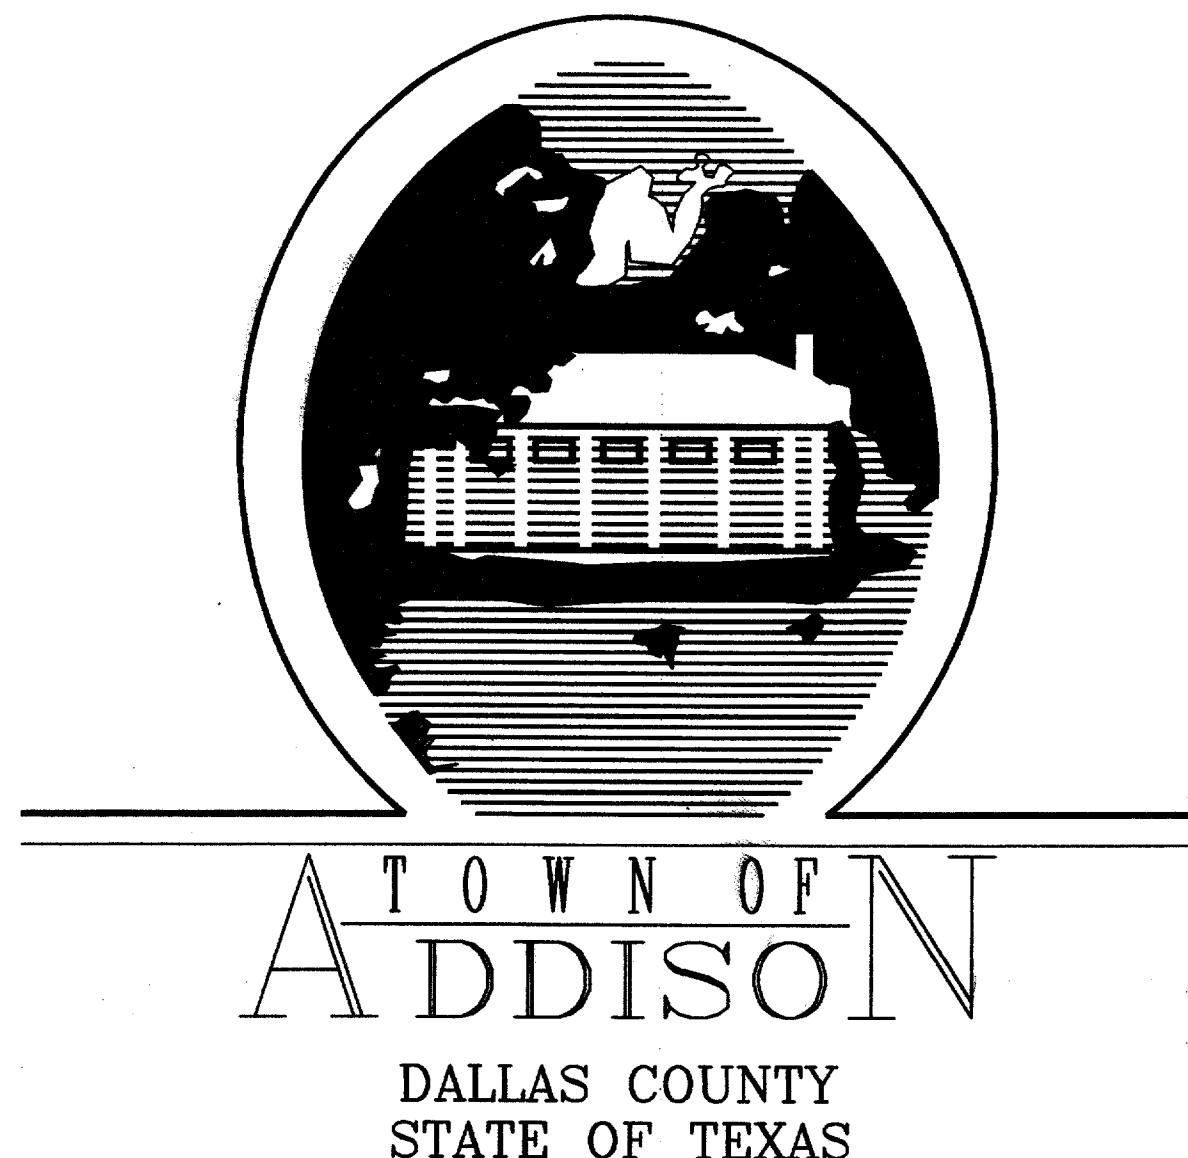


# CONSTRUCT WEST TAXIWAY AND CONNECTORS WITH DRAINAGE IMPROVEMENTS (SOUTH SEGMENT) ADDISON AIRPORT

BID NUMBER: 98-04  
TXDOT PROJECT NO. 9842 ADDSN  
DECEMBER, 1997

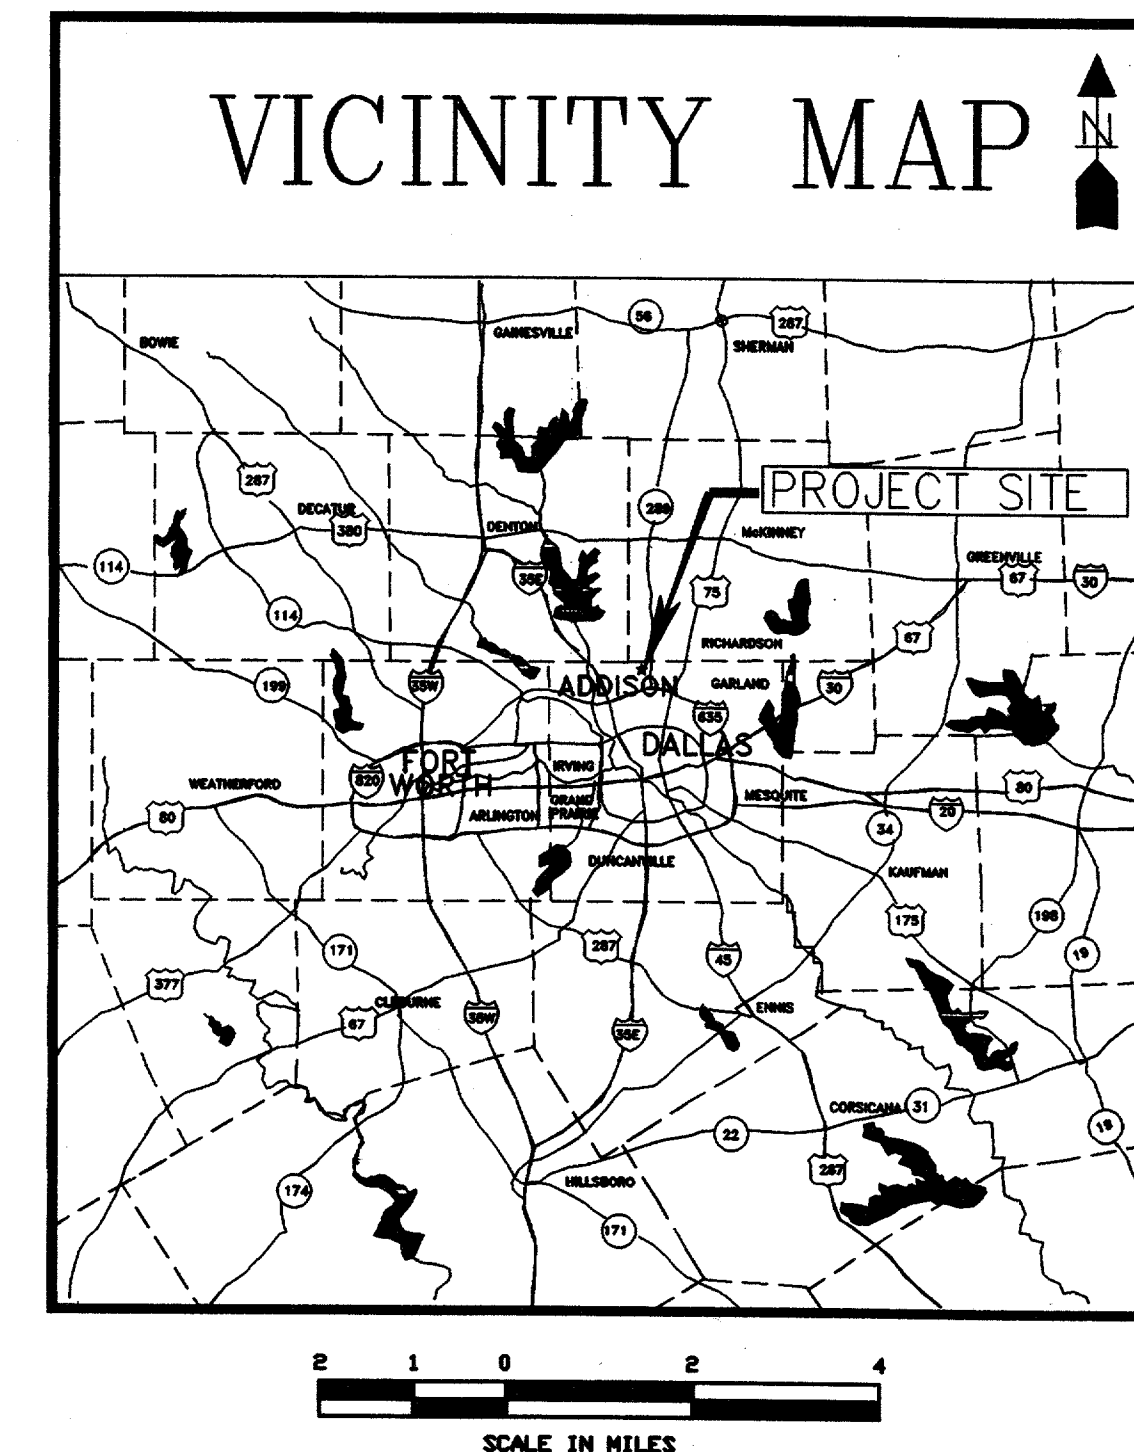

**URS Greiner** IN ASSOCIATION WITH:  
4100 Aron Carter Blvd., Suite 108  
Fort Worth, TX 76155  
(817) 545-0891  
**PSA ENGINEERING, INC.**  
Huntingdon / SWL

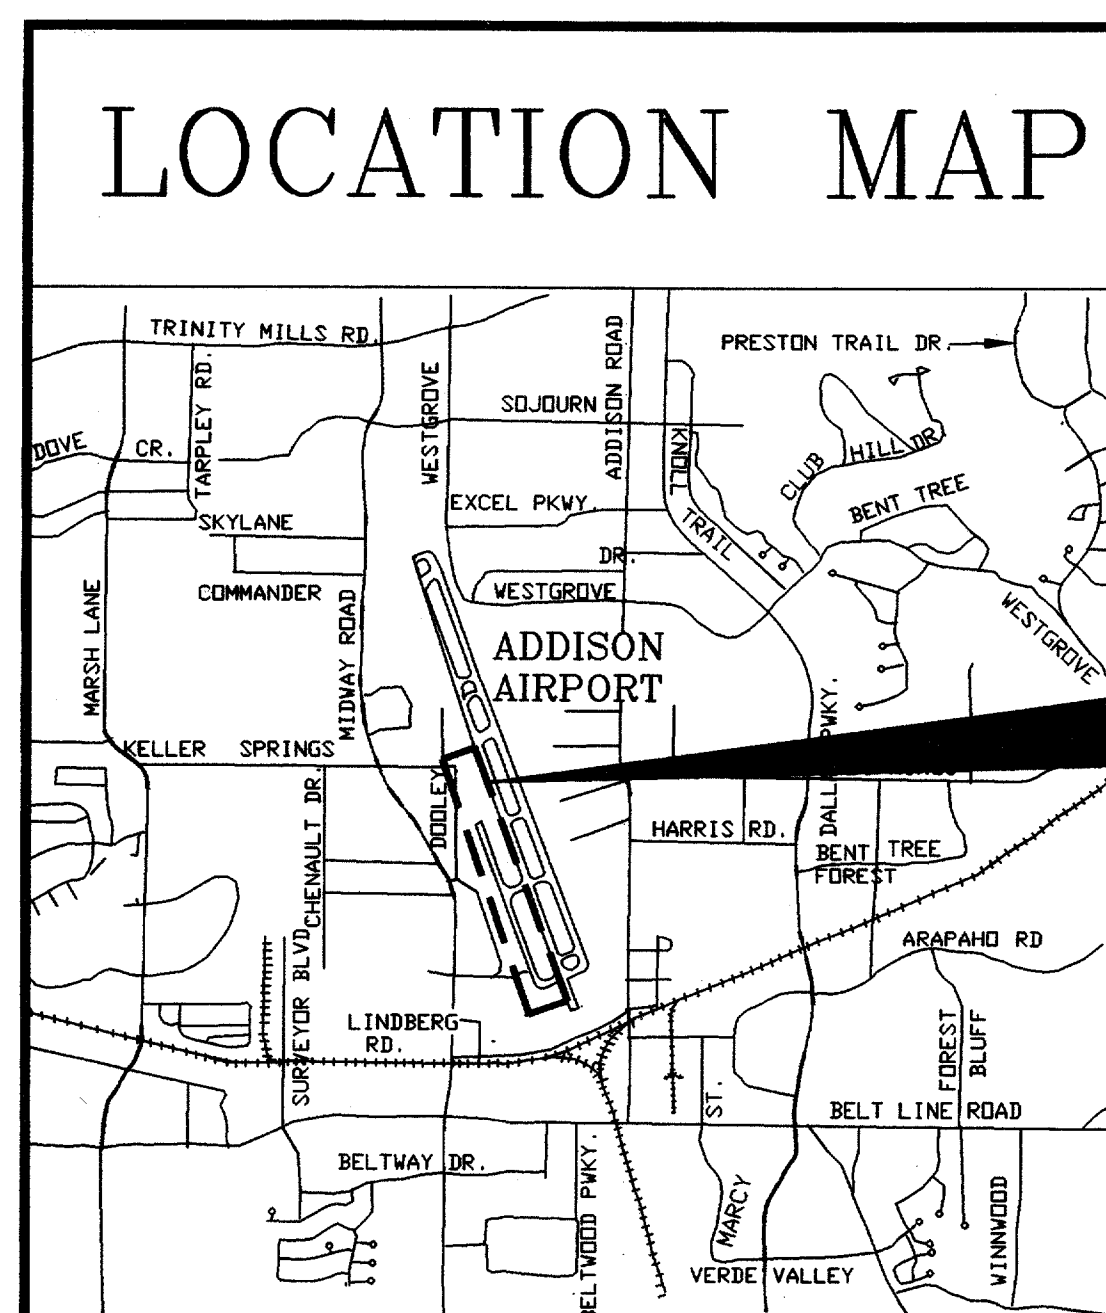

**TYPE OF CONSTRUCTION:**

PAVING, DRAINAGE, SURFACE GRADING,  
LIGHTING (M.I.T.L.), MARKING AND GUIDANCE SIGNS

REVISIONS		
DATE	DESCRIPTION	BY

**PROPOSED IMPROVEMENTS**

**AS BUILT**  
1-11-99

RECOMMENDED FOR APPROVAL Robert J. Sifers  
DESIGN ENGINEER

DATE \_\_\_\_\_

RECOMMENDED FOR APPROVAL Kan E. Griffin  
PROJECT ENGINEER

DATE 12/2/97

APPROVED \_\_\_\_\_  
DIRECTOR OF PUBLIC WORKS

DATE \_\_\_\_\_  
SET \_\_\_\_\_

**FF-16**