


ITEM NUMBER	ITEM DESCRIPTION	UNITS	BID QUANTITY			CHANGE ORDERS	FINAL QUANTITY			REMARKS
			TOTAL	A.I.P.	NON A.I.P.		TOTAL	A.I.P.	NON A.I.P.	
ALTERNATE BID NUMBER 3										
L-108-5.1	L-824C #8, 5kv Cable (Installed in duct)	LF	5,700	5,700			0			
L-108-5.2	#6 AWG Bare Copper / Counterpoise (Installed above duct)	LF	5,000	5,000			4,130			
L-110-5.1	2" PVC One-way Elect. Duct - Type "A"	LF	4,440	4,440			4,921			
L-125-5.1	Remove & Reinstall Existing (MITL) Fixture	EA	10	10			0			
L-125-5.2	L-861T MITL Base Mounted Fixture (Blue)	EA	35	35			0			
ALTERNATE BID NUMBER 4										
L-853-4.1	L-853 Elevated Retroreflective Edge Marker	EA	35	35						

AS BUILT
1-11-99

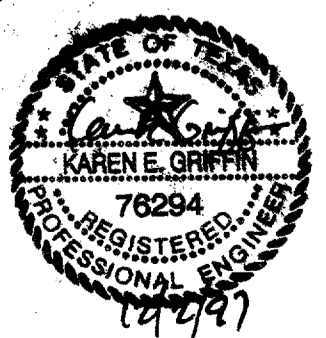

DESIGN: T.L.T.
DRAWN: J.R.H.
CHECKED: R.L.B.
SCALE: N/A

TXDOT NO. 9842 ADDSN
BID NO. 98-04
JOB NO. E700024.80

Date _____ Revisions _____ By _____

URS Greiner
4100 Arnon Carter Blvd, Suite 106
Fort Worth, TX 76155
(817) 545-0891

Engineers, Architects
and Planners



ADDISON AIRPORT

SUMMARY OF QUANTITIES
ADDITIVE ALTERNATE NO. 3

SHEET
4A
DATE: DEC. 1997