


**AS BUILT**  
1-11-99

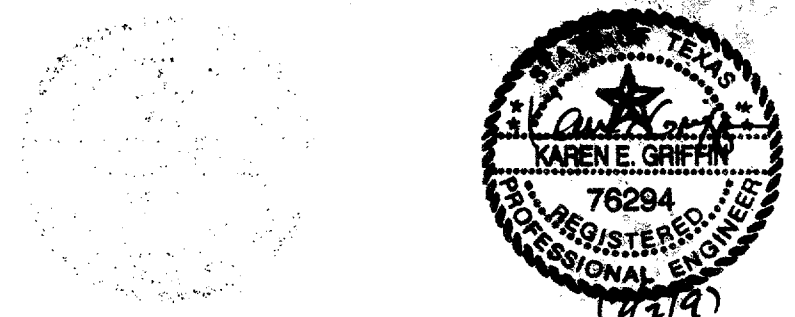


DESIGN: T.L.T.  
DRAWN: J.R.H.  
CHECKED: R.L.B.  
SCALE: AS NOTED

PROJECT NO. 9842 ADDSN  
SHEET NO. 20-04  
JOB NO. E709024.80

Date	Revisions	By

**URS Greiner**  
4100 Aron Carter Blvd., Suite 108  
Fort Worth, TX 76135  
(817) 545-0891

Engineers, Architects  
and Planners

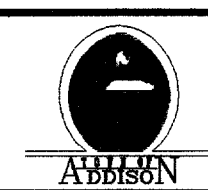

**ADDISON AIRPORT**

**CONCRETE PAVEMENT TYPICAL SECTIONS**

SHEET 6  
DATE: DEC. 1997