



TYPICAL ACCESS TAXIWAY SECTION WITH ASPHALT SURFACE

N.T.S. (ALTERNATE BID NO. 2)

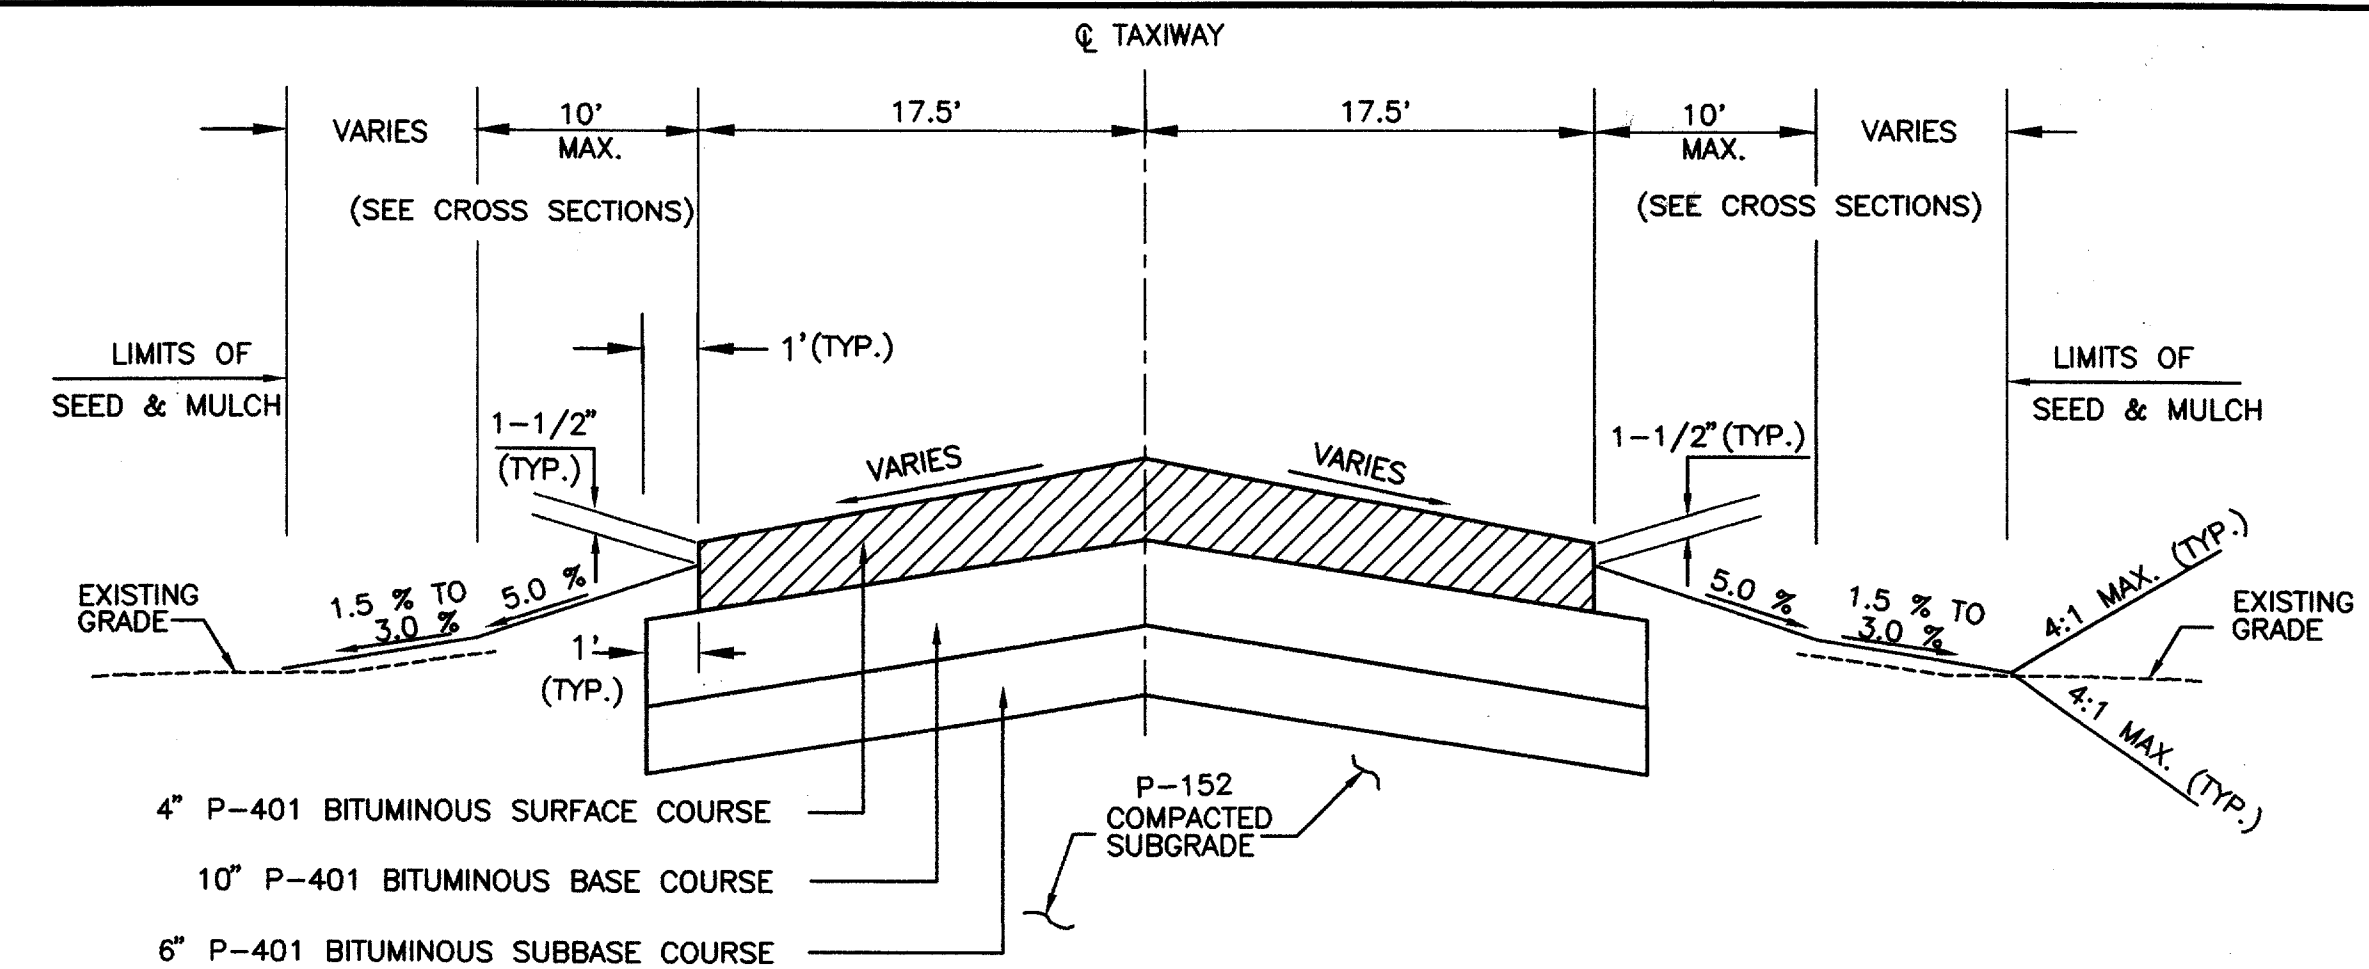


TAXIWAY F TYPICAL SECTION STA. 2+50 TO 4+00

N.T.S. (ALTERNATE BID NO. 2)

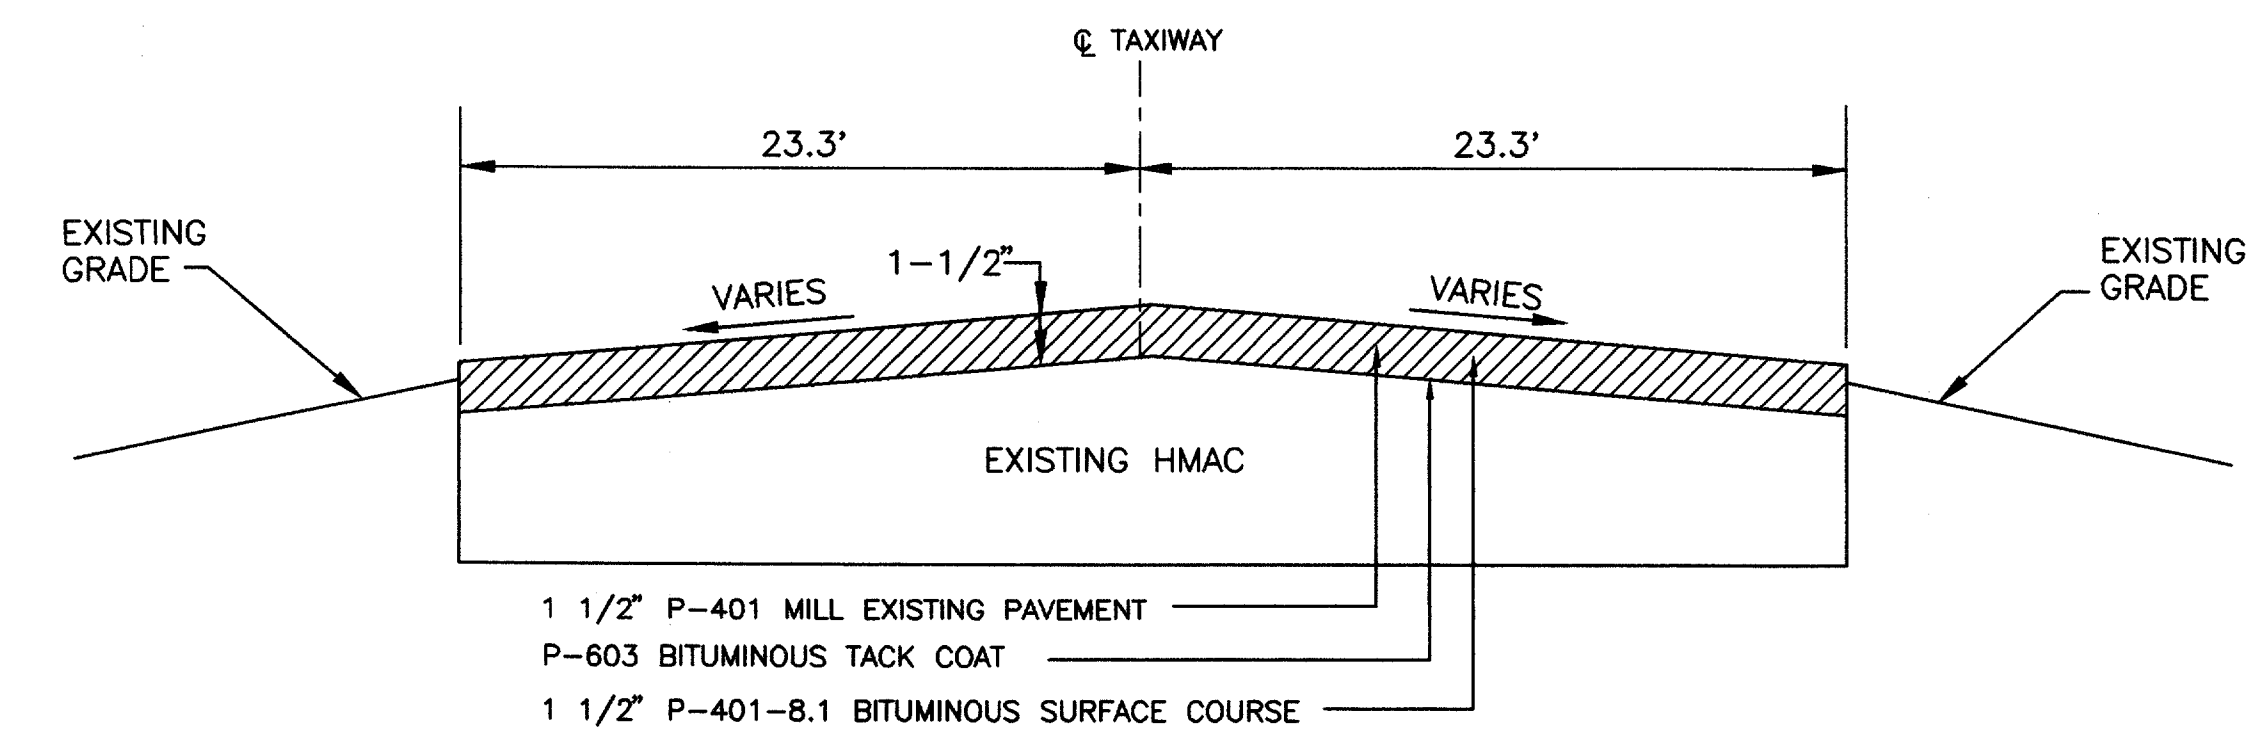


TAXIWAY E OVERLAY TYPICAL SECTION

N.T.S. STA. 1+63.6 TO STA. 3+16

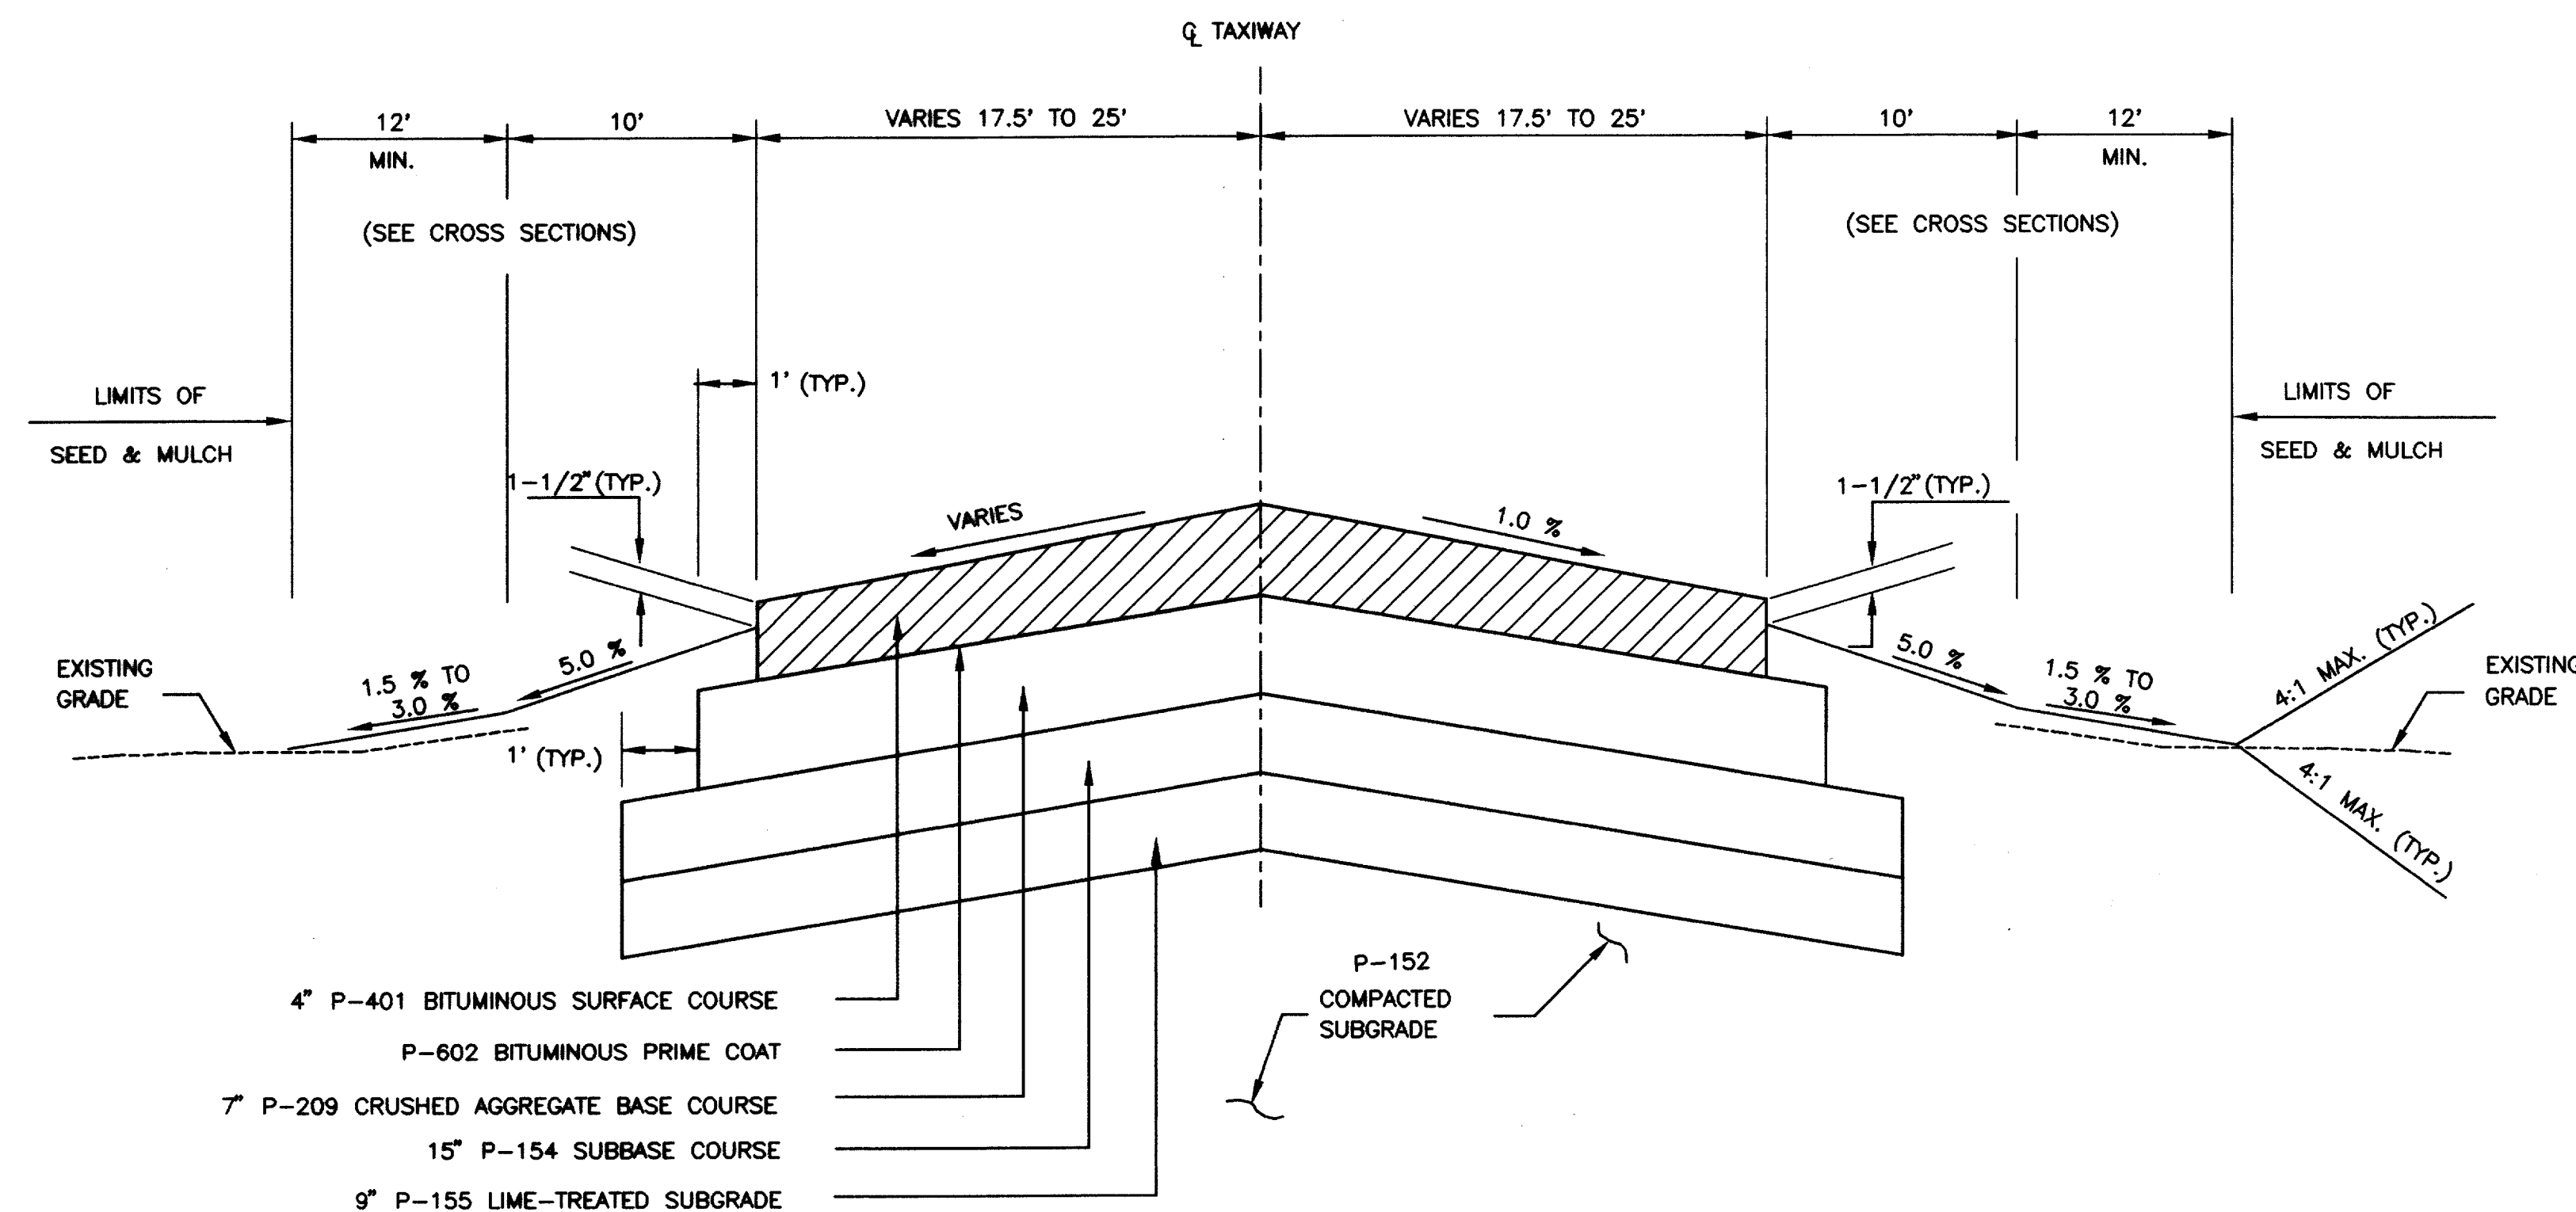

TAXIWAY B TYPICAL SECTION

N.T.S. (ALTERNATE BID NO. 2)

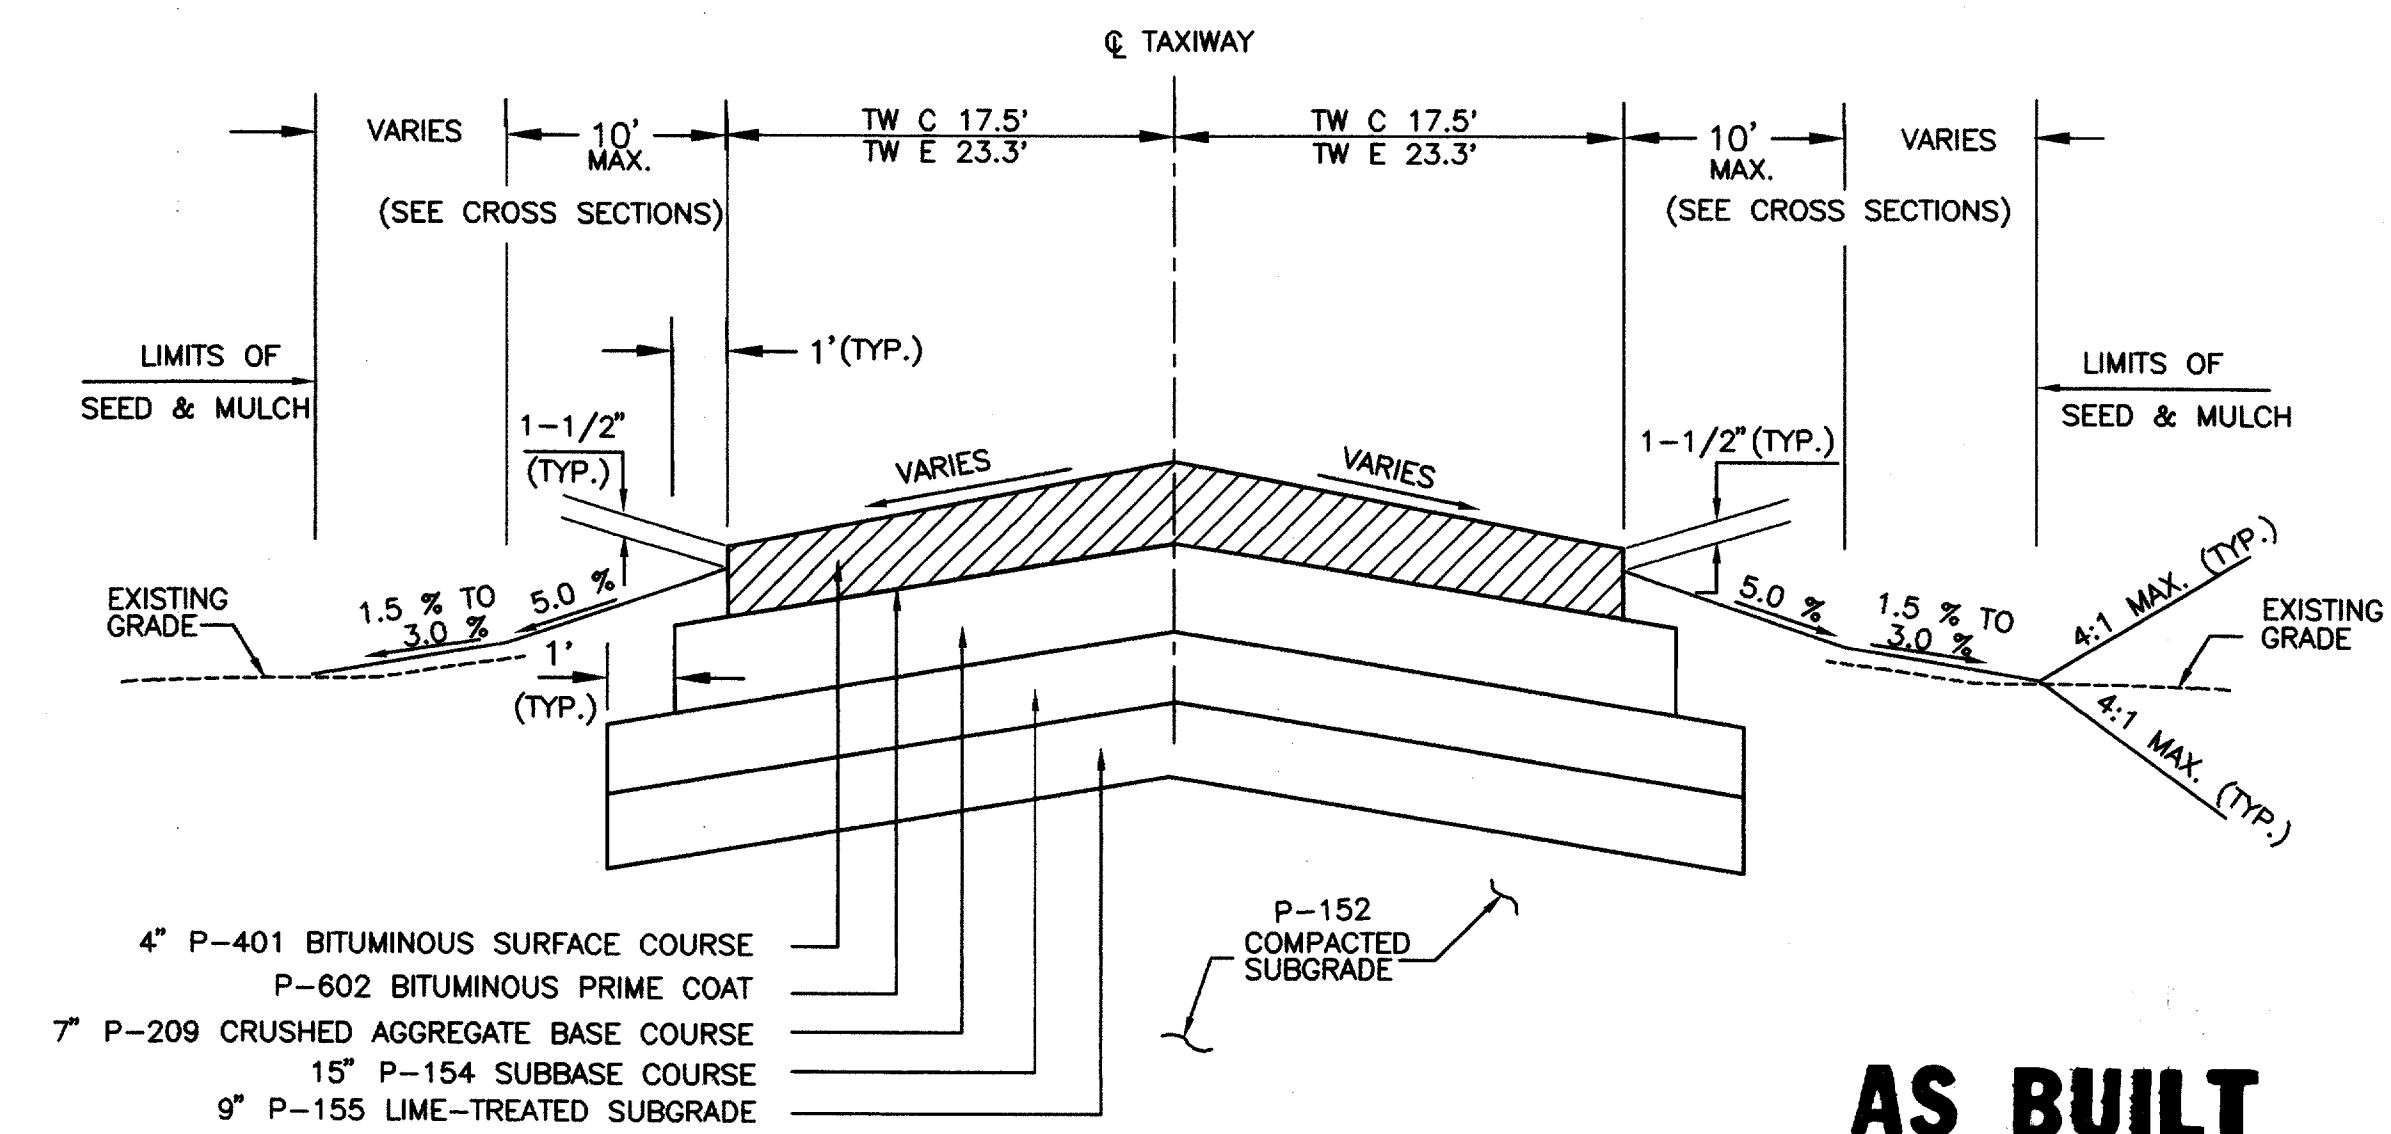

TAXIWAY C TYPICAL SECTION TAXIWAY E STA. 0+00 TO 1+63.6 TAXIWAY F STA. 0+00 TO 2+50

N.T.S. (ALTERNATE BID NO. 2)

AS BUILT

1-11-99



DESIGN: T.L.T.	TXDOT NO: 9842 ADDSN			
DRAWN: J.R.H.	BID NO: 98-04			
CHECKED: R.L.B.	JOB NO: F708024.80	Date	Revisions	By
SCALE: AS NOTED				

URS Greiner
 4100 Aron Carter Blvd., Suite 108
 Fort Worth, TX 76156
 (817) 545-0891

Engineers, Architects and Planners

ADDISON AIRPORT

ASPHALT PAVEMENT TYPICAL SECTIONS

SHEET 7
 DATE: DEC, 1997