


**LEGEND**

- PROPOSED DRAINAGE AREAS (SOUTH SEGMENT)
- PROPOSED DRAINAGE SYSTEM
- EXISTING DRAINAGE AREAS
- +42"--- EXISTING DRAINAGE SYSTEM


**AS BUILT**  
1-11-99

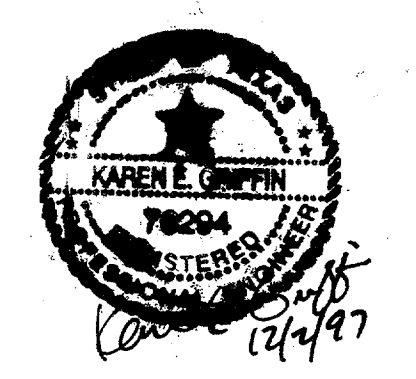

DESIGN: T.L.T.	PROJECT NO: 9842 ADDSN	Date	Revisions	By
DRAWN: J.R.H.	BID NO: 98-04			
CHECKED: R.L.B.	JOB NO: F708024.80			
SCALE: 1"=400'				

**URS Greiner**  
4100 Amon Carter Blvd., Suite 108  
Fort Worth, TX 76155  
(817) 545-0891

Engineers, Architects  
and Planners

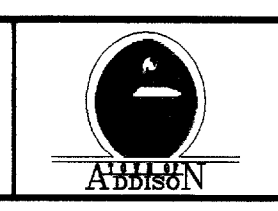

# ADDISON AIRPORT

## DRAINAGE AREA MAP