

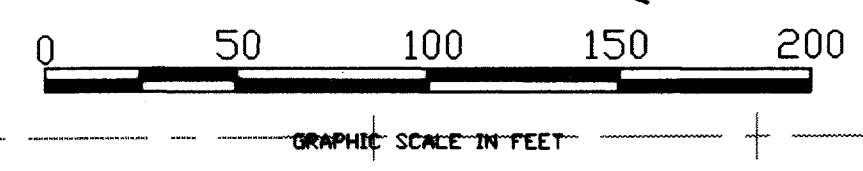


MATCH LINE STA. 227+00 SEE SHEET NO. 12

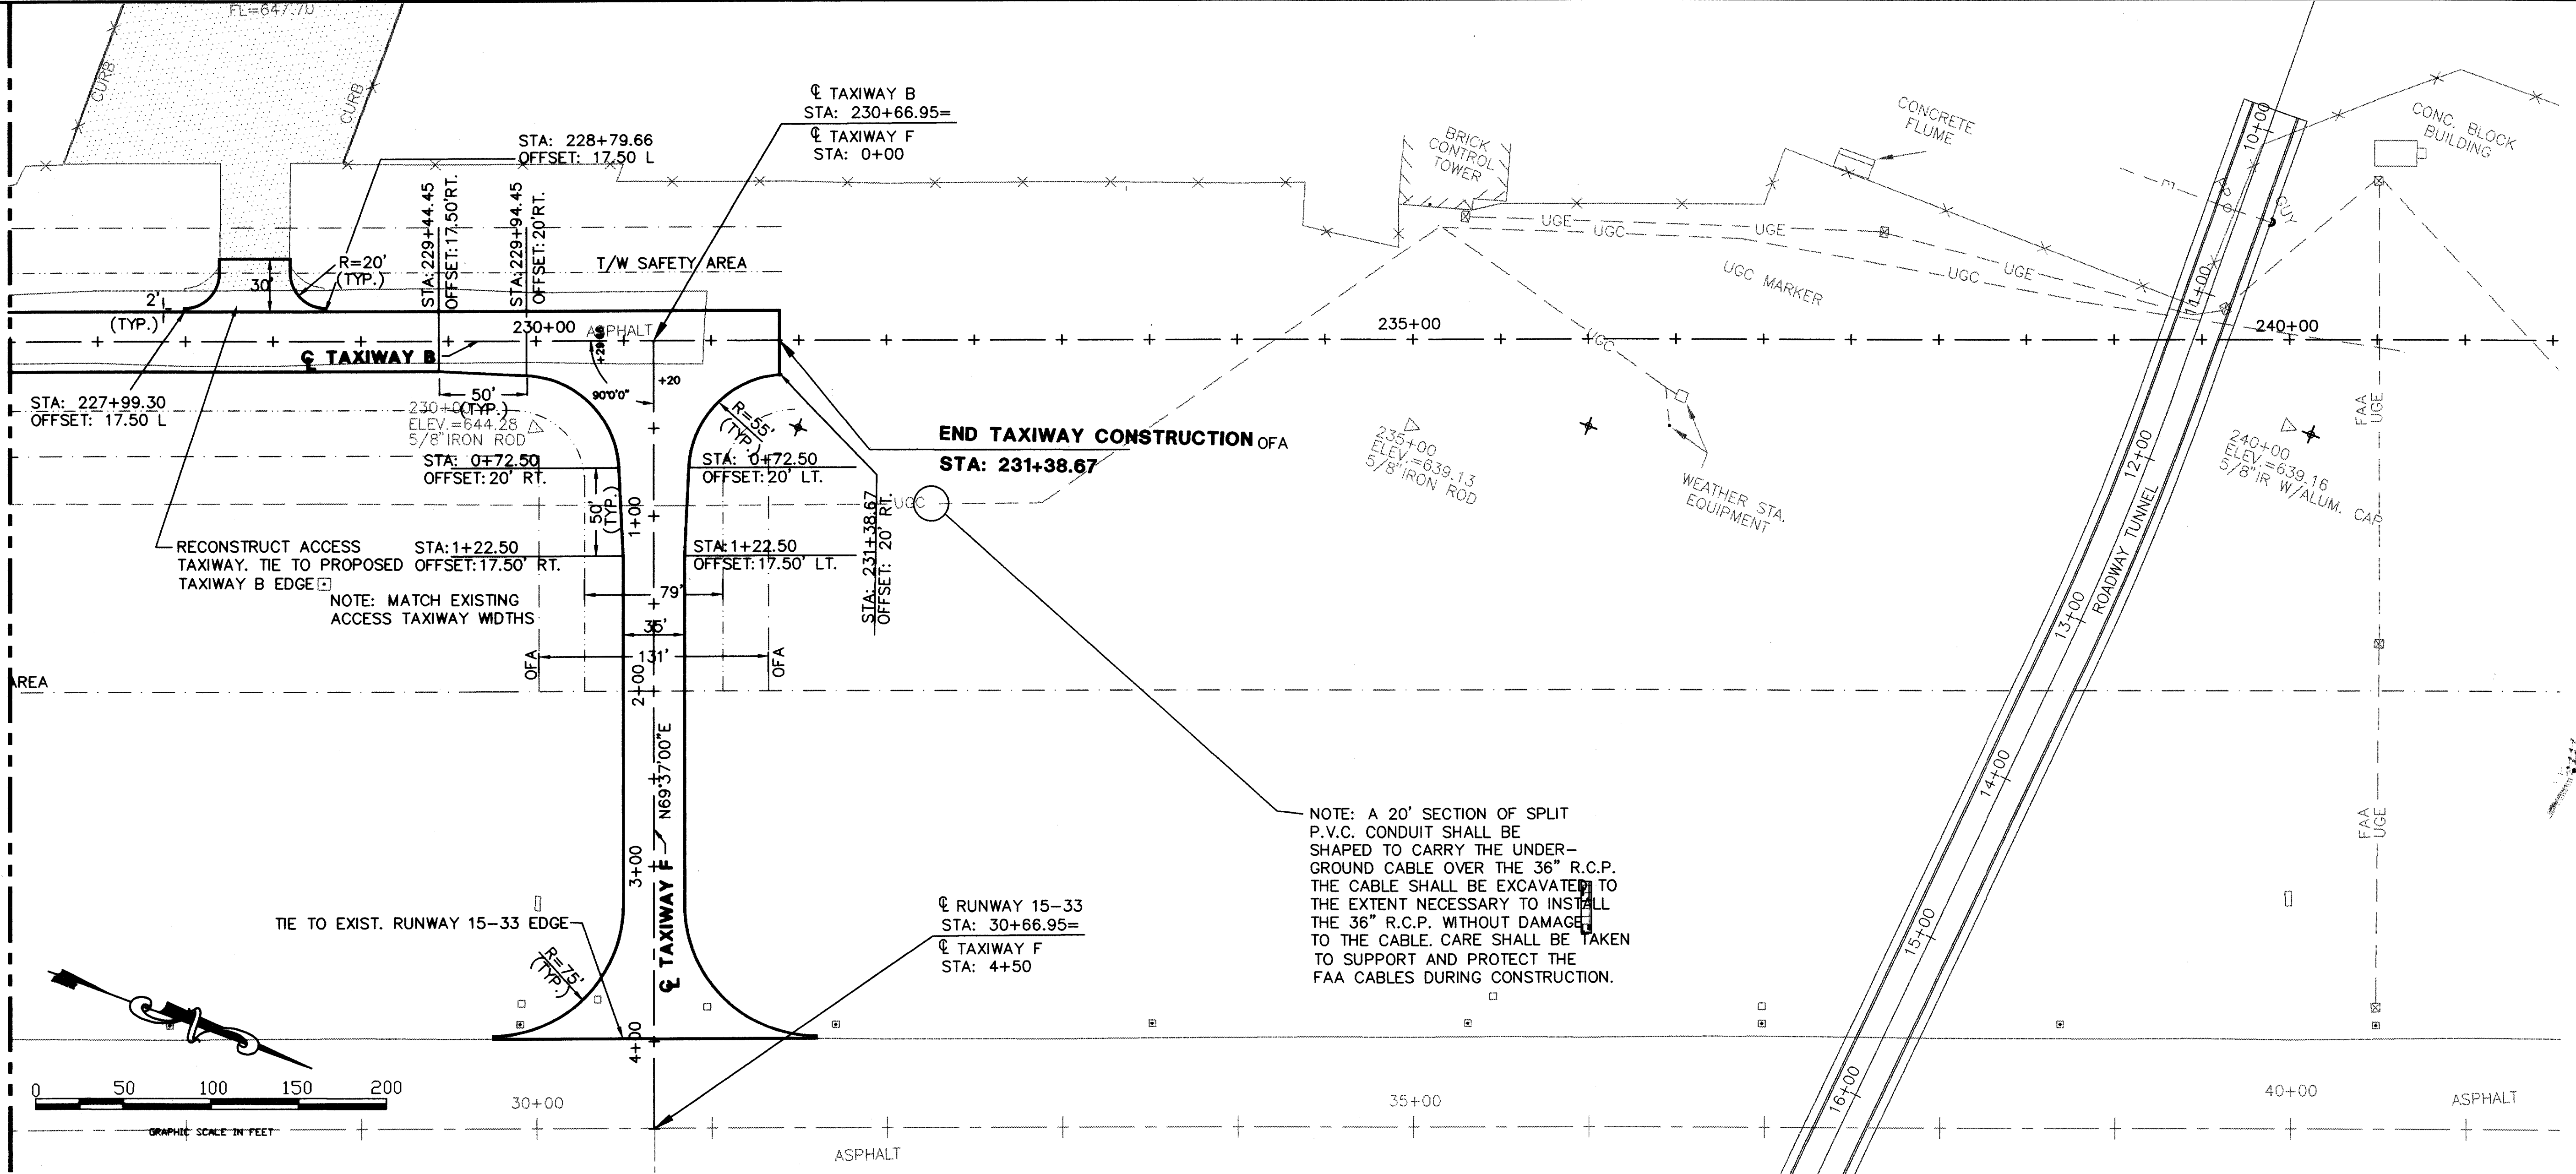

MATCH LINE STA. 227+00

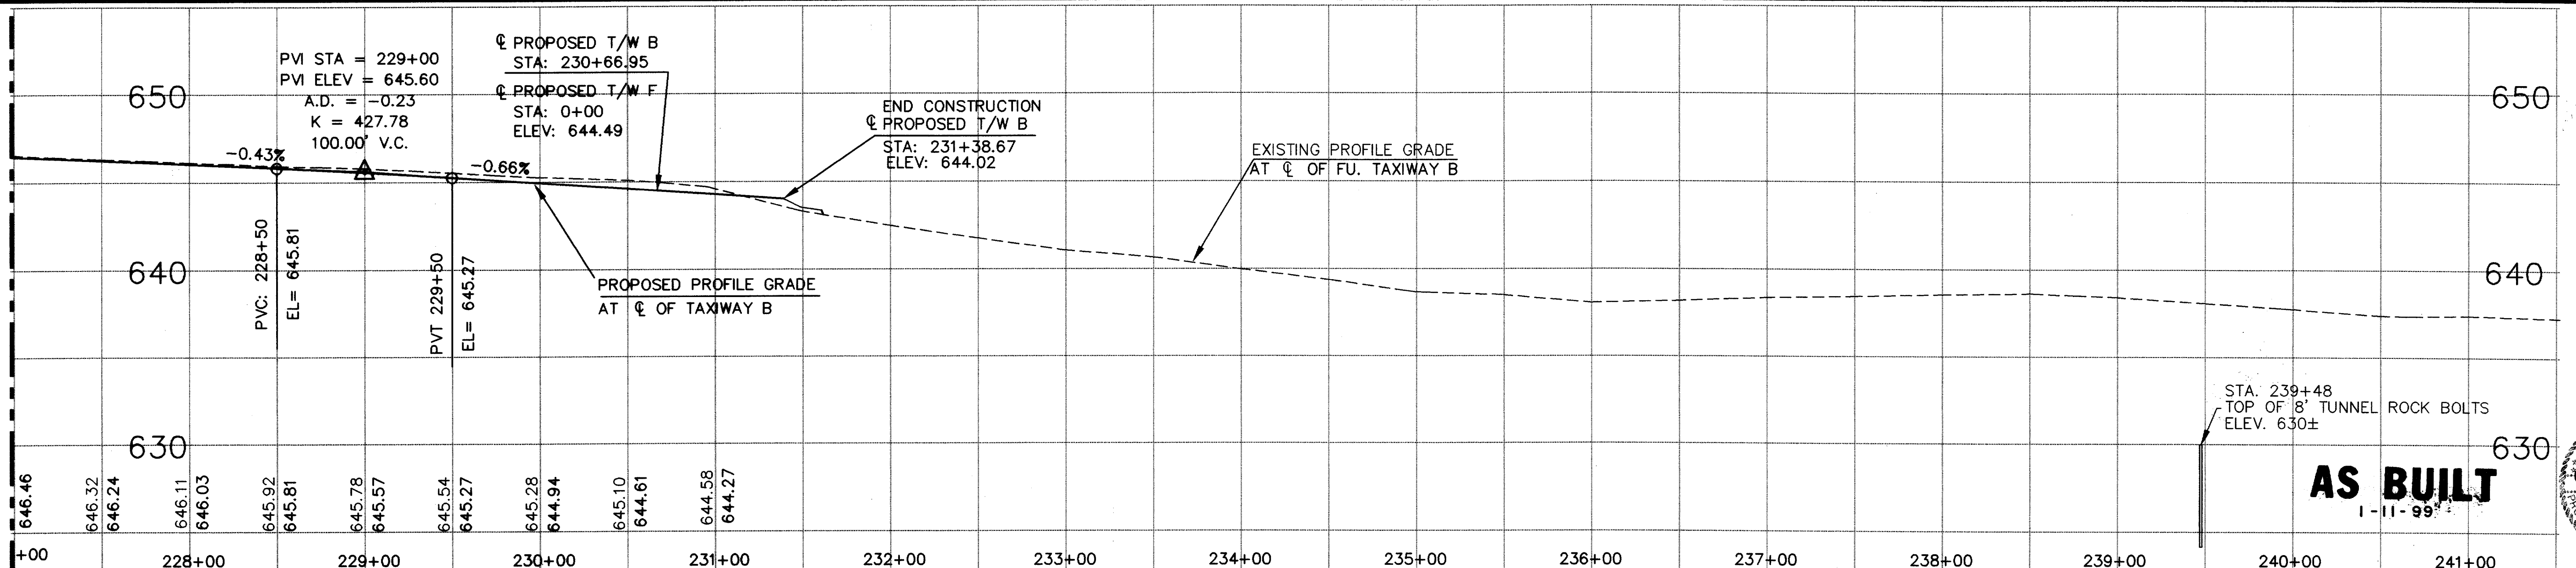

**AS BUILT**  
1-11-99

