



PROFILE FOR TAXIWAY C

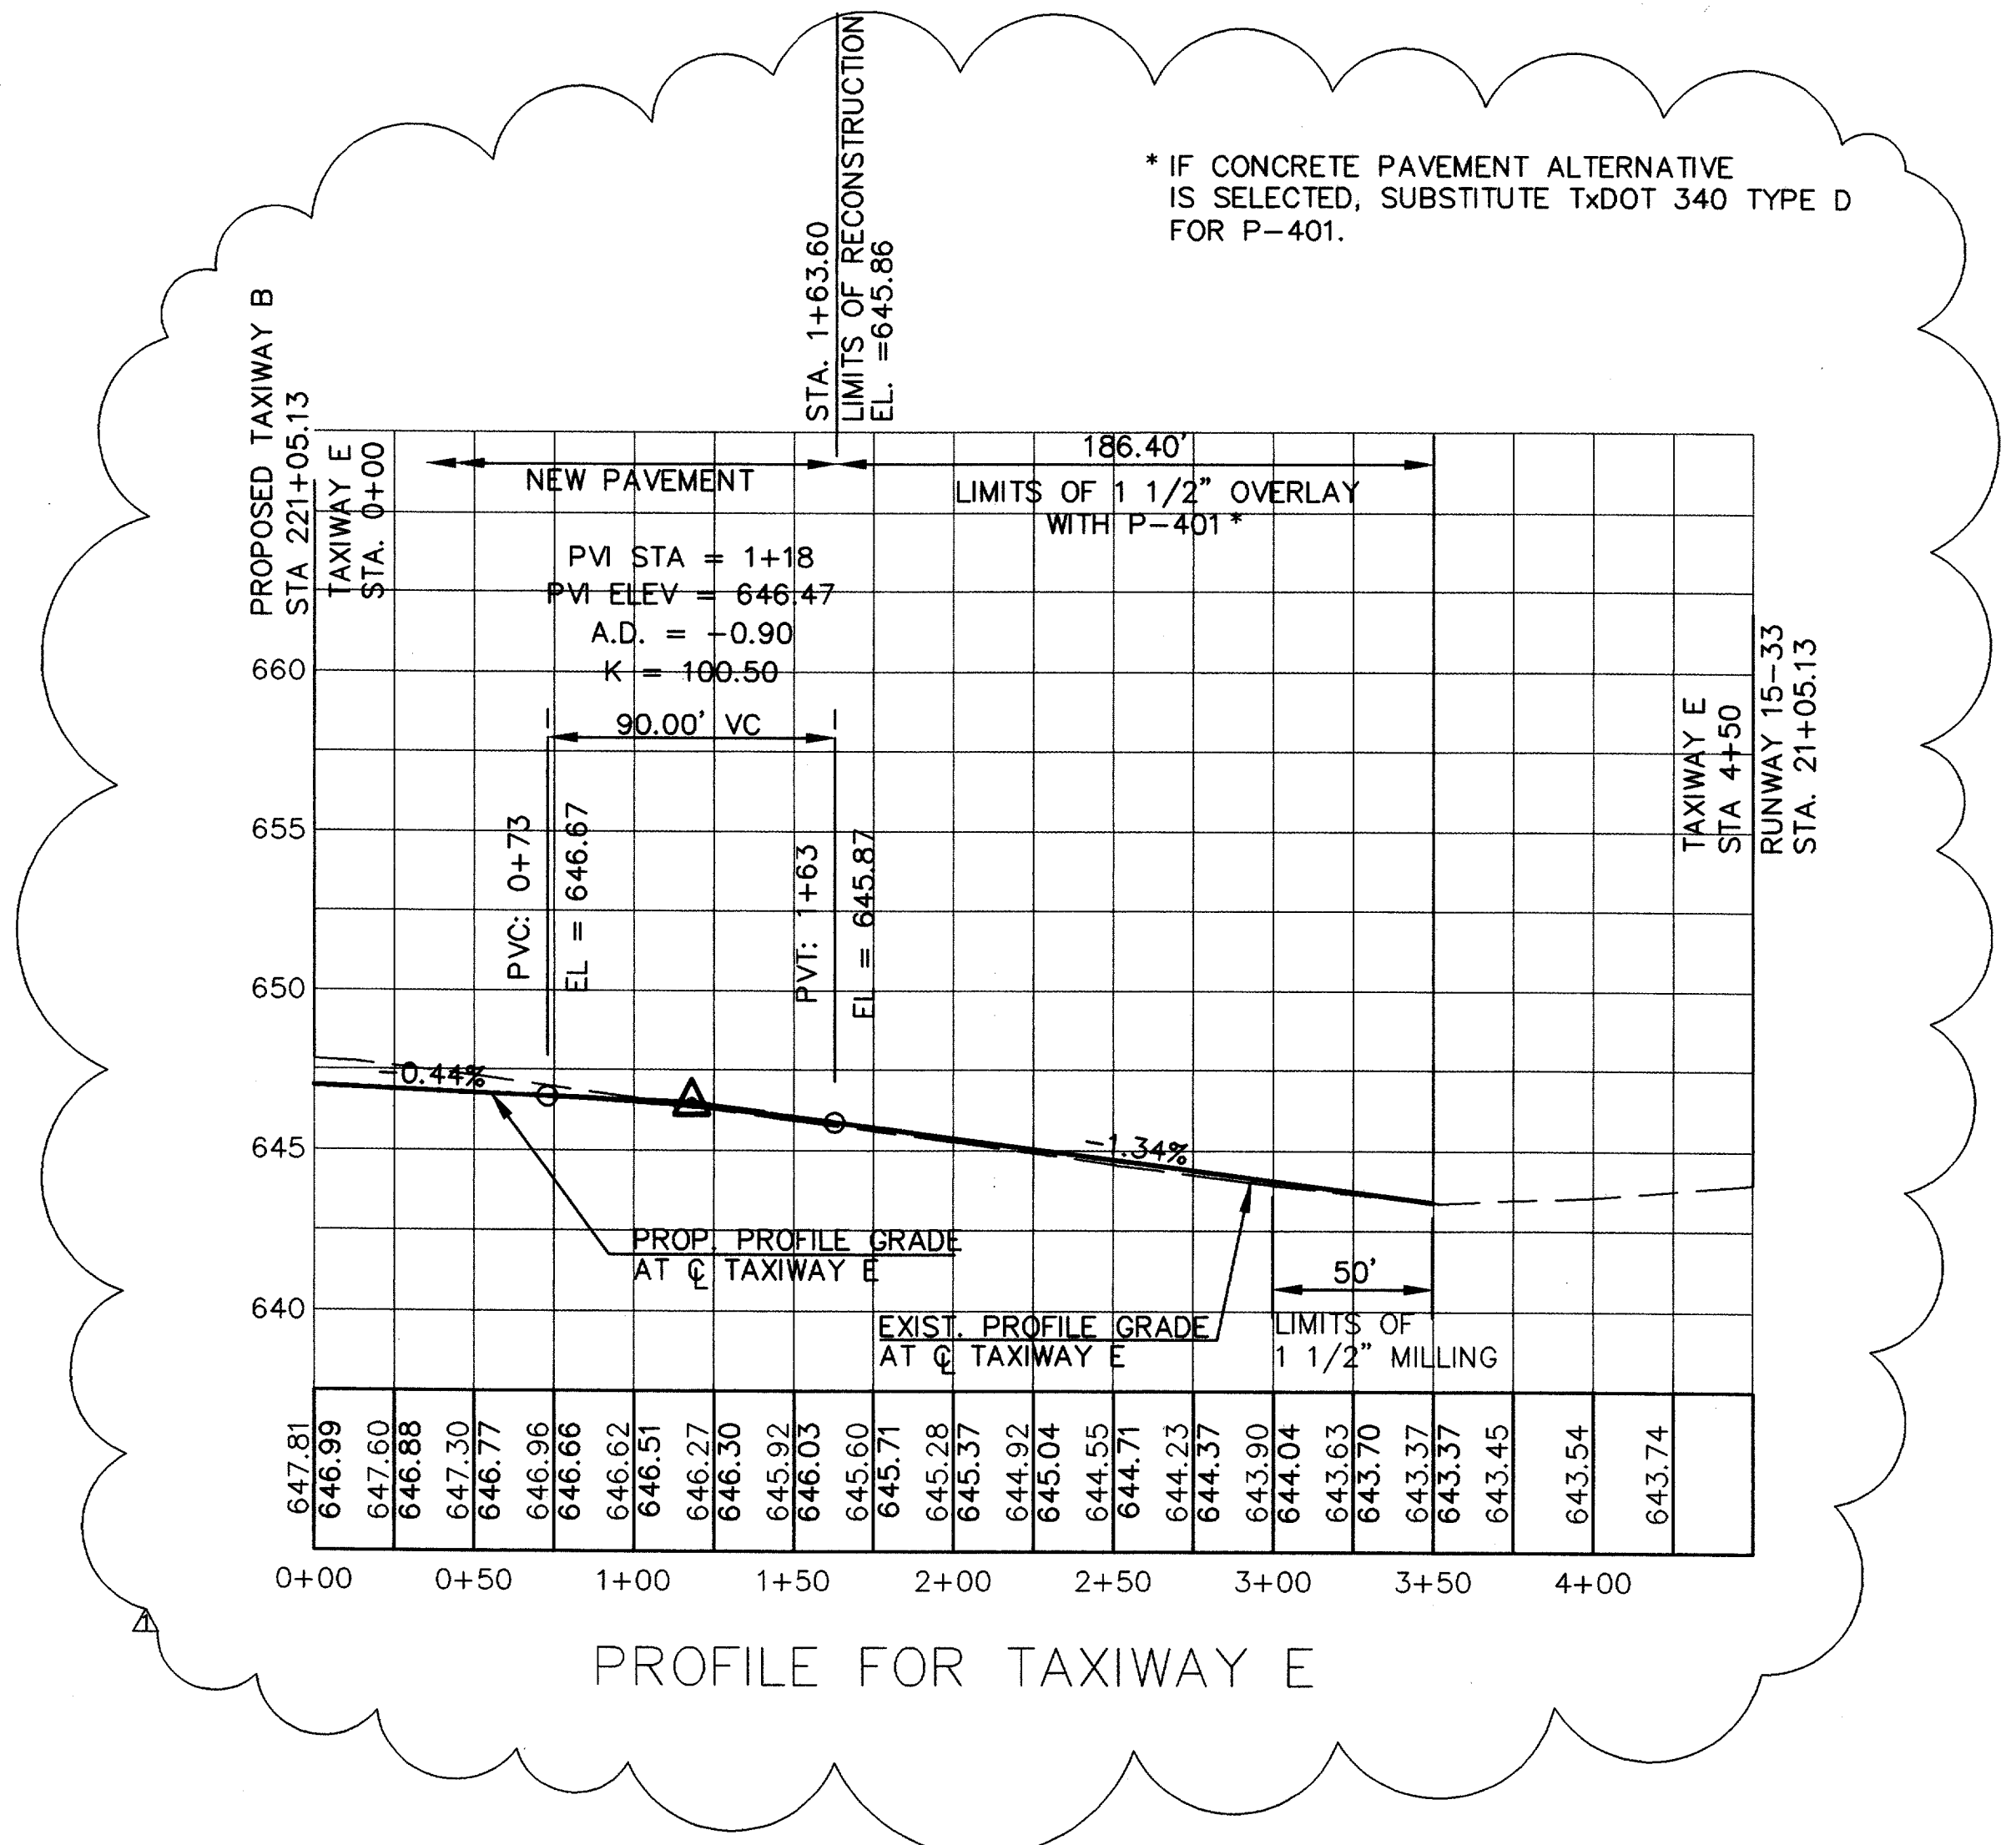

PROFILE FOR TAXIWAY E

* IF CONCRETE PAVEMENT ALTERNATIVE IS SELECTED, SUBSTITUTE TxDOT 340 TYPE D FOR P-401.

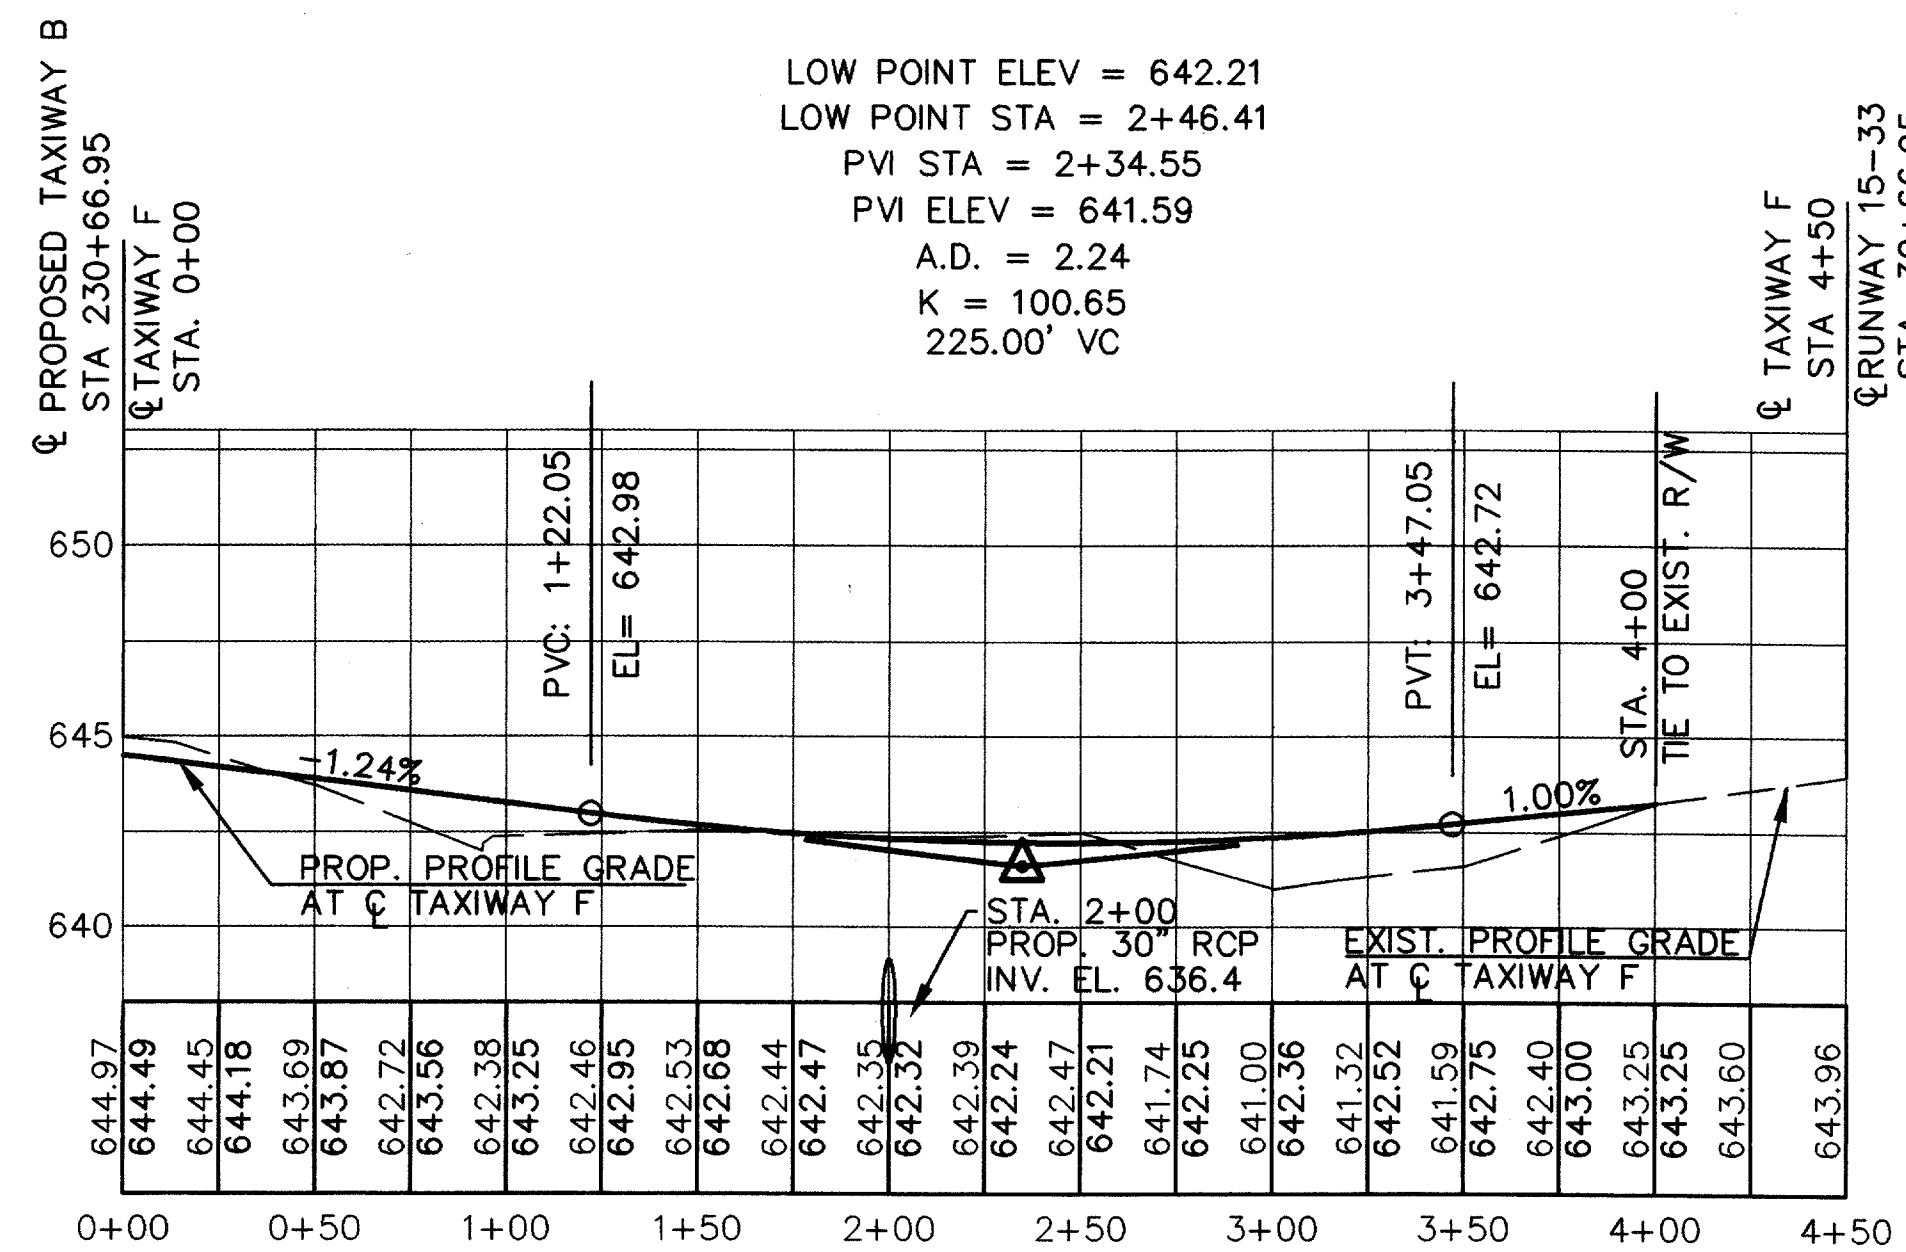

PROFILE FOR TAXIWAY F


DESIGN: T.L.T.
 DRAWN: M.J.C.
 CHECKED: R.L.B.
 SCALE: 1"=50'HORIZ.
 1"=5'VERT.

TXDOT NO. 9842 ADDSN
 BID NO. 98-04
 JOB NO. E708024.80

Date	Revisions	By

URS Greiner
 4100 Arnon Carter Blvd., Suite 108
 Fort Worth, TX 76155
 (817) 545-0891


Engineers, Architects
 and Planners

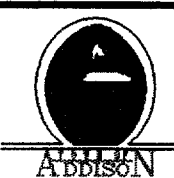

ADDISON AIRPORT

**WEST TAXIWAY "B" & DRAINAGE IMPROVEMENTS
 TAXIWAY C, E AND F PROFILES**

AS BUILT
 1-11-99

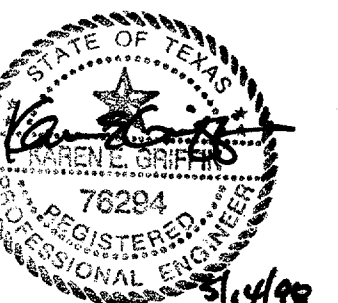

SHEET
14
 DATE: DEC. 1997