



MATCH LINE STA. 214+00 SEE SHEET NO.16

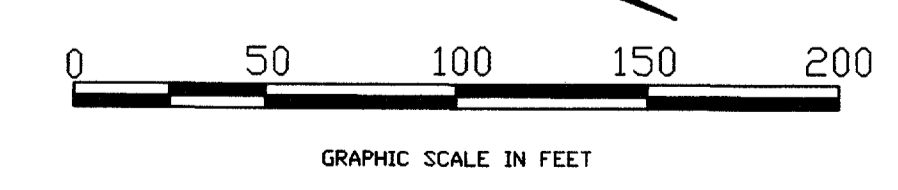

**AS BUILT**  
1 - 11 - 99

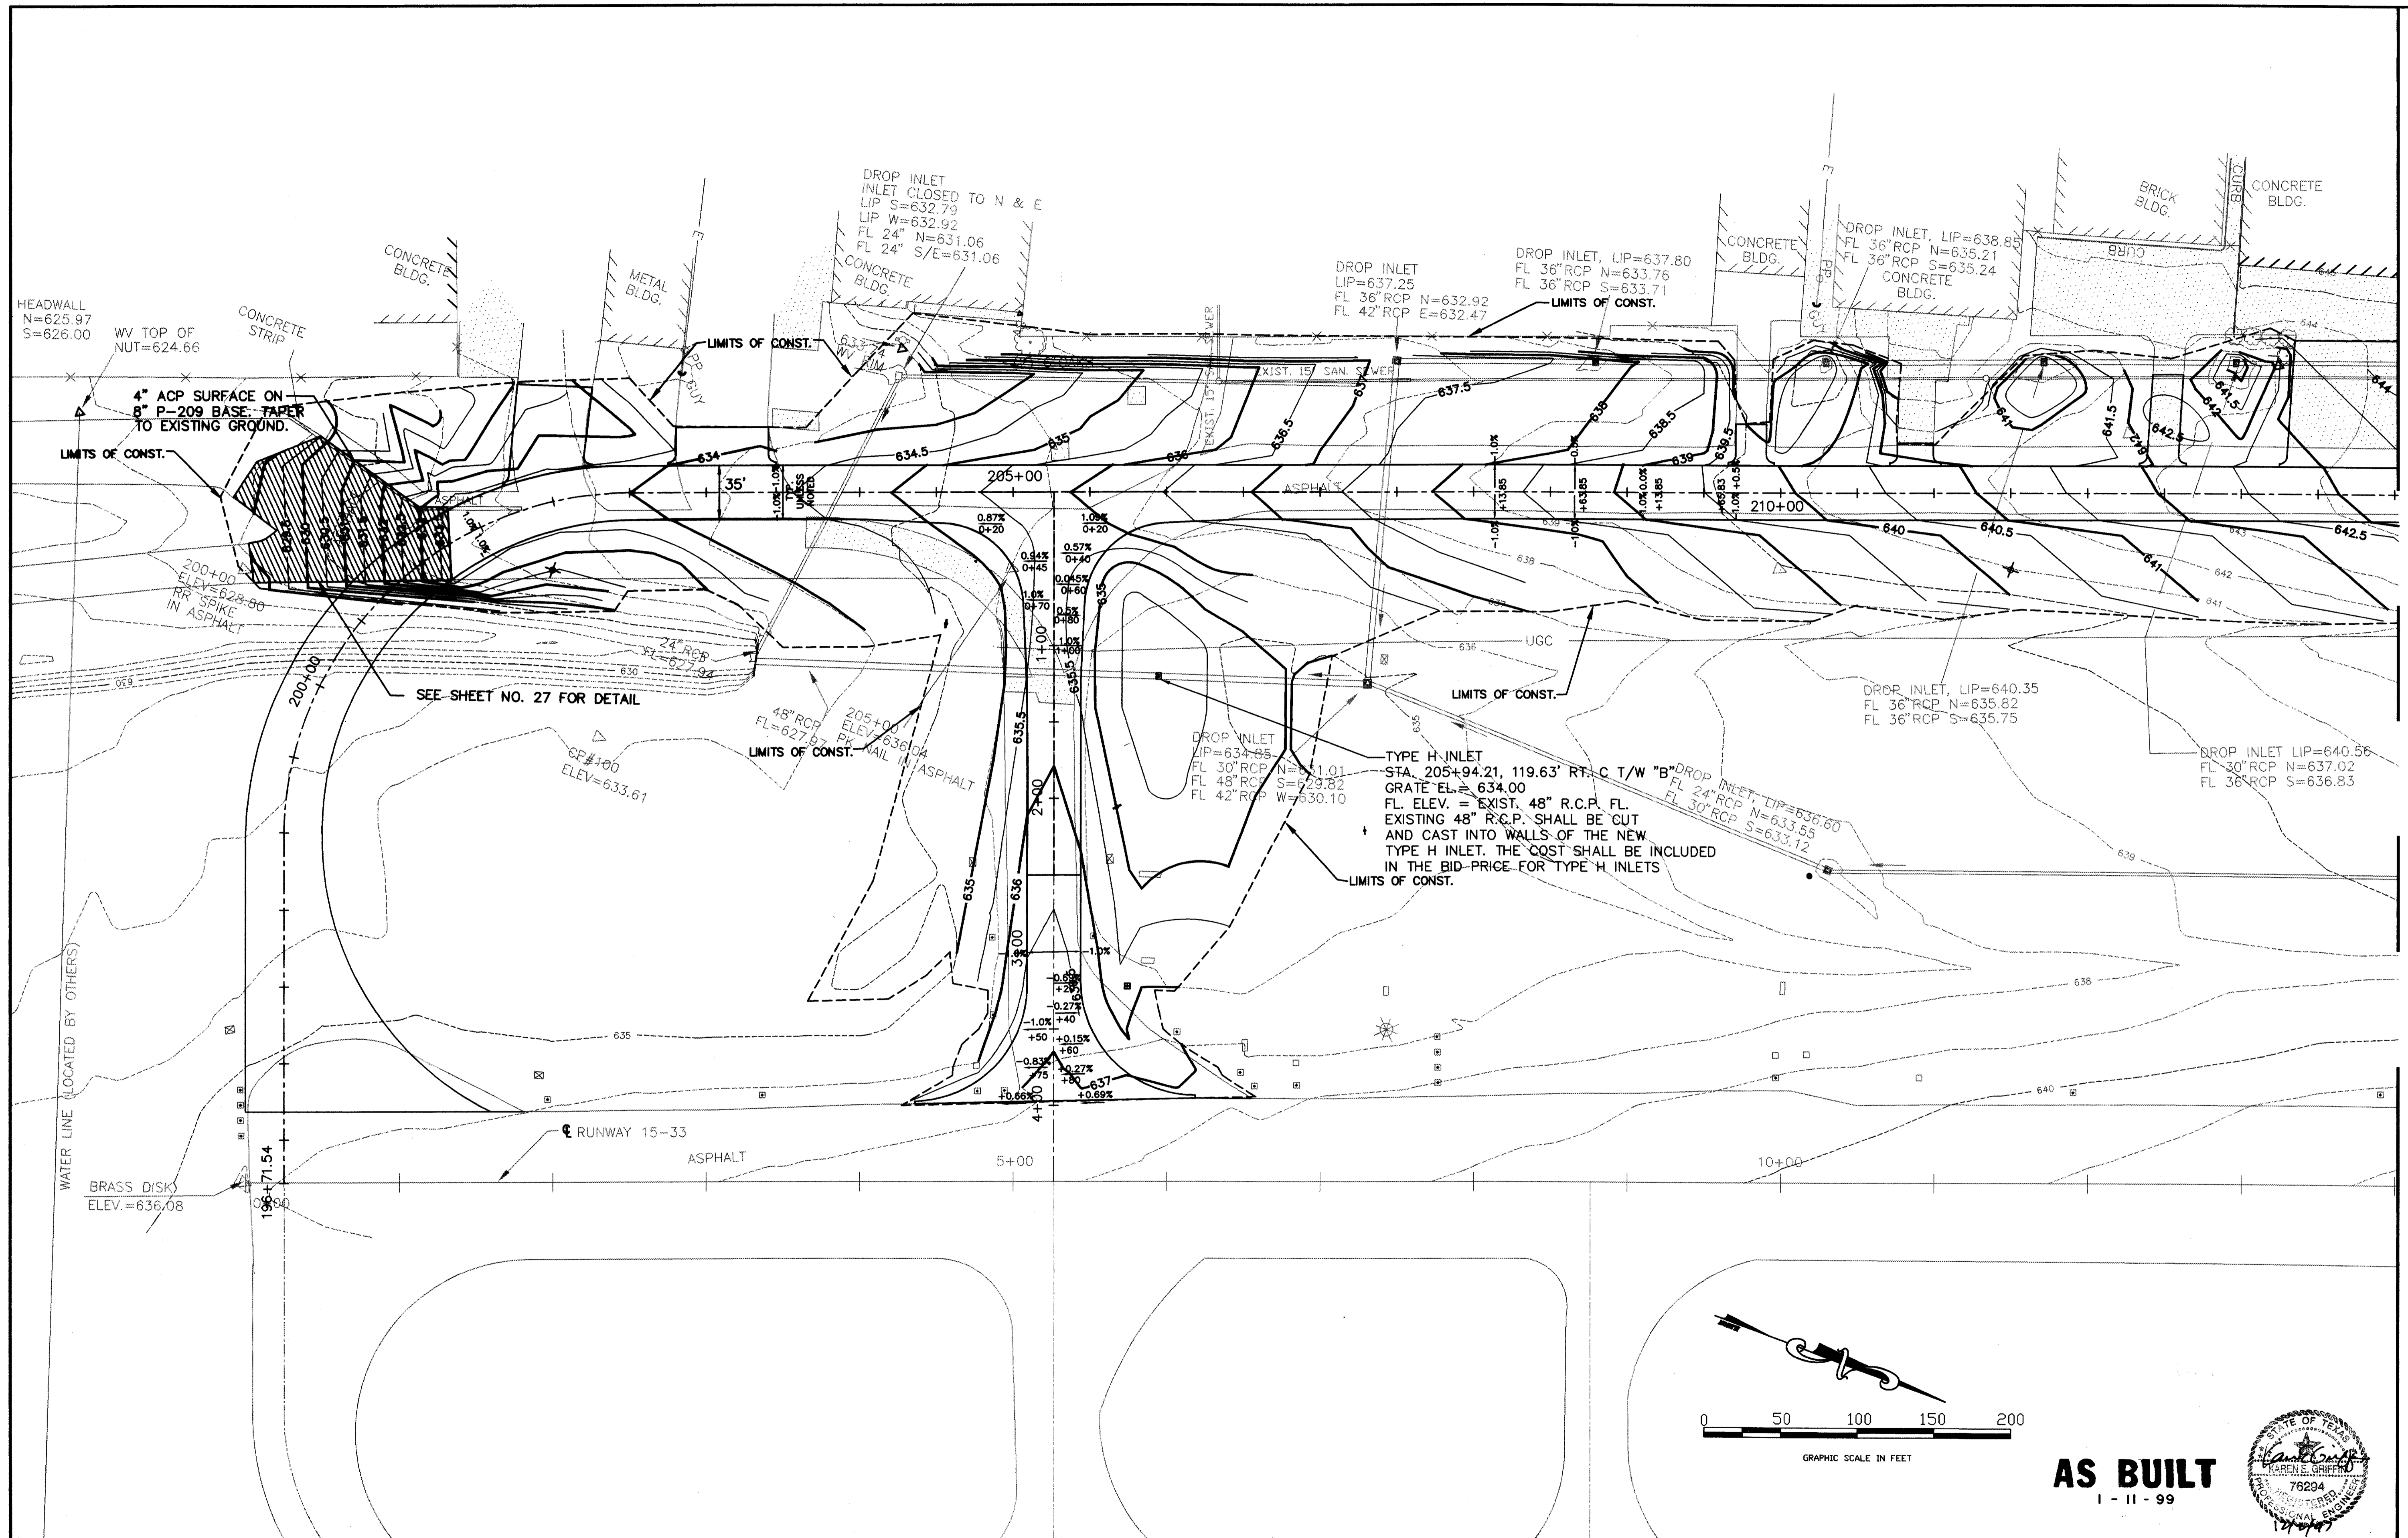

DESIGN T.L.T.  
DRAWN M.J.G.  
CHECKED R.L.B.  
SCALE 1"=50'

PROJECT NO. 9842 ADDSN  
JOB NO. 98-04  
JOB NO. E709024.80

Date	Revisions	By

**URS Greiner**  
4100 Arnon Carter Blvd., Suite 108  
Ft. Worth, TX 76155  
(817) 545-0891

Engineers, Architects  
and Planners



# ADDISON AIRPORT

WEST TAXIWAY "B" & DRAINAGE IMPROVEMENTS  
GRADING PLAN

SHEET  
**15**  
DATE: DEC, 1997