

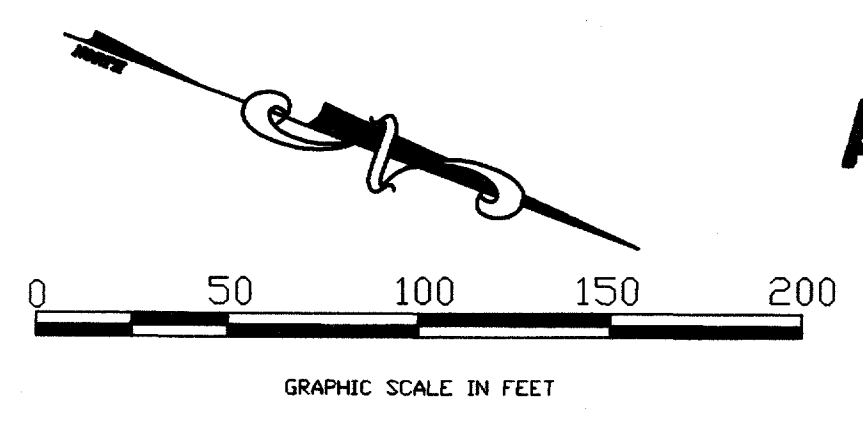


MATCH LINE STA. 214+00 SEE SHEET NO.15

MATCH LINE STA. 227+50 SEE SHEET NO.17

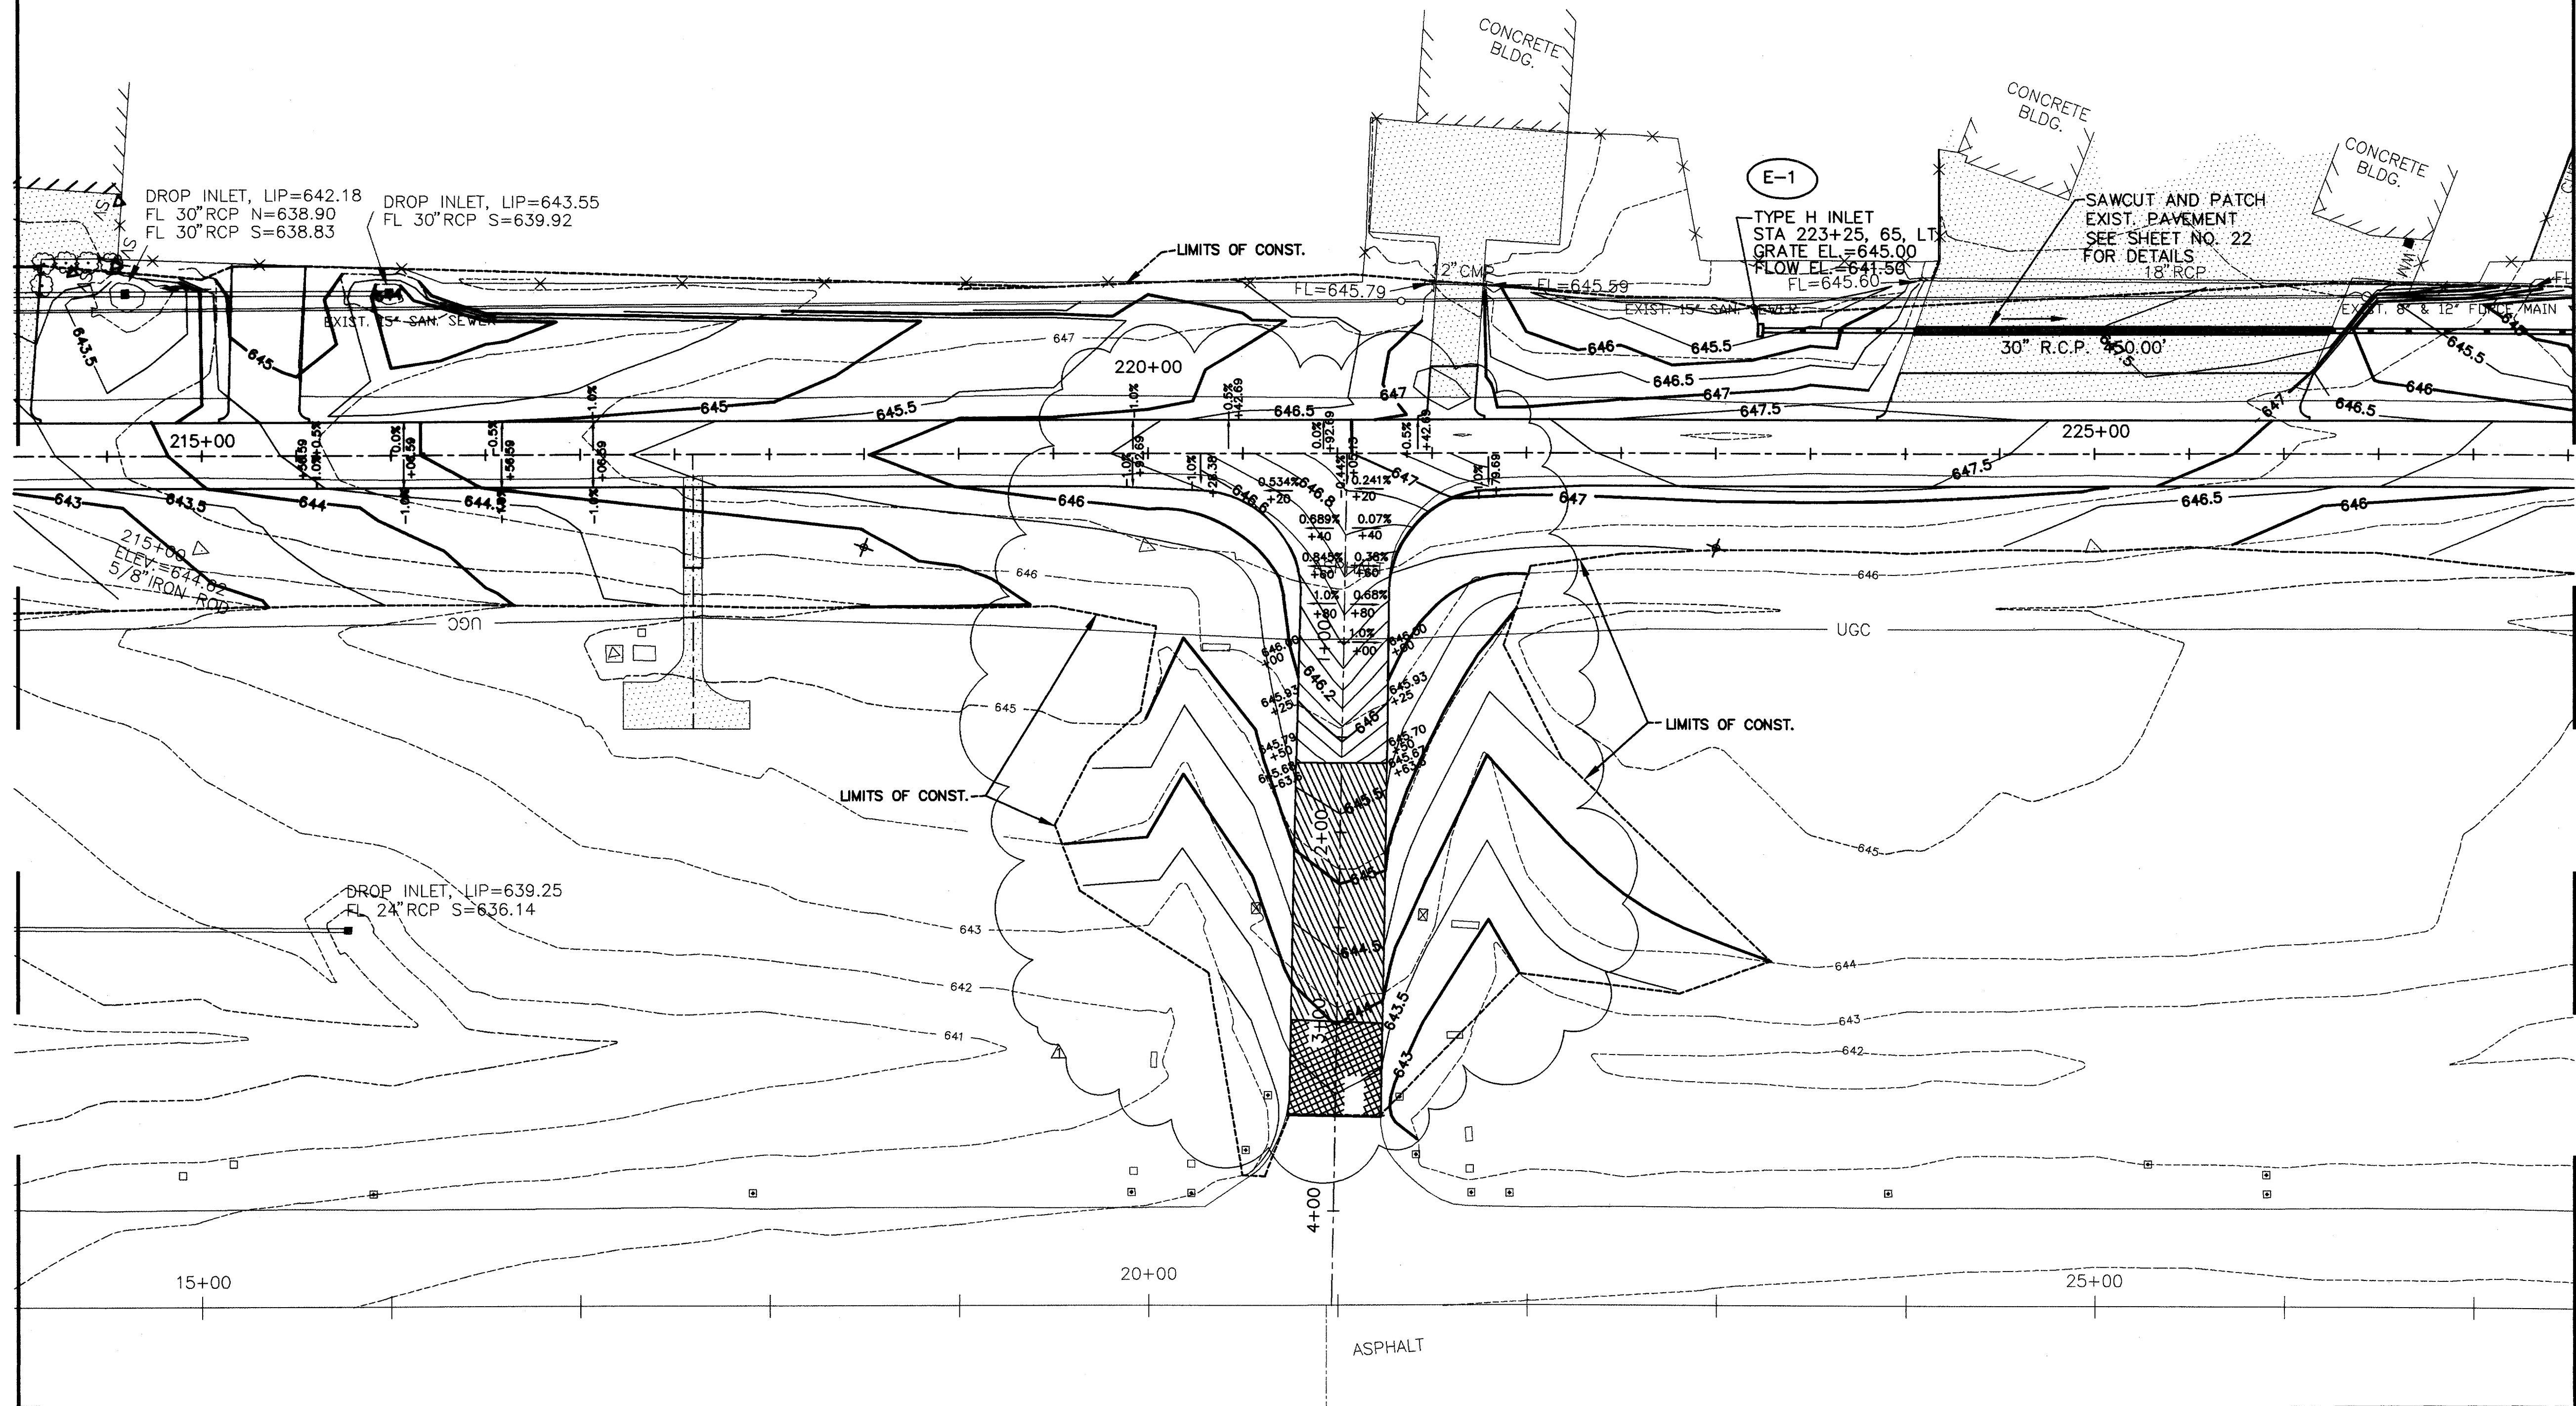

AS BUILT
1-11-99

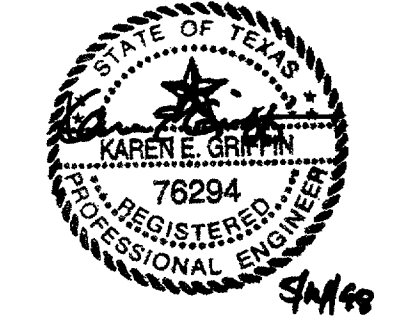

DESIGN TLT
 DRAWN M.J.G.
 CHECKED R.L.B.
 SCALE: 1"=50'

PROJECT NO. 9842 ADDSN
 BID NO. 98-04
 JOB NO. E708024.80

Date	Revisions	By

URS Greiner
 4100 Armon Carter Blvd., Suite 108
 Fort Worth, TX 76135
 (817) 545-0891

Engineers, Architects
 and Planners



ADDISON AIRPORT

WEST TAXIWAY "B" & DRAINAGE IMPROVEMENTS
 GRADING PLAN

SHEET
16
 DATE: DEC. 1997