



MATCH LINE STA. 227+50 SEE SHEET NO.16

MATCH LINE STA. 241+00 SEE SHEET NO.18

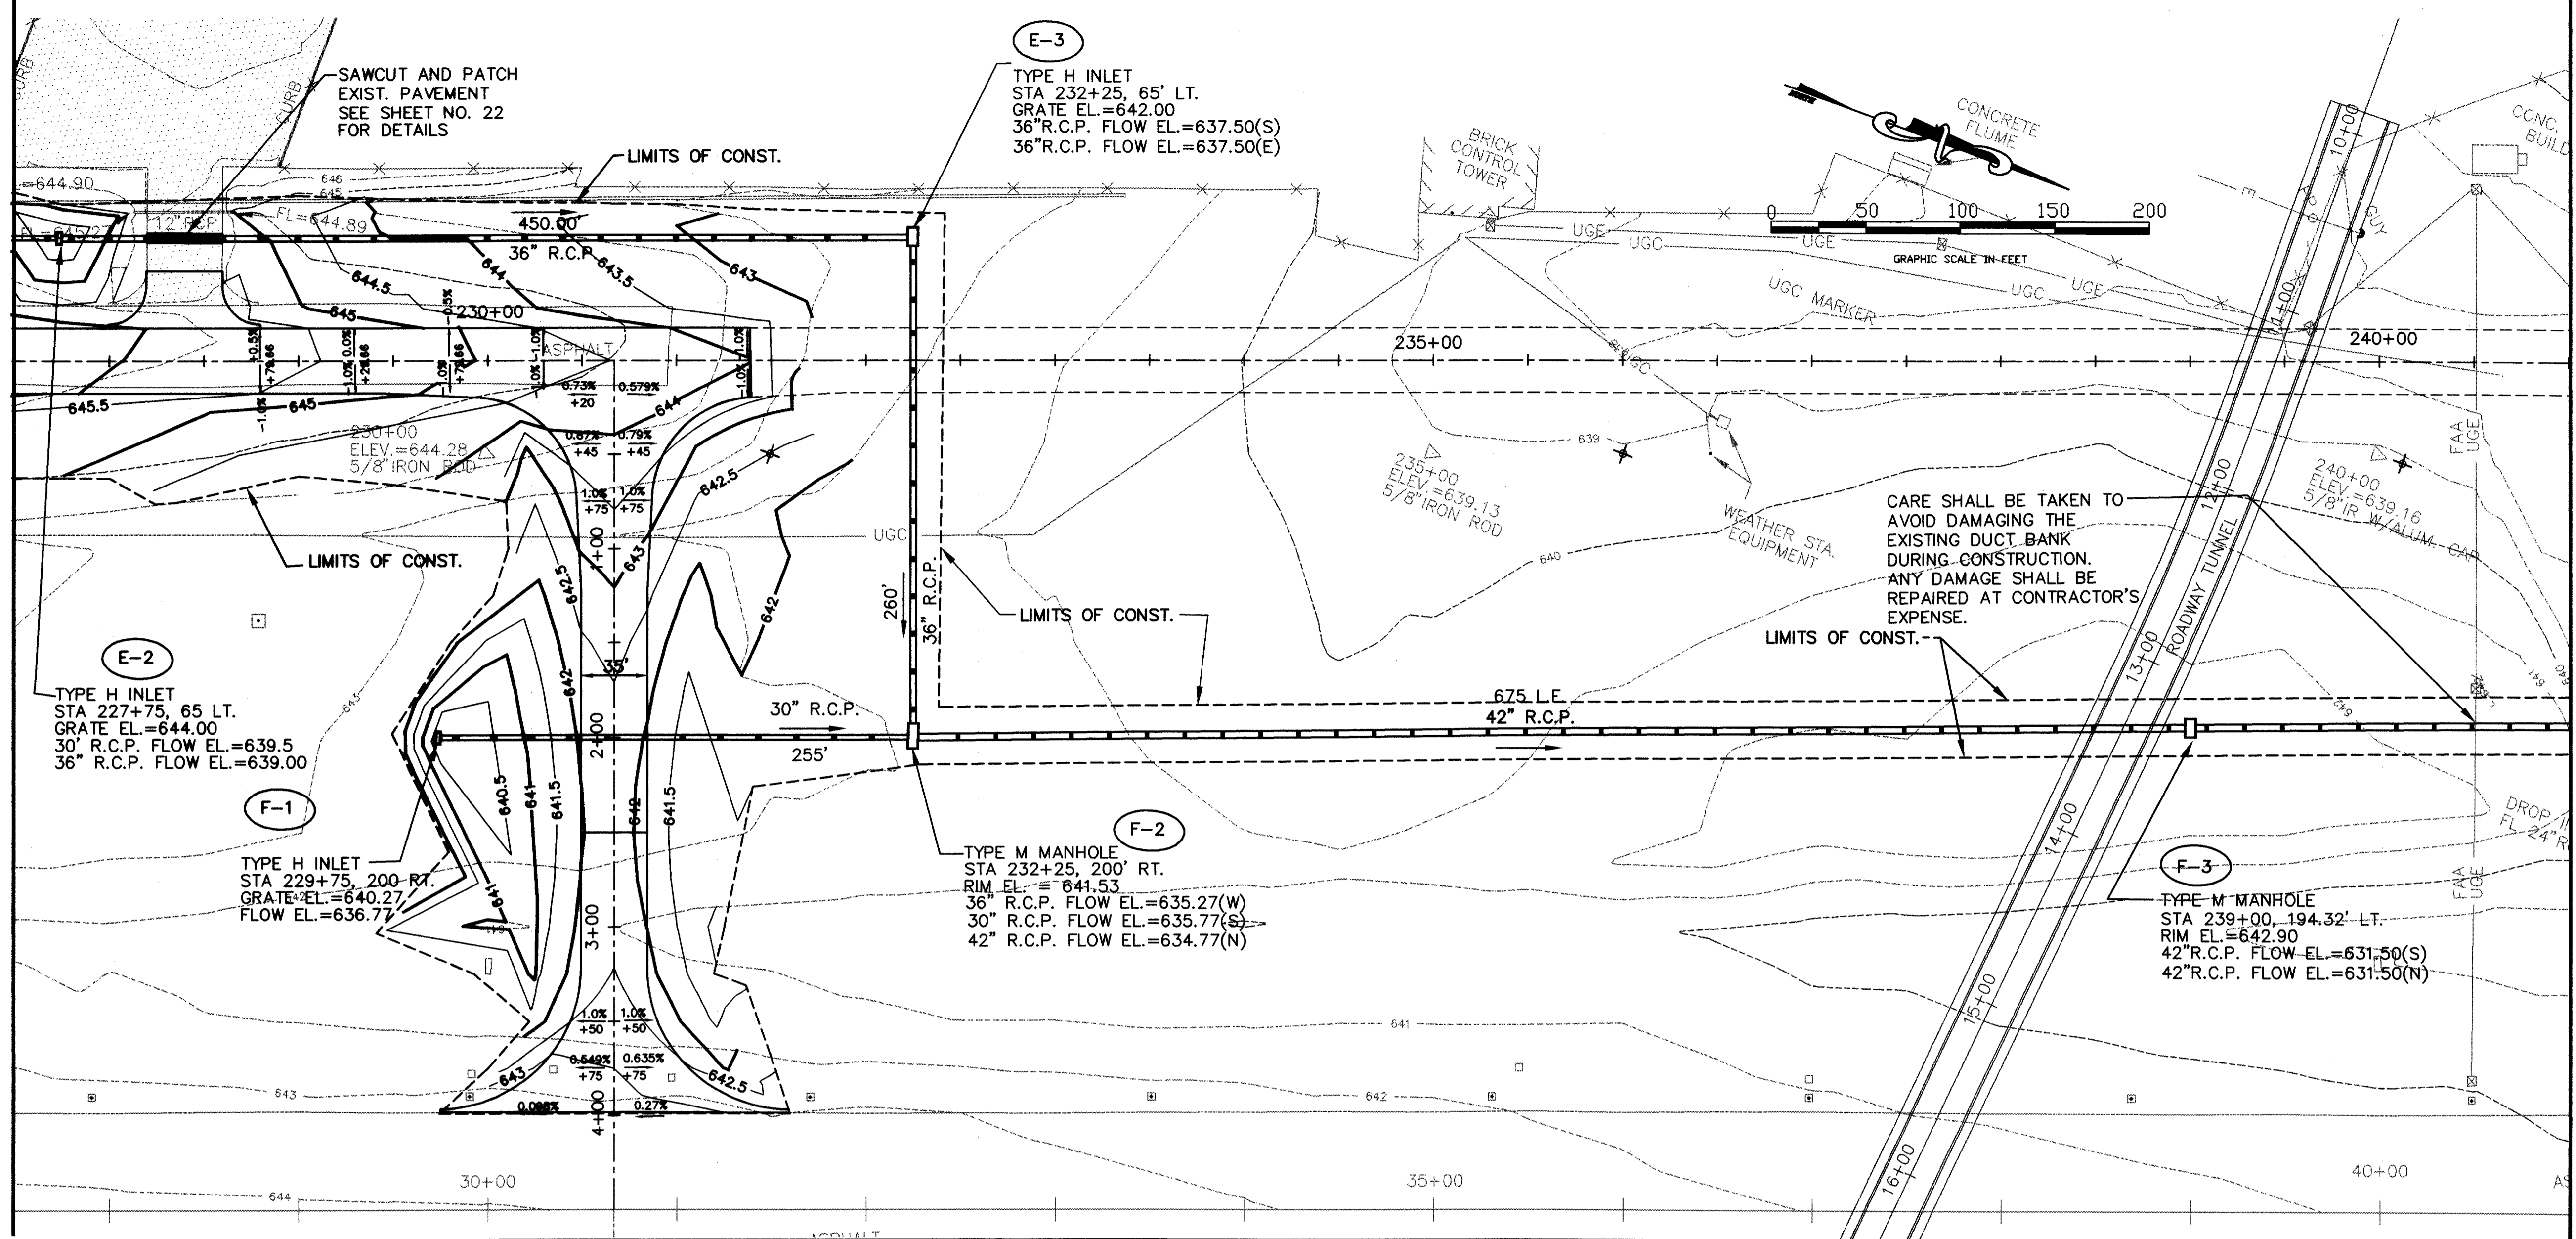

MATCH LINE

MATCH LINE

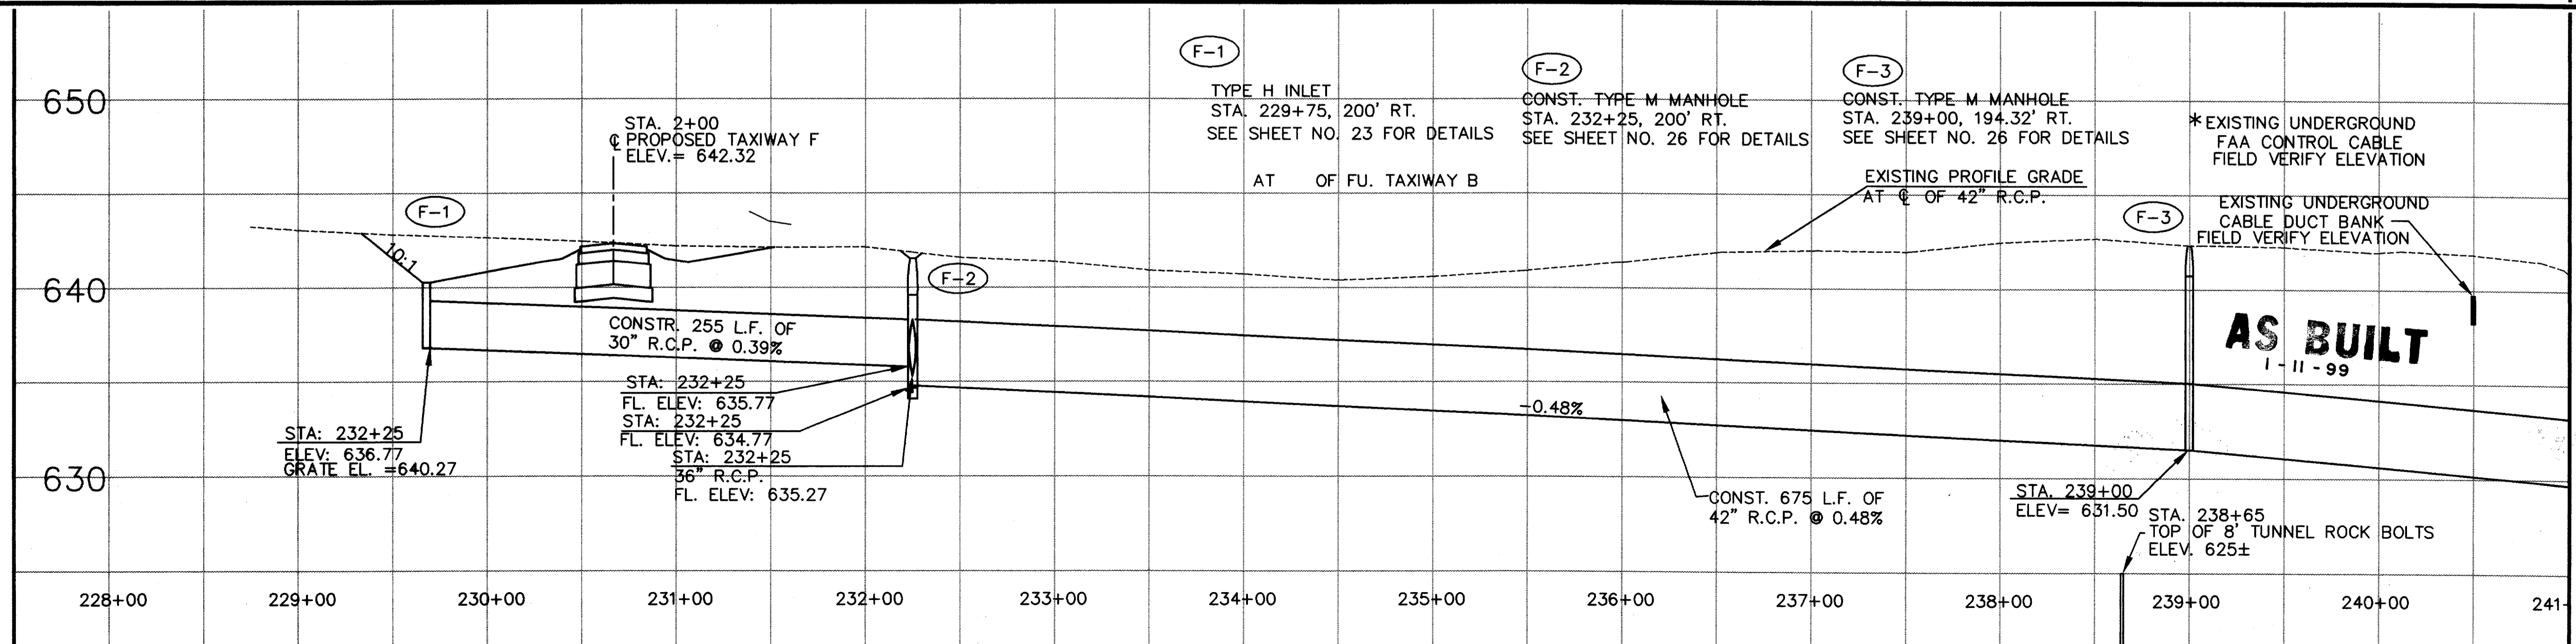

DESIGN: T.L.T.  
 DRAWN: M.L.G.  
 CHECKED: R.L.B.  
 SCALE: 1"=50'

PROJECT NO. 9842 ADDSN  
 BID NO. 98-04  
 JOB NO. E708024.80

| Date | Revisions | By |
|------|-----------|----|
|      |           |    |

**URS Greiner**  
 4100 Aman Center Blvd., Suite 108  
 Fort Worth, TX 76155  
 (817) 545-0891  
 Engineers, Architects and Planners



# ADDISON AIRPORT

## WEST TAXIWAY "B" & DRAINAGE IMPROVEMENTS GRADING PLAN