



MATCH LINE STA. 241+00 SEE SHEET NO.17

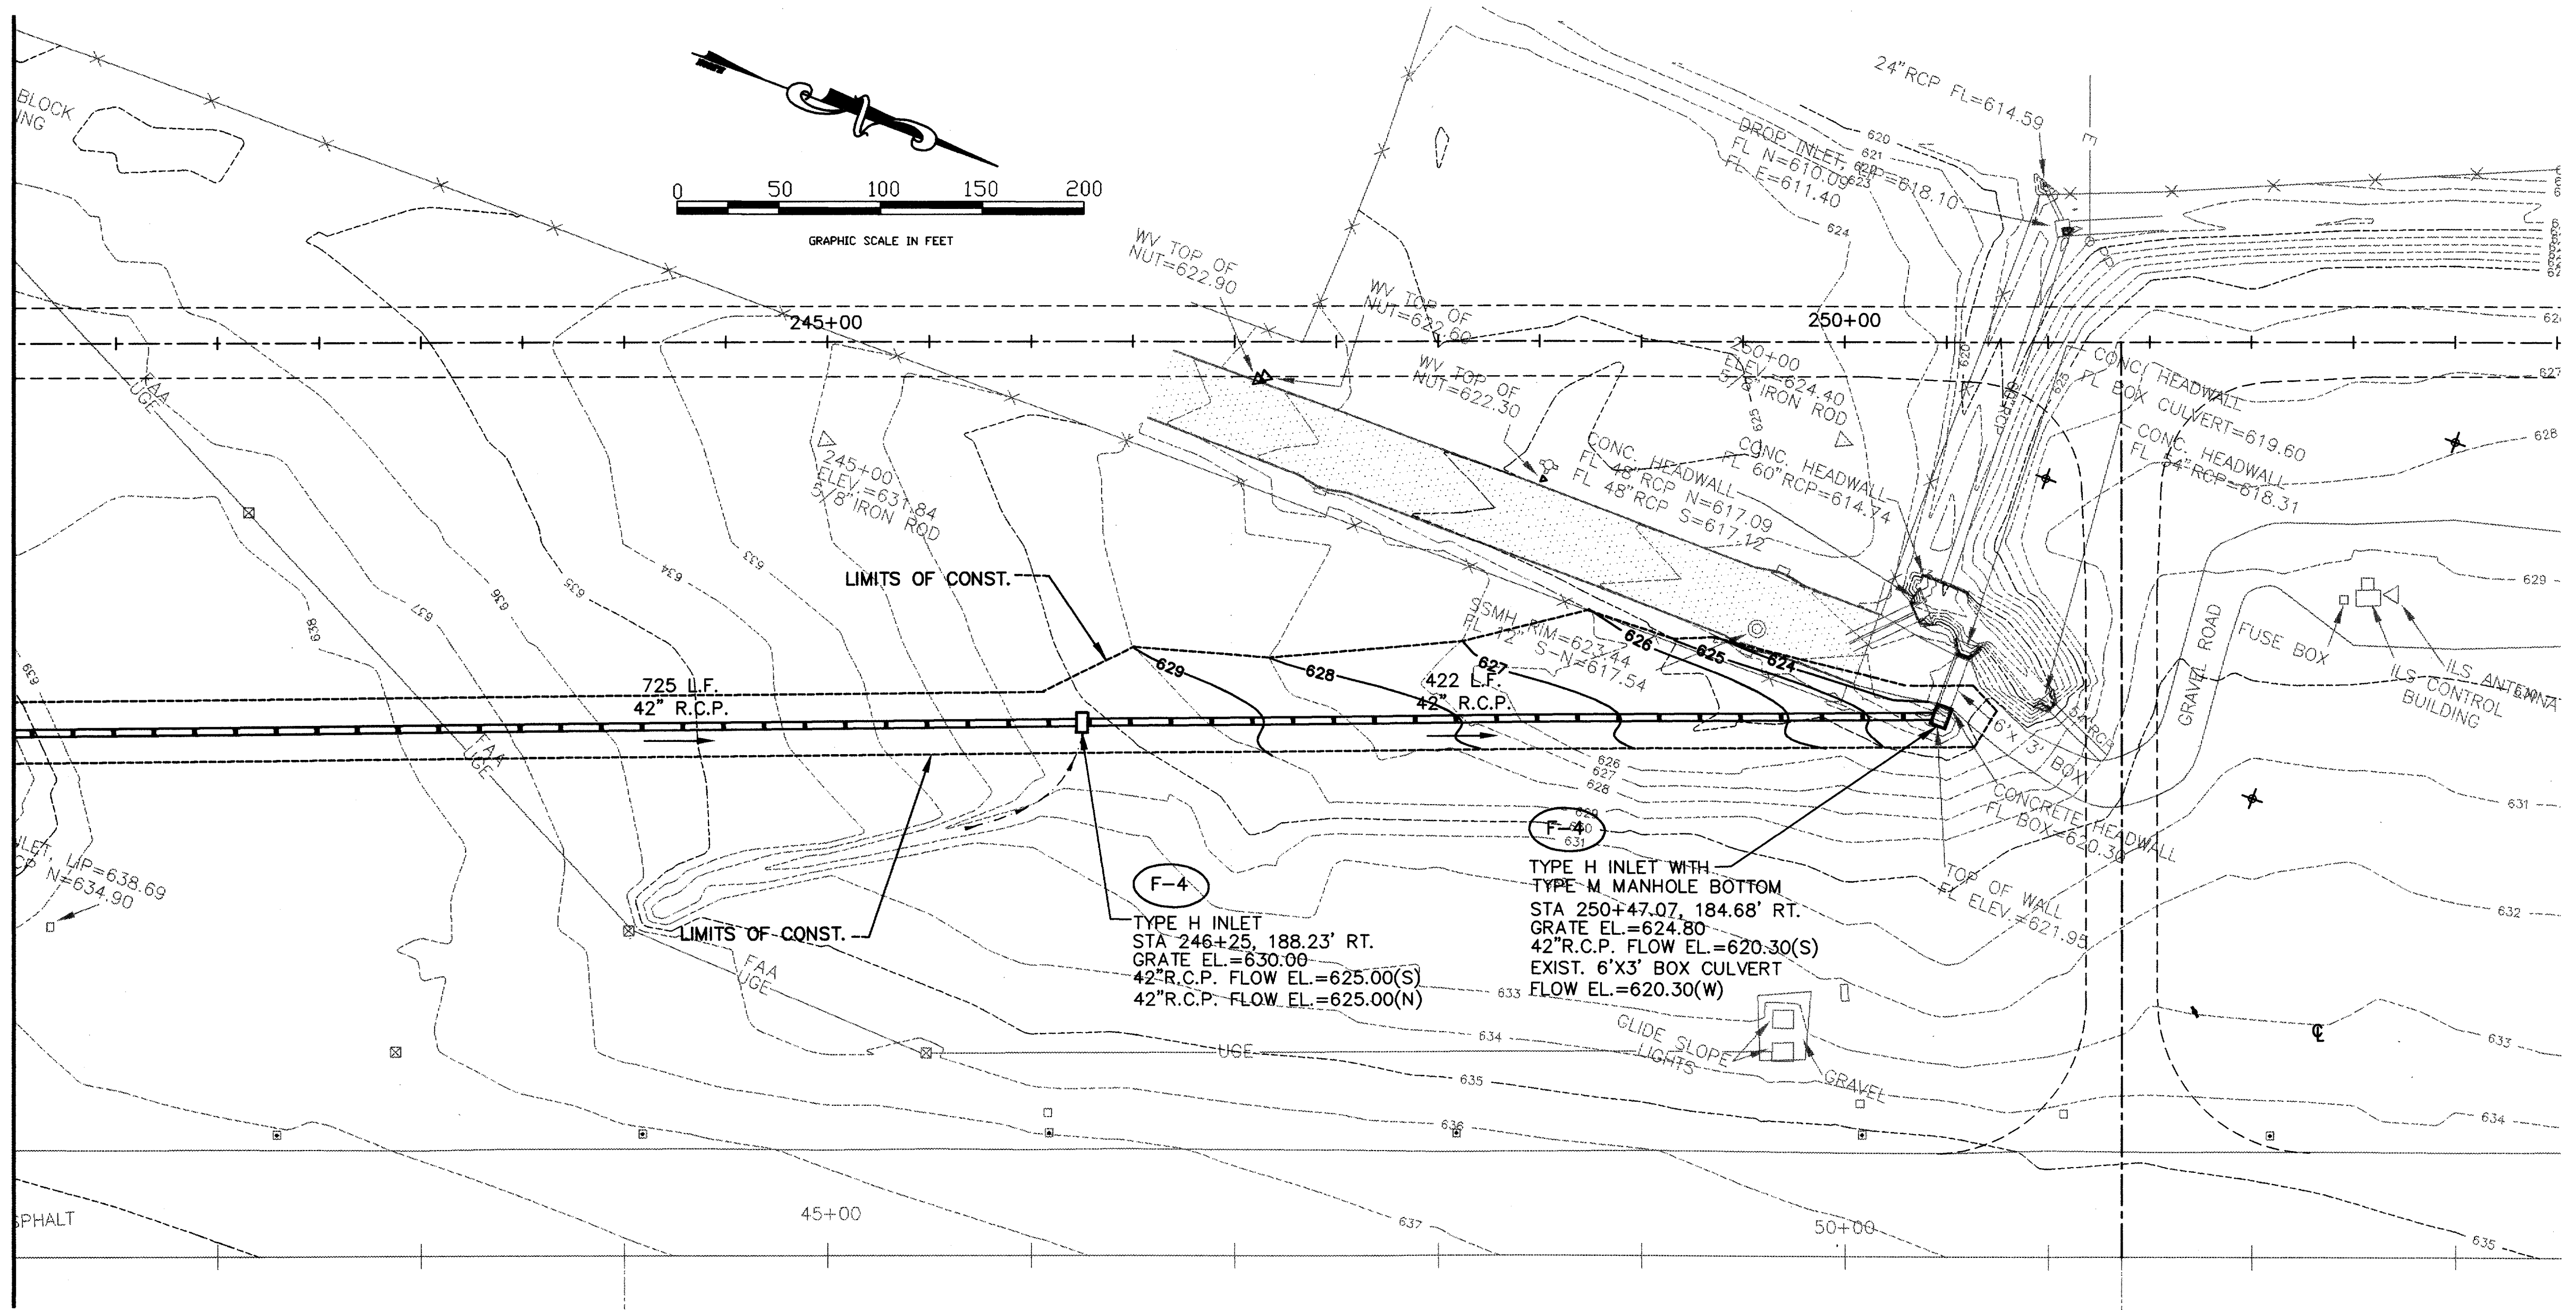

MATCH LINE

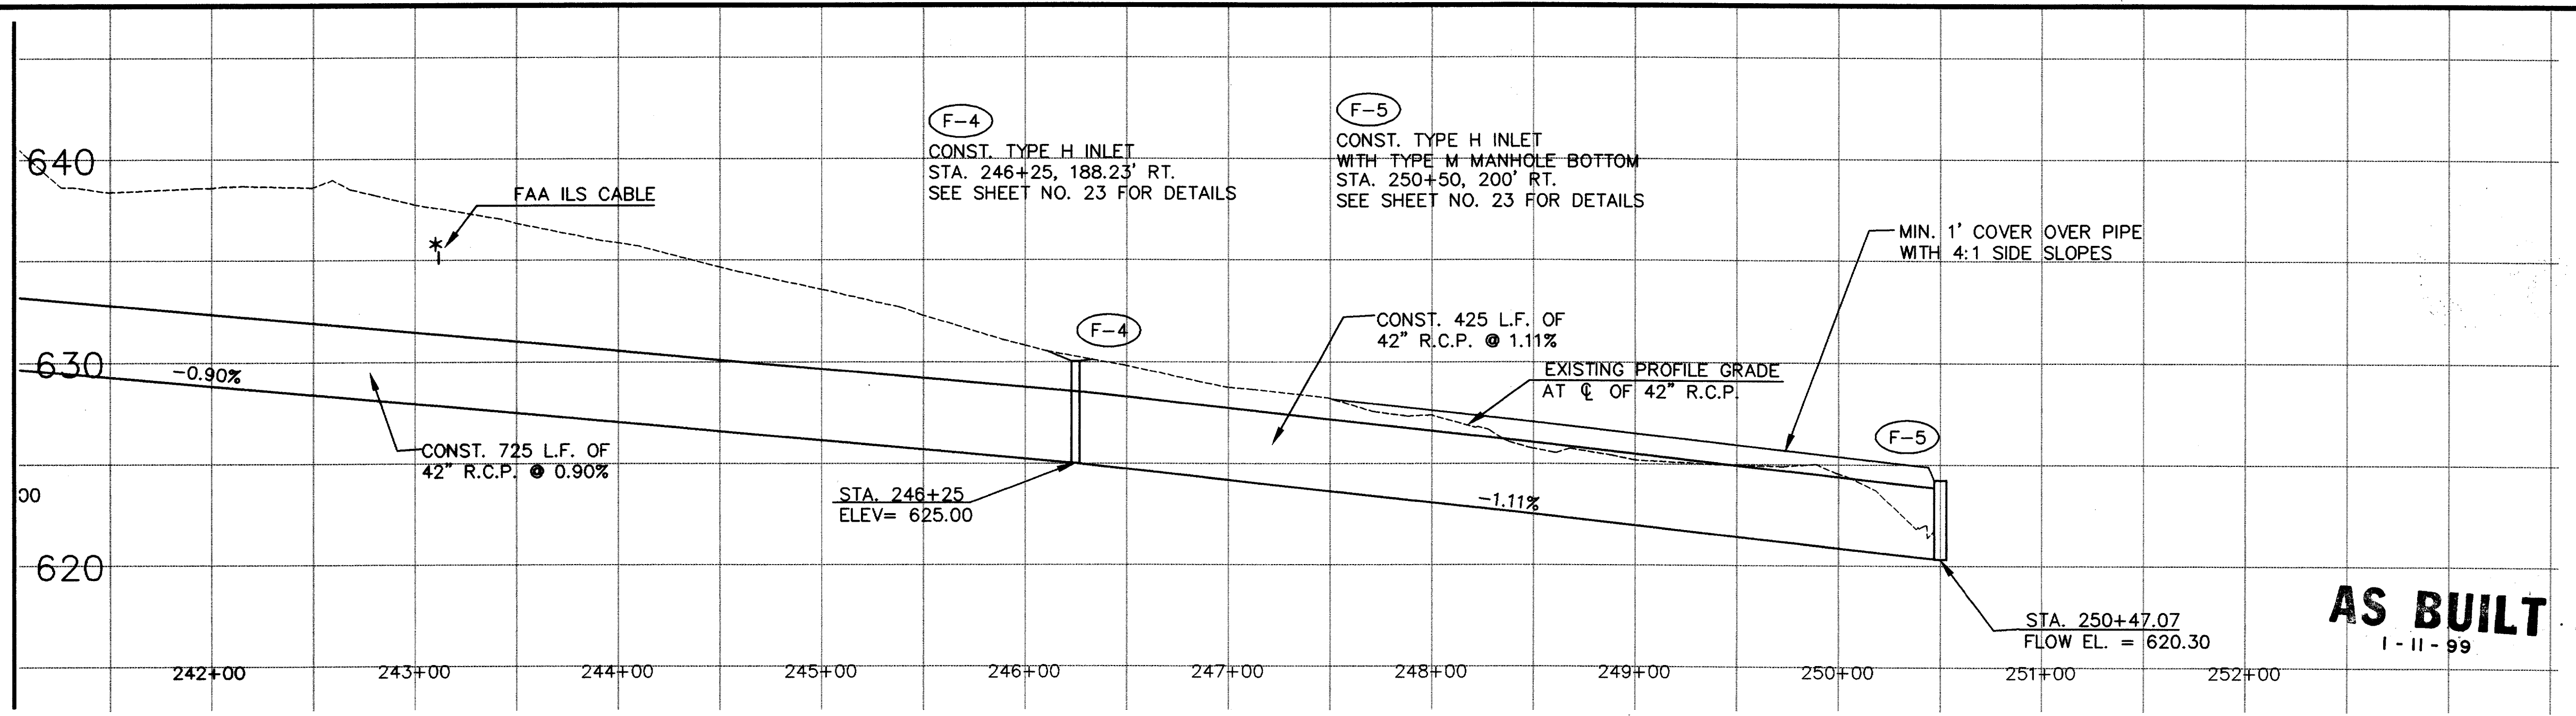

AS BUILT
1-11-99



DESIGN: T.L.T.	TXDOT NO: 9842 ADDSN	DATE: _____	BY: _____
DRAWN: M.J.G.	REV. NO.: 04	DATE: _____	BY: _____
CHECKED: R.T.B.	JOB NO.: F708024.80	DATE: _____	BY: _____
SCALE: 1"=50'		DATE: _____	BY: _____

URS Greiner
4100 Arzen Center Blvd., Suite 108
Ft. Worth, TX 76156
(817) 545-0891

Engineers, Architects
and Planners

ADDISON AIRPORT

**WEST TAXIWAY "B" & DRAINAGE IMPROVEMENTS
GRADING PLAN**