



TYPICAL INLET GRADING DETAILS

N.T.S.

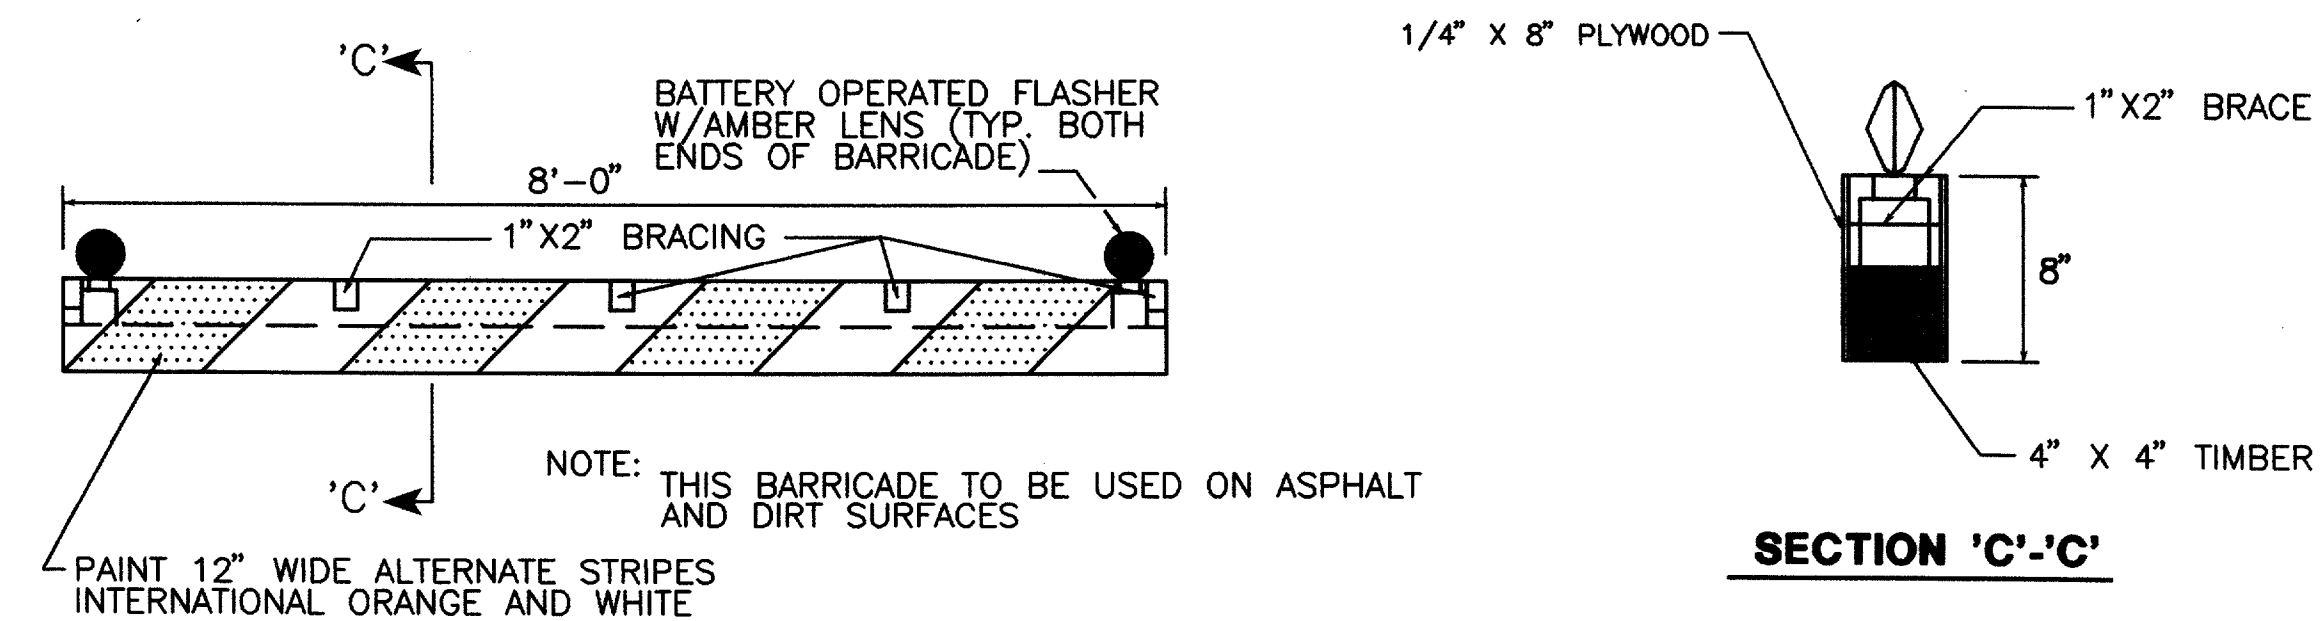

TIMBER BARRICADE (TYPE "A")

N.T.S.

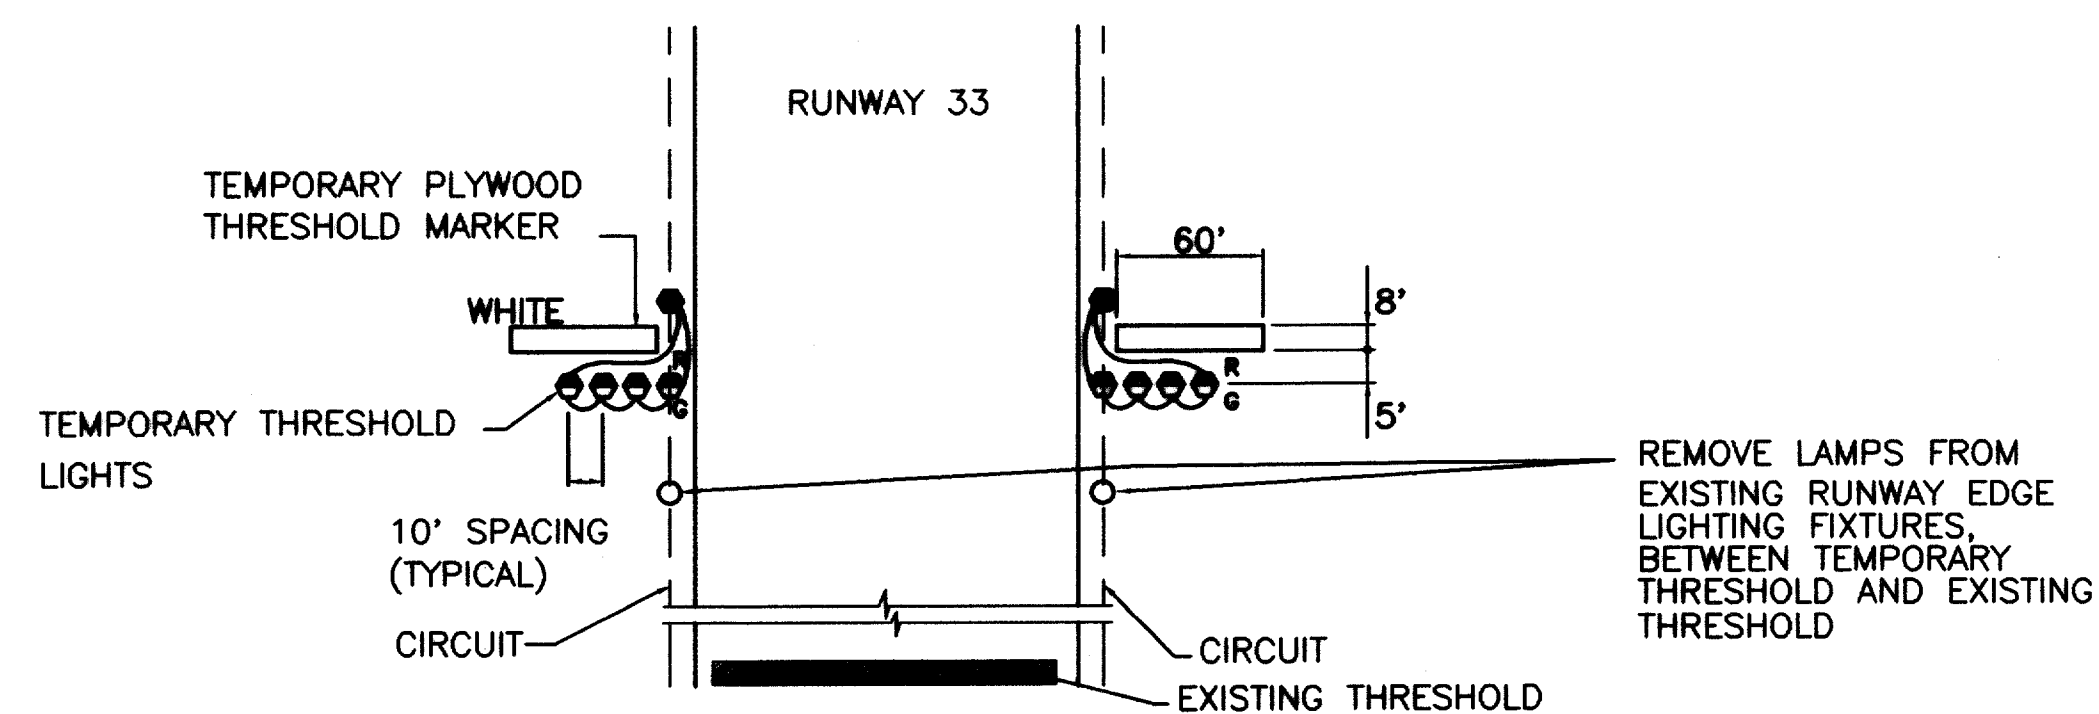


TEMPORARY DISPLACED THRESHOLD

N.T.S.

NOTES:

- TEMPORARY DISPLACED THRESHOLD SHALL BE PLACED AT THE LOCATION SHOWN ON THE PLANS AND SHALL INCLUDE TEMPORARY THRESHOLD LIGHTS (8 L-862, SPLIT LENS, RED/GREEN), (2) WHITE TEMPORARY PLYWOOD THRESHOLD MARKERS (8' X 60") AND TEMPORARY LIGHT CIRCUITS. EXISTING RUNWAY THRESHOLD LIGHTS MAY BE USED. THE COST OF INSTALLING, MAINTAINING AND REMOVING OF THE TEMPORARY DISPLACED THRESHOLD IS INCIDENTAL TO THE PROJECT.


- MARKING FOR TEMPORARY DISPLACING THRESHOLD R/W 33 INCLUDES OUTBOARD THRESHOLD MARKERS.

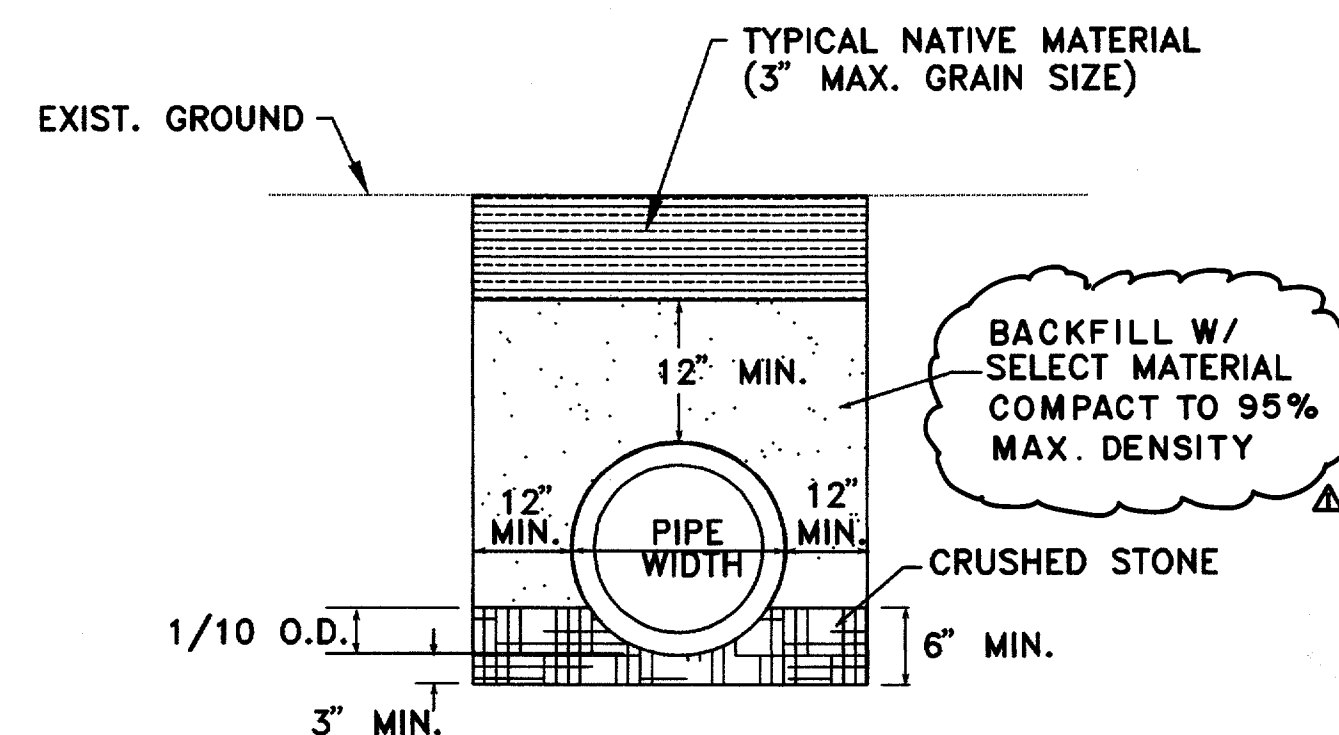

**EMBEDMENT DETAIL FOR STORM SEWER
DETAIL NO. 1**

N.T.S.

1"X19" DOWEL @ 12" O.C. (TYP.)
DRILL AND EPOXY INTO EXIST.
CONC. PAVEMENT
DO NOT PLACE CLOSER THAN
15" TO TRANSVERSE JOINT.

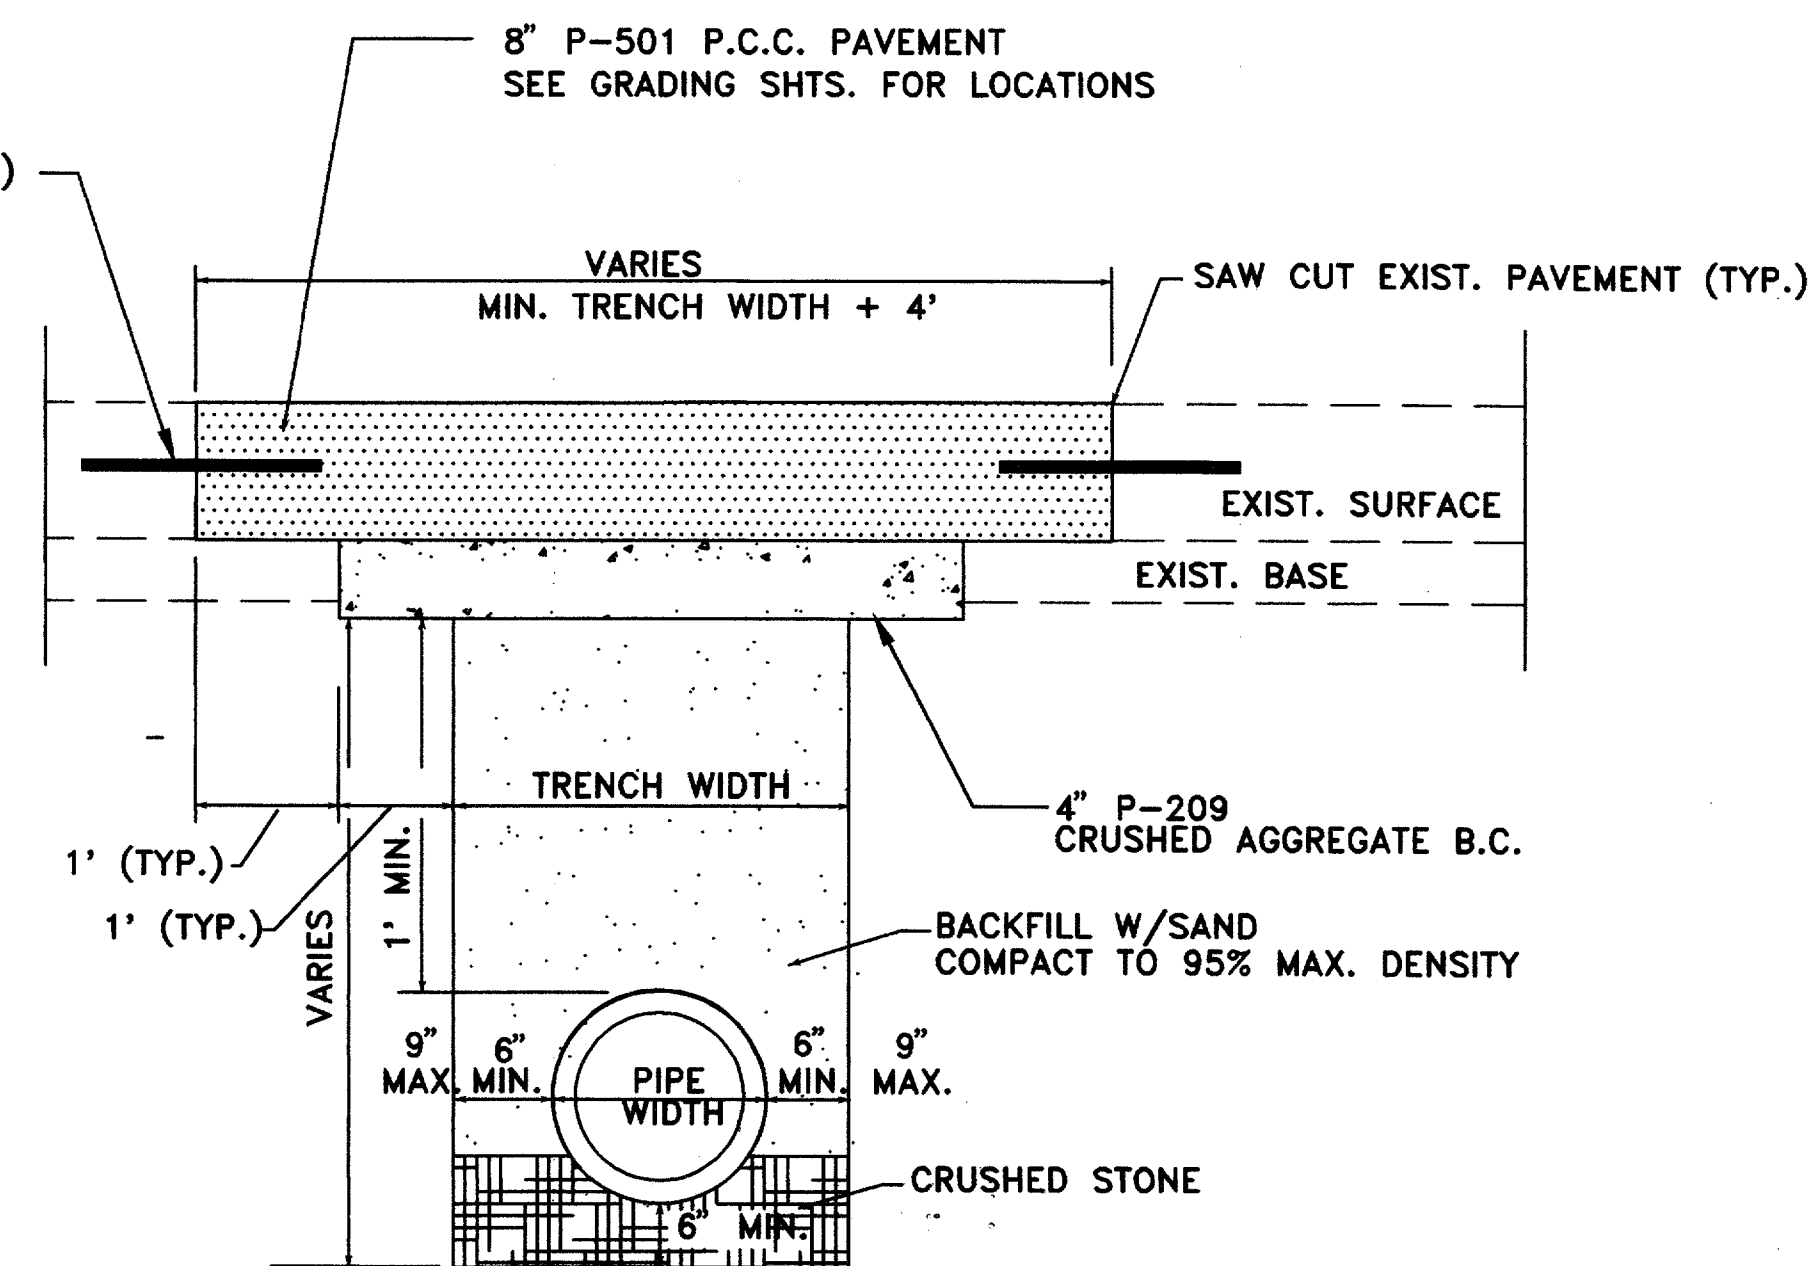


- NOTES:**
- ALL EXIST. MARKINGS SHALL BE REPLACED UPON COMPLETION OF PAVING OPERATIONS (NO DIRECT PAY)

- COST FOR EARTHWORK (EXCAVATION) ASSOCIATED WITH PIPE TRENCH SHALL BE INCIDENTAL TO THE PRICE OF THE PIPE.

**PAVEMENT REPLACEMENT DETAIL
DETAIL NO. 2**

N.T.S.

AS BUILT
1-11-99

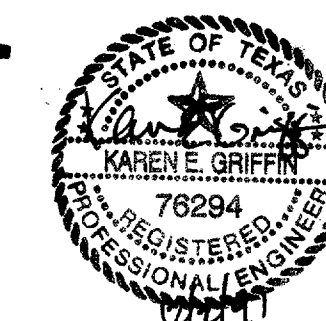

DESIGN: T.L.T.	TXJOB NO. 9842 ADDSN	1-11-99 06-Built
DRAWN: J.R.H.	3113 NO. 98-04	
CHECKED: R.L.B.	JOB NO. #708024.80	
SCALE: N.T.S.		

URS Greiner
4100 Arson Carter Blvd., Suite 108
Fort Worth, TX 76155
(817) 545-0891

Engineers, Architects
and Planners



ADDISON AIRPORT

MISCELLANEOUS DETAILS

SHEET
22

DATE: DEC. 1997