


**LEGEND**

- WATER LINES ————
- SANITARY SEWER LINES - - - - -
- LONE STAR GAS LINES ————
- CABLE TV LINES ————
- UNDERGROUND POWER — UC — UC —

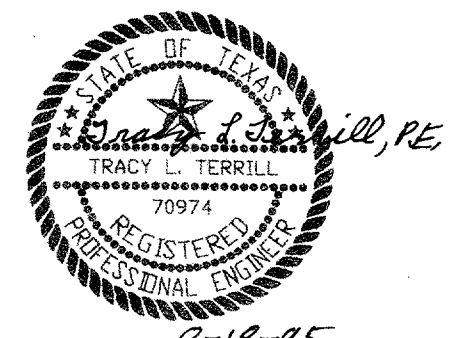

**AS BUILT**  
 1-11-99

THE SEAL APPEARING ON THIS DOCUMENT WAS AUTHORIZED BY TRACY L. TERRILL, P.E. 70974, ON AUGUST, 1995.

DESIGN: T.L.T.	TXDOT NO. 9842 ADDSN		
DRAWN: E.J.O.	REV. NO. 3-12-0069-97		
CHECKED: R.I.B.	BID NO. 66-17 98-04		
SCALE: 1"=400'	JOB NO. E708024.70	Date	Revisions
			By

**Greiner, Inc.**  
 Greiner, Inc.  
 Fort Worth, Texas

Engineers, Architects  
 and Planners

**ADDISON AIRPORT**

UTILITY PLAN

SHEET **30**  
 DATE: AUG. 1995