


MATCH LINE SEE BELOW



MATCH LINE SEE ABOVE

**AS BUILT**  
1-11-99

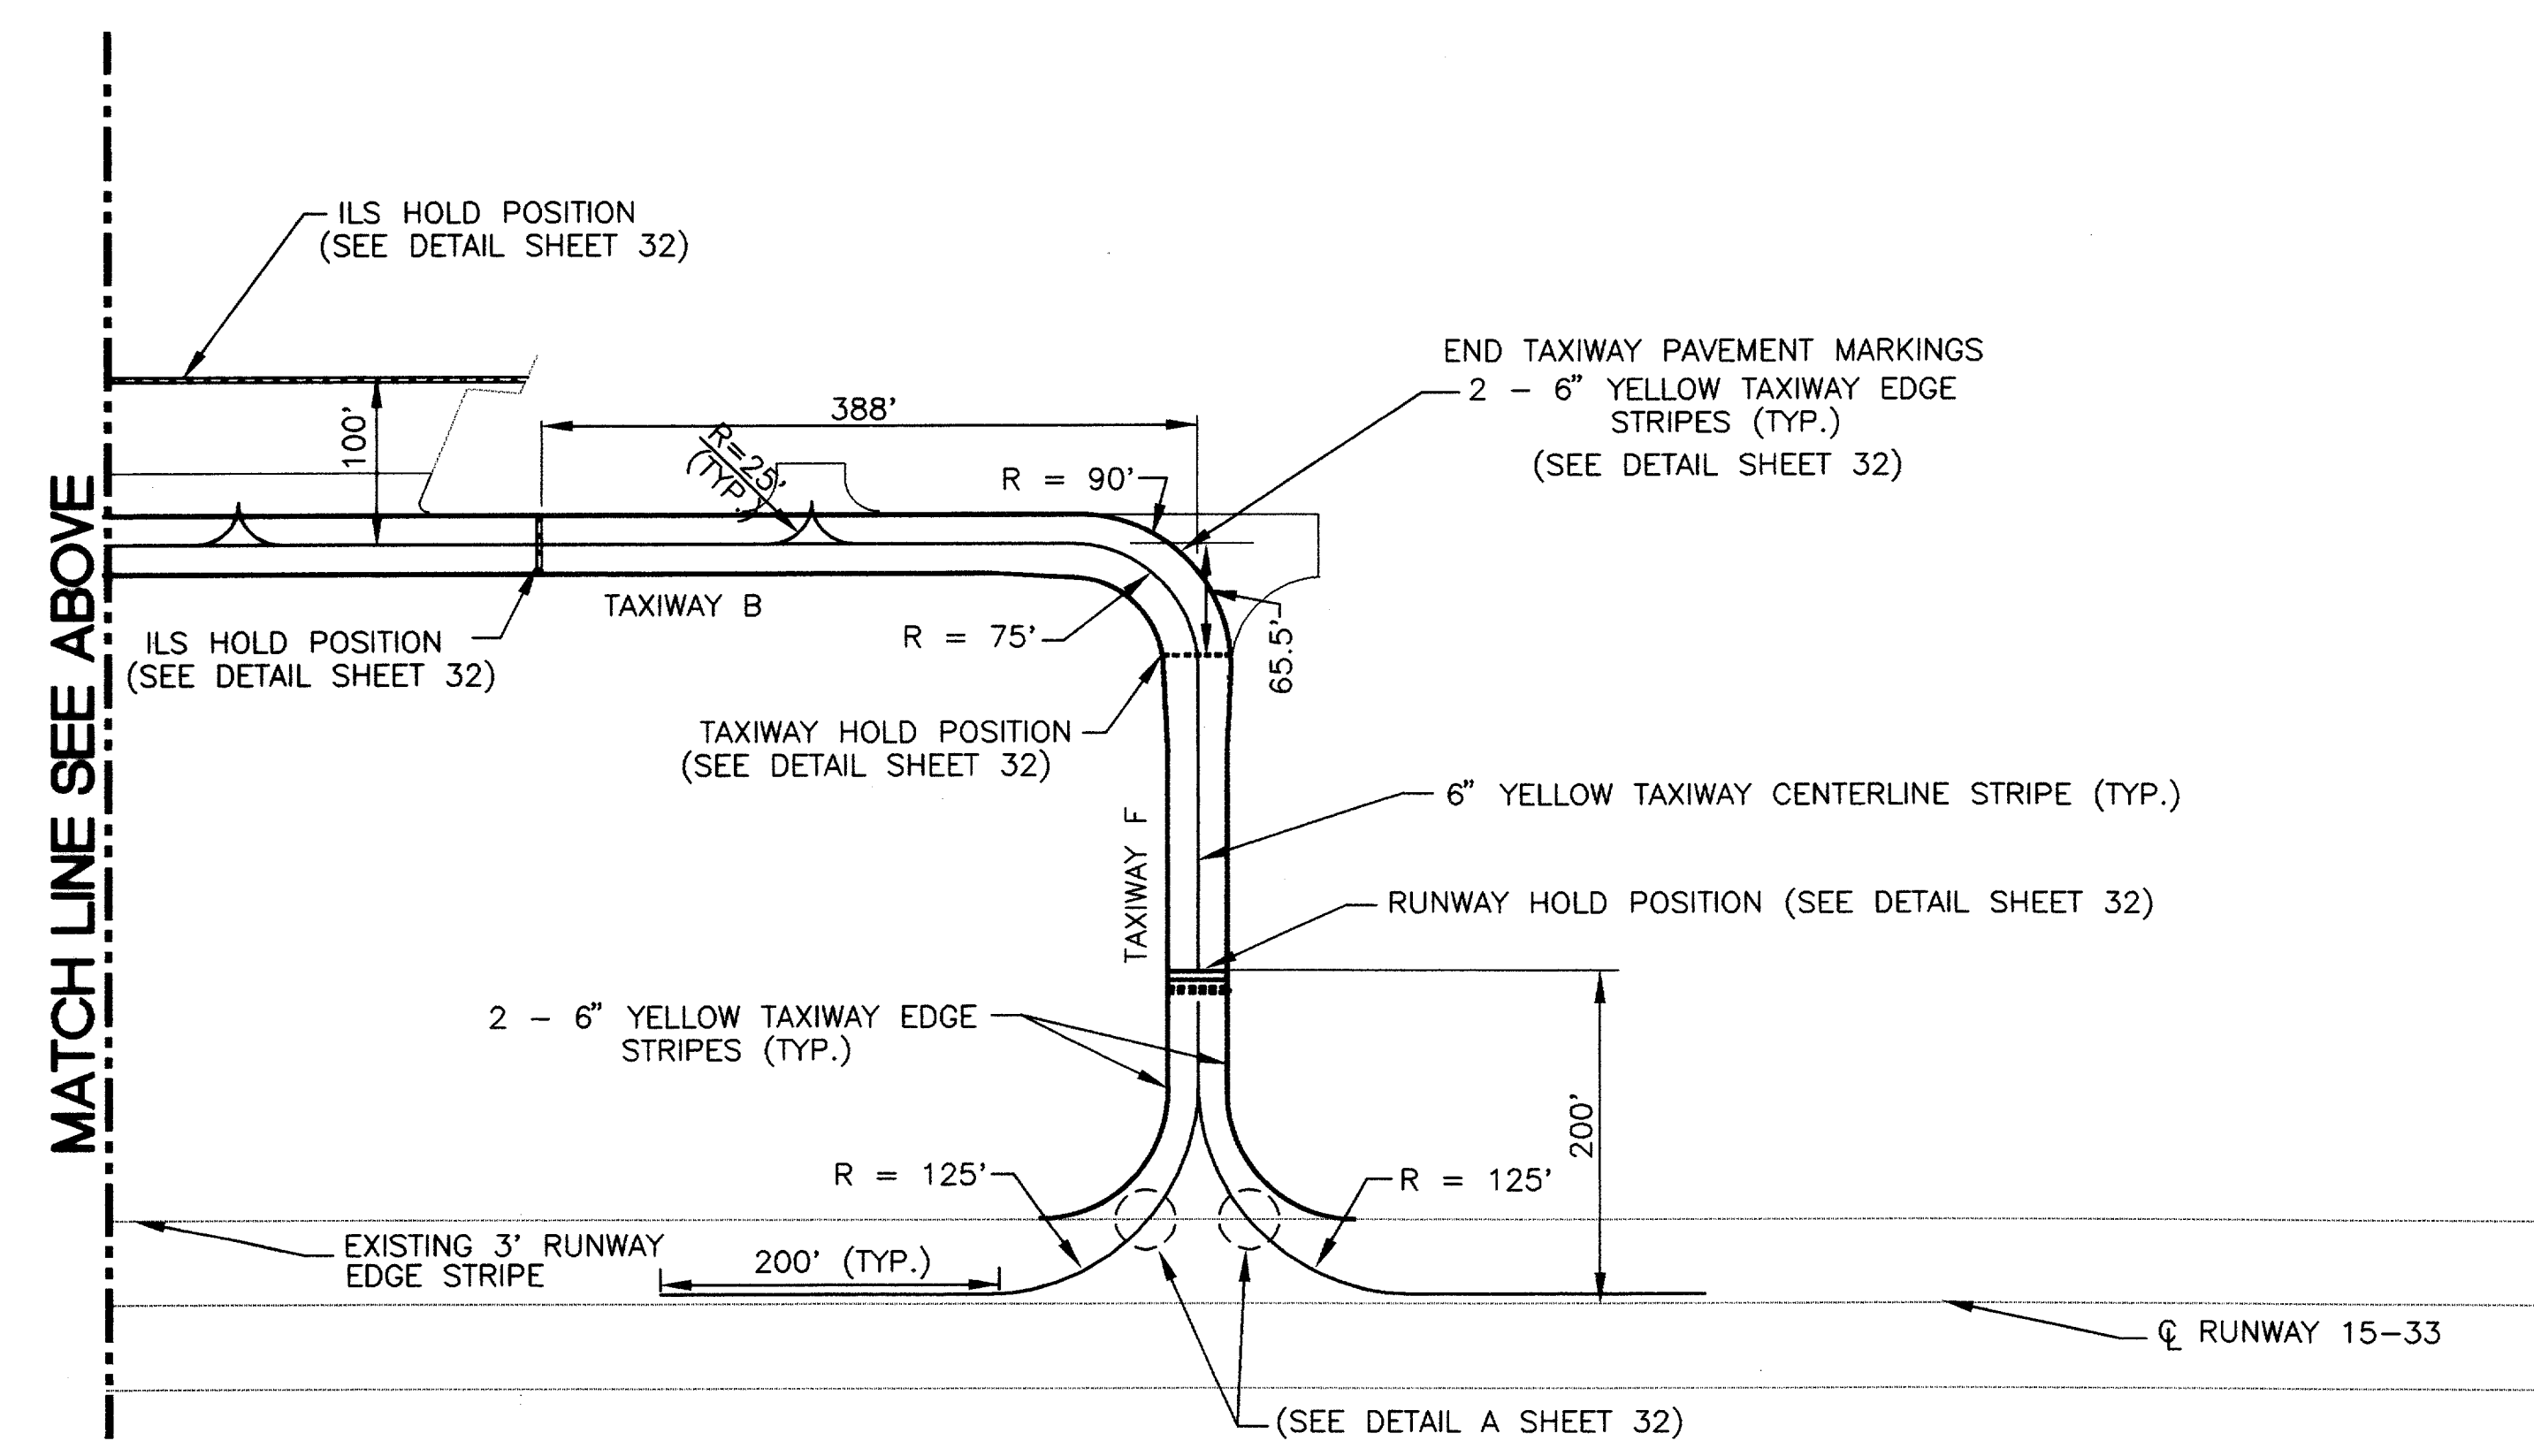

DESIGN: T.L.T.	TXDOT NO: 9842 ADDSN	1-11-99	as built A	MG
DRAWN: J.R.H.	BID NO: 98-04			
CHECKED: R.L.B.	JOB NO: E708024.80	Date	Revisions	By
SCALE: 1"=100'				

**URS Greiner**  
4100 Amon Carter Blvd., Suite 108  
Fort Worth, TX 76155  
(817) 545-0891  
Engineers, Architects  
and Planners

**ADDISON AIRPORT**

PAVEMENT MARKING PLAN  
SHEET 31  
DATE: DEC, 1997