




SECTION

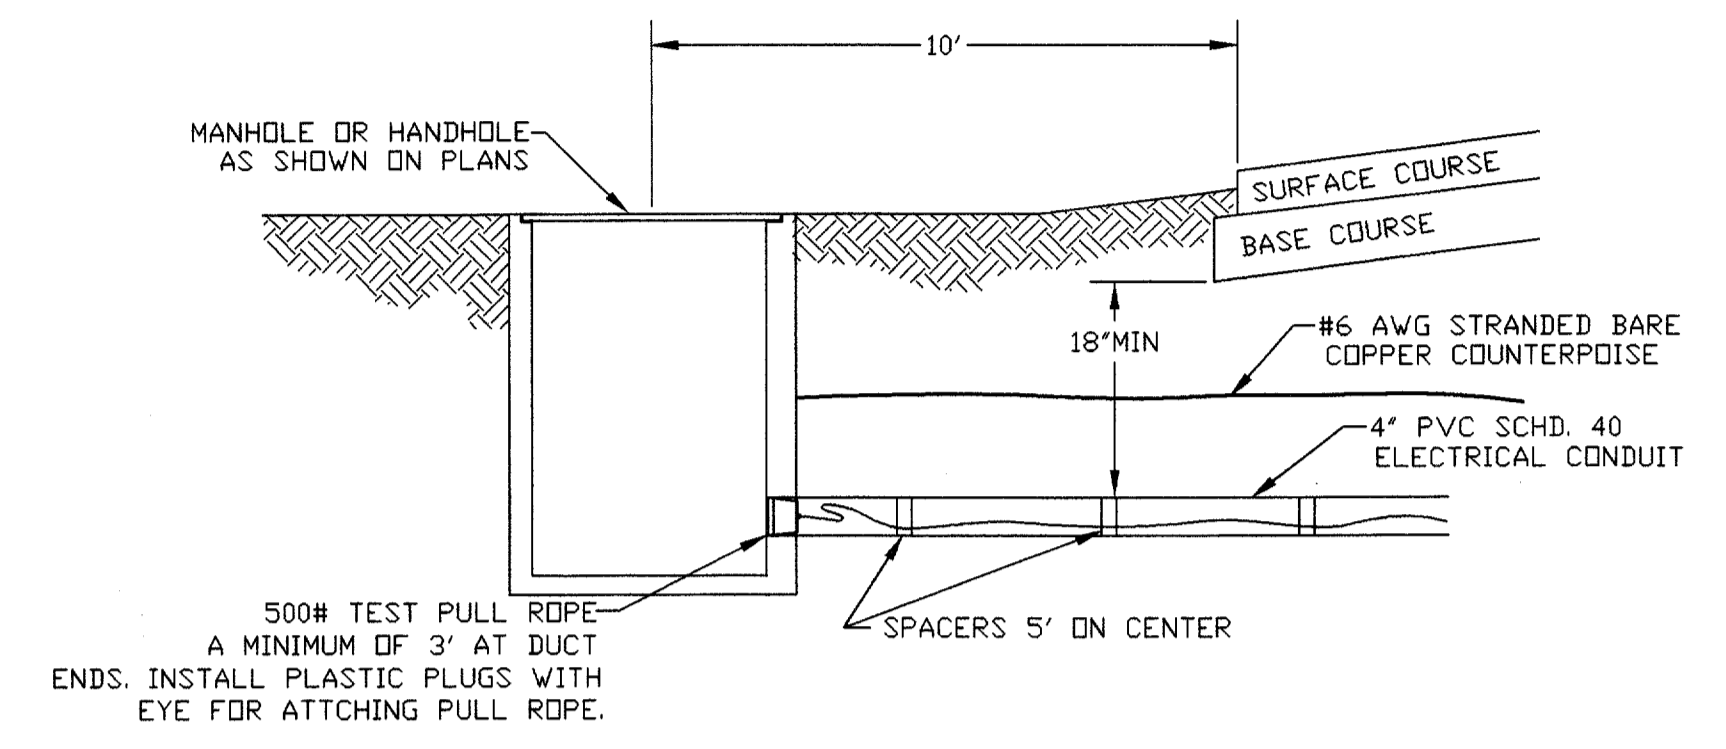


ELEVATION  
UNDERGROUND ELECTRICAL DUCT  
NTS

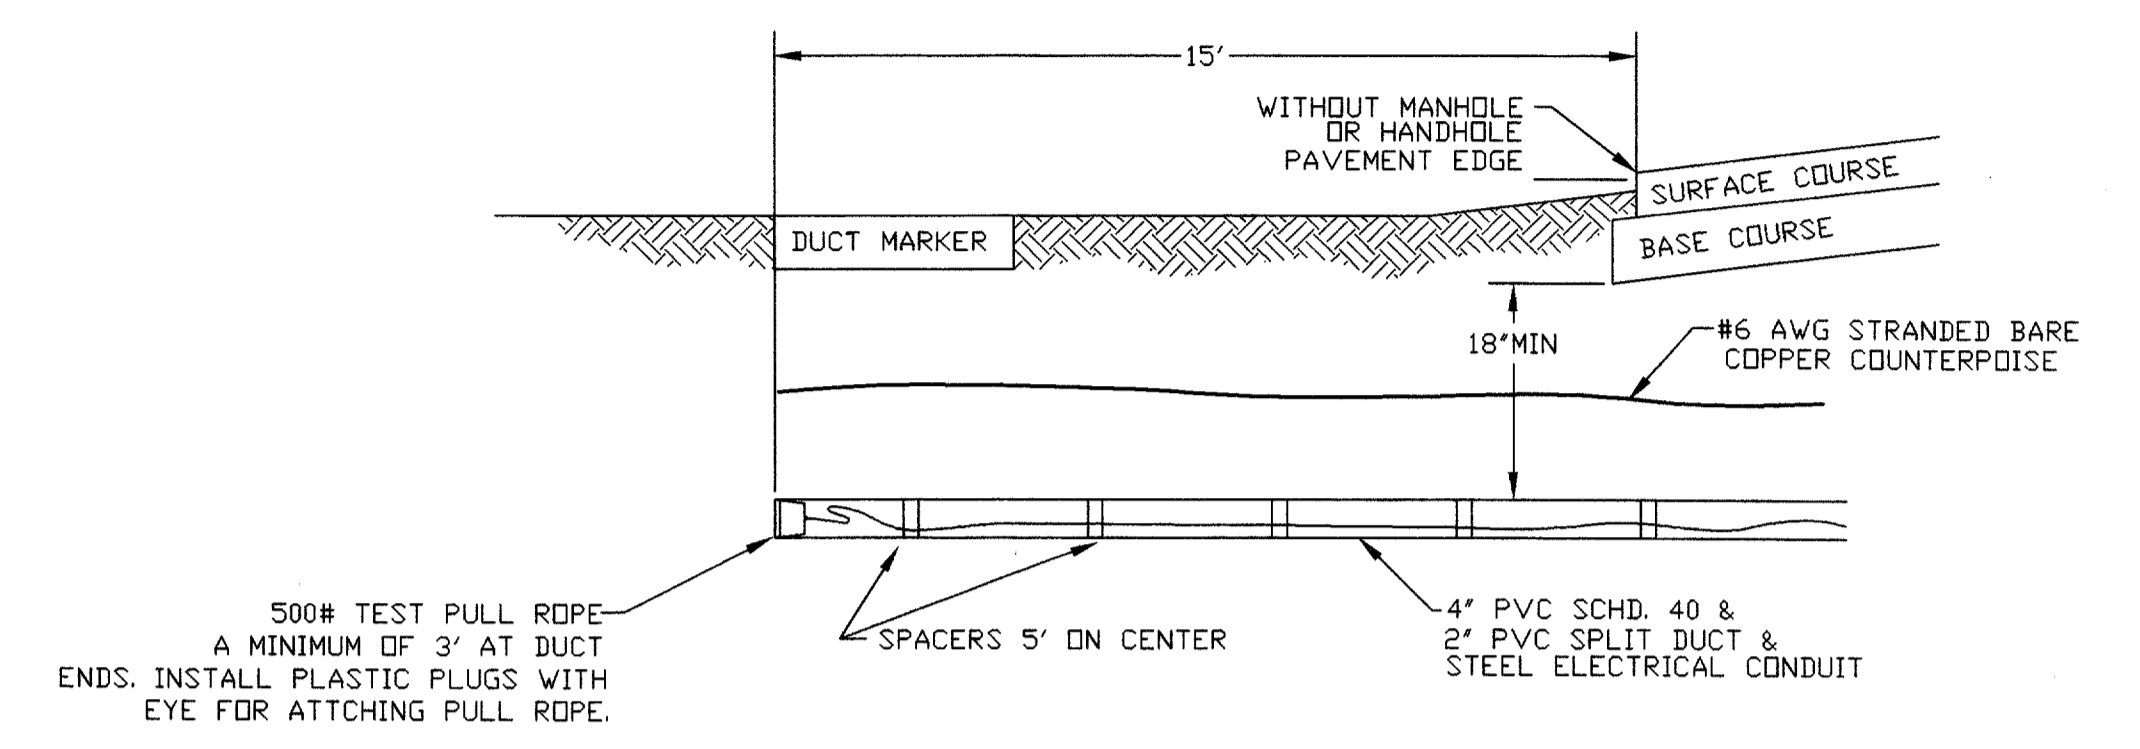


ELEVATION  
UNDERGROUND FAA DUCT  
NTS  
NOTE: SEE CONDUIT & DUCT DETAIL SHEET.

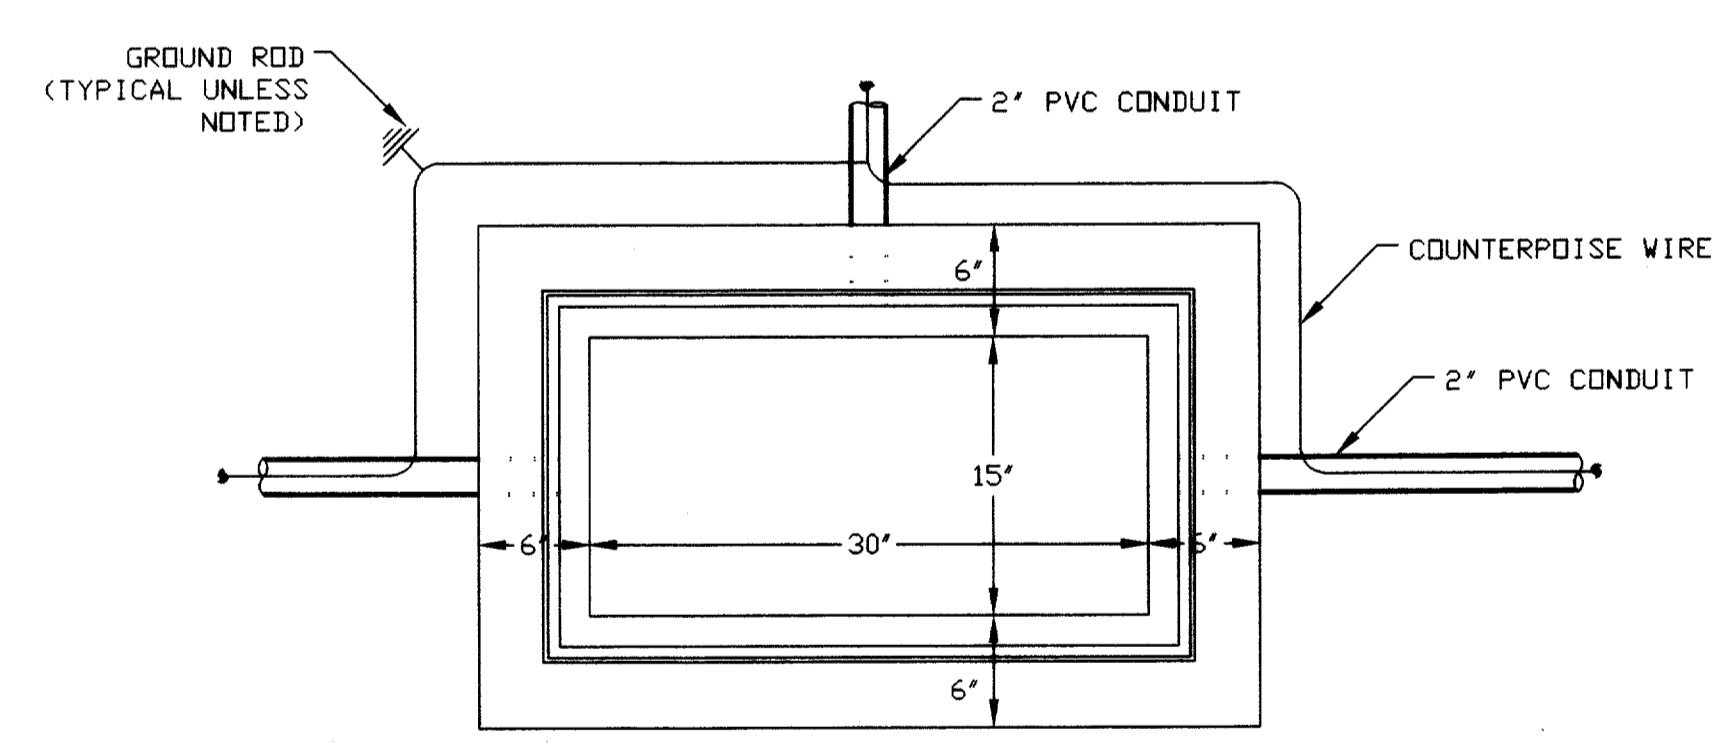


PLAN VIEW  
CONCRETE HANDHOLE DETAILS  
NTS

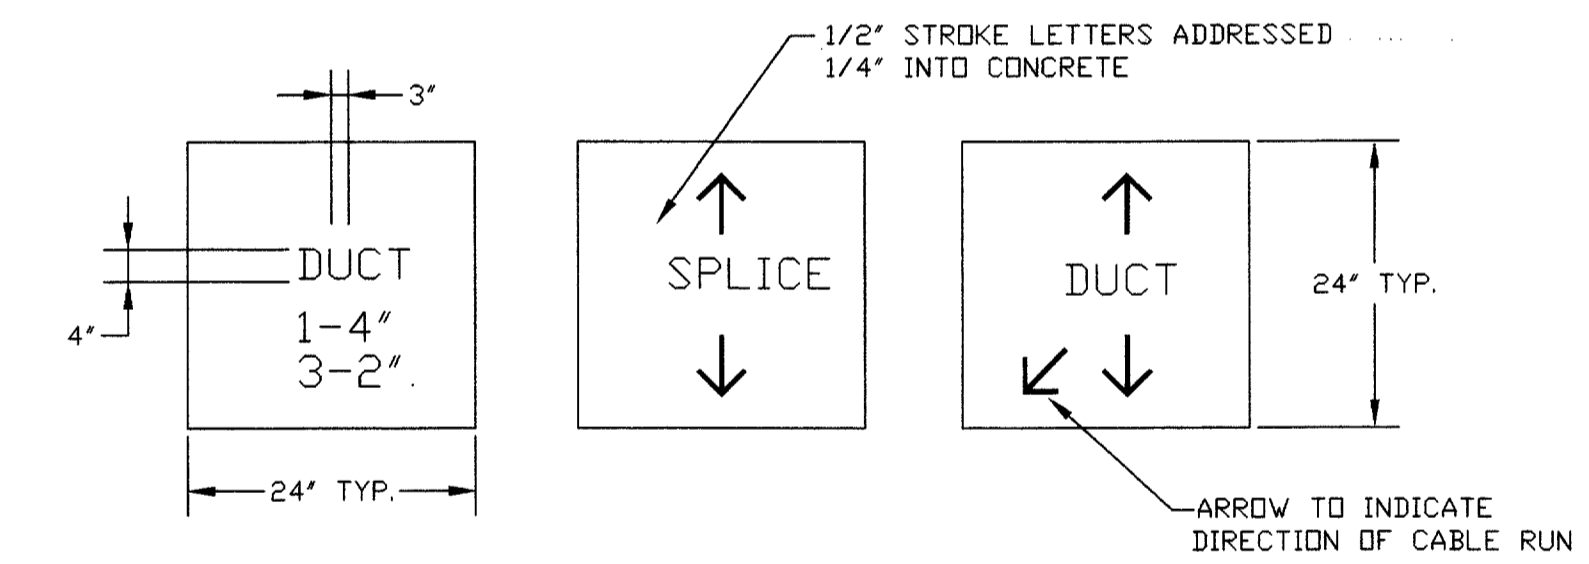

PLAN VIEWS

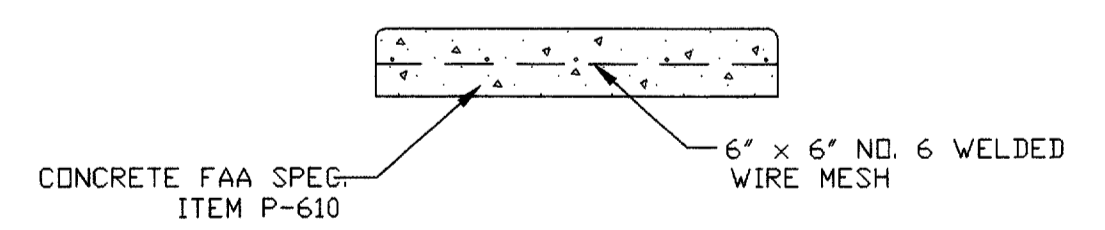

SECTION VIEW  
CABLE AND DUCT MARKER  
NTS

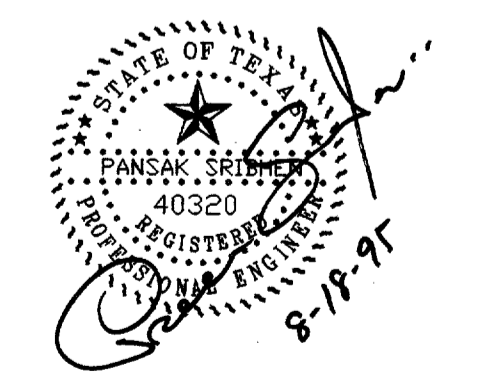

**AS BUILT**  
1-11-99

DESIGN: <b>R.V.C.</b>	TXDOT NO. 9842 ADDSN	Date	Revisions	By
DRAWN: <b>MIR</b>	2-19-9962-06			
CHECKED: <b>P.S.A.</b>	BID NO. 98-04			
SCALE: 1"=50'	JOB NO. Y8024.60			

**Greiner, Inc.**  
Greiner, Inc.  
Fort Worth, Texas

**ASA**  
ENGINEERING  
DALLAS, TEXAS 75287



**ADDISON AIRPORT**

**TAXIWAY "B" LIGHTING  
HANDHOLE DETAIL**

**SHEET 40**  
DATE: AUG 1995