


**AS BUILT**  
1 - 11 - 99

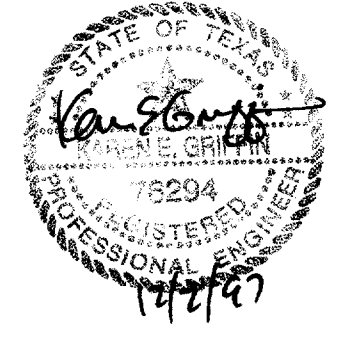

DESIGN: **F.L.T.**  
DRAWN: **M.J.C.**  
CHECKED: **R.T.B.**  
SCALE: 1" = 50'  
1" = 5' VERT.

TXDOT NO: <b>9842 ADDSN</b>	Date
SIB NO: <b>98-04</b>	Revisions
JOB NO: <b>E708024.80</b>	By

**URS Greiner**  
4100 Amon Carter Blvd., Suite 108  
Fort Worth, TX 76155  
(817) 545-0891  
Engineers, Architects  
and Planners



**ADDISON AIRPORT**

**WEST TAXIWAY "B" & DRAINAGE IMPROVEMENTS  
TAXIWAY B CROSS SECTIONS**