



**AS BUILT**  
1-11-99

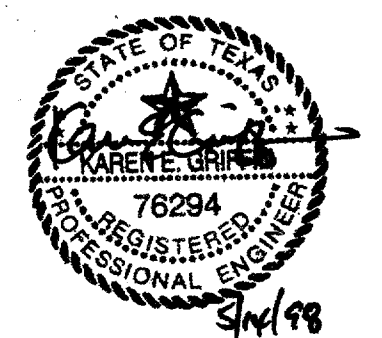

DESIGN: <b>T.L.T.</b>	TXDOT NO: <b>9842 ADDSN</b>	DATE: _____	BY: _____
DRAWN: <b>M.J.C.</b>	IND NO: <b>98-04</b>	DATE: _____	BY: _____
CHECKED: <b>R.L.B.</b>	JOB NO: <b>E708024.80</b>	DATE: _____	BY: _____
SCALE: <b>1"=50'</b> <b>1"=5' VERT.</b>		DATE: _____	BY: _____

**URS Greiner**  
4100 Amon Carter Blvd., Suite 108  
Fort Worth, TX 76155  
(817) 545-0891

Engineers, Architects  
and Planners

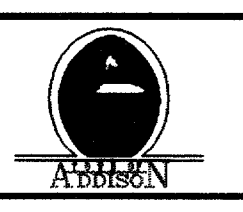

**ADDISON AIRPORT**

**WEST TAXIWAY "B" & DRAINAGE IMPROVEMENTS  
TAXIWAY B CROSS SECTIONS**