


* IF CONCRETE PAVEMENT ALTERNATIVE IS CHOSEN SUBSTITUTE TxDOT 340 TYPE D FOR P-401

AS BUILT
1-11-99

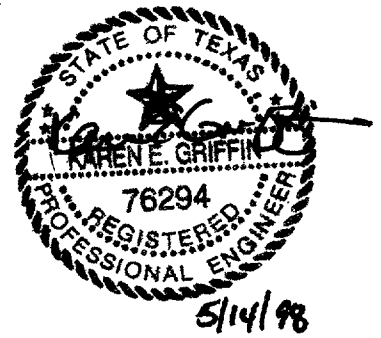

DESIGN: T.L.T.
DRAWN: M.J.G.
CHECKED: R.B.
SCALE: HORIZ. 1"=50'
VERT. 1"=5'


TxDOT NO. 9842 ADDSN
BID NO. 98-04
JOB NO. E708024.80

5/15/98
Date

No.	Description	By

URS Greiner
4100 Arnon Corlier Blvd., Suite 108
Ft. Worth, TX 76155
(817) 545-0891

Engineers, Architects
and Planners

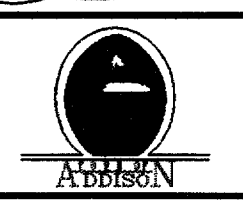

ADDISON AIRPORT

**WEST TAXIWAY "B" & DRAINAGE IMPROVEMENTS
TAXIWAY E CROSS SECTIONS**

SHEET 51
DATE: DEC. 1997