


TOWN OF ADDISON, TEXAS

CONSTRUCTION PLANS FOR

ADDISON AIRPORT

SANITARY SEWER & WATER MAIN REPLACEMENT

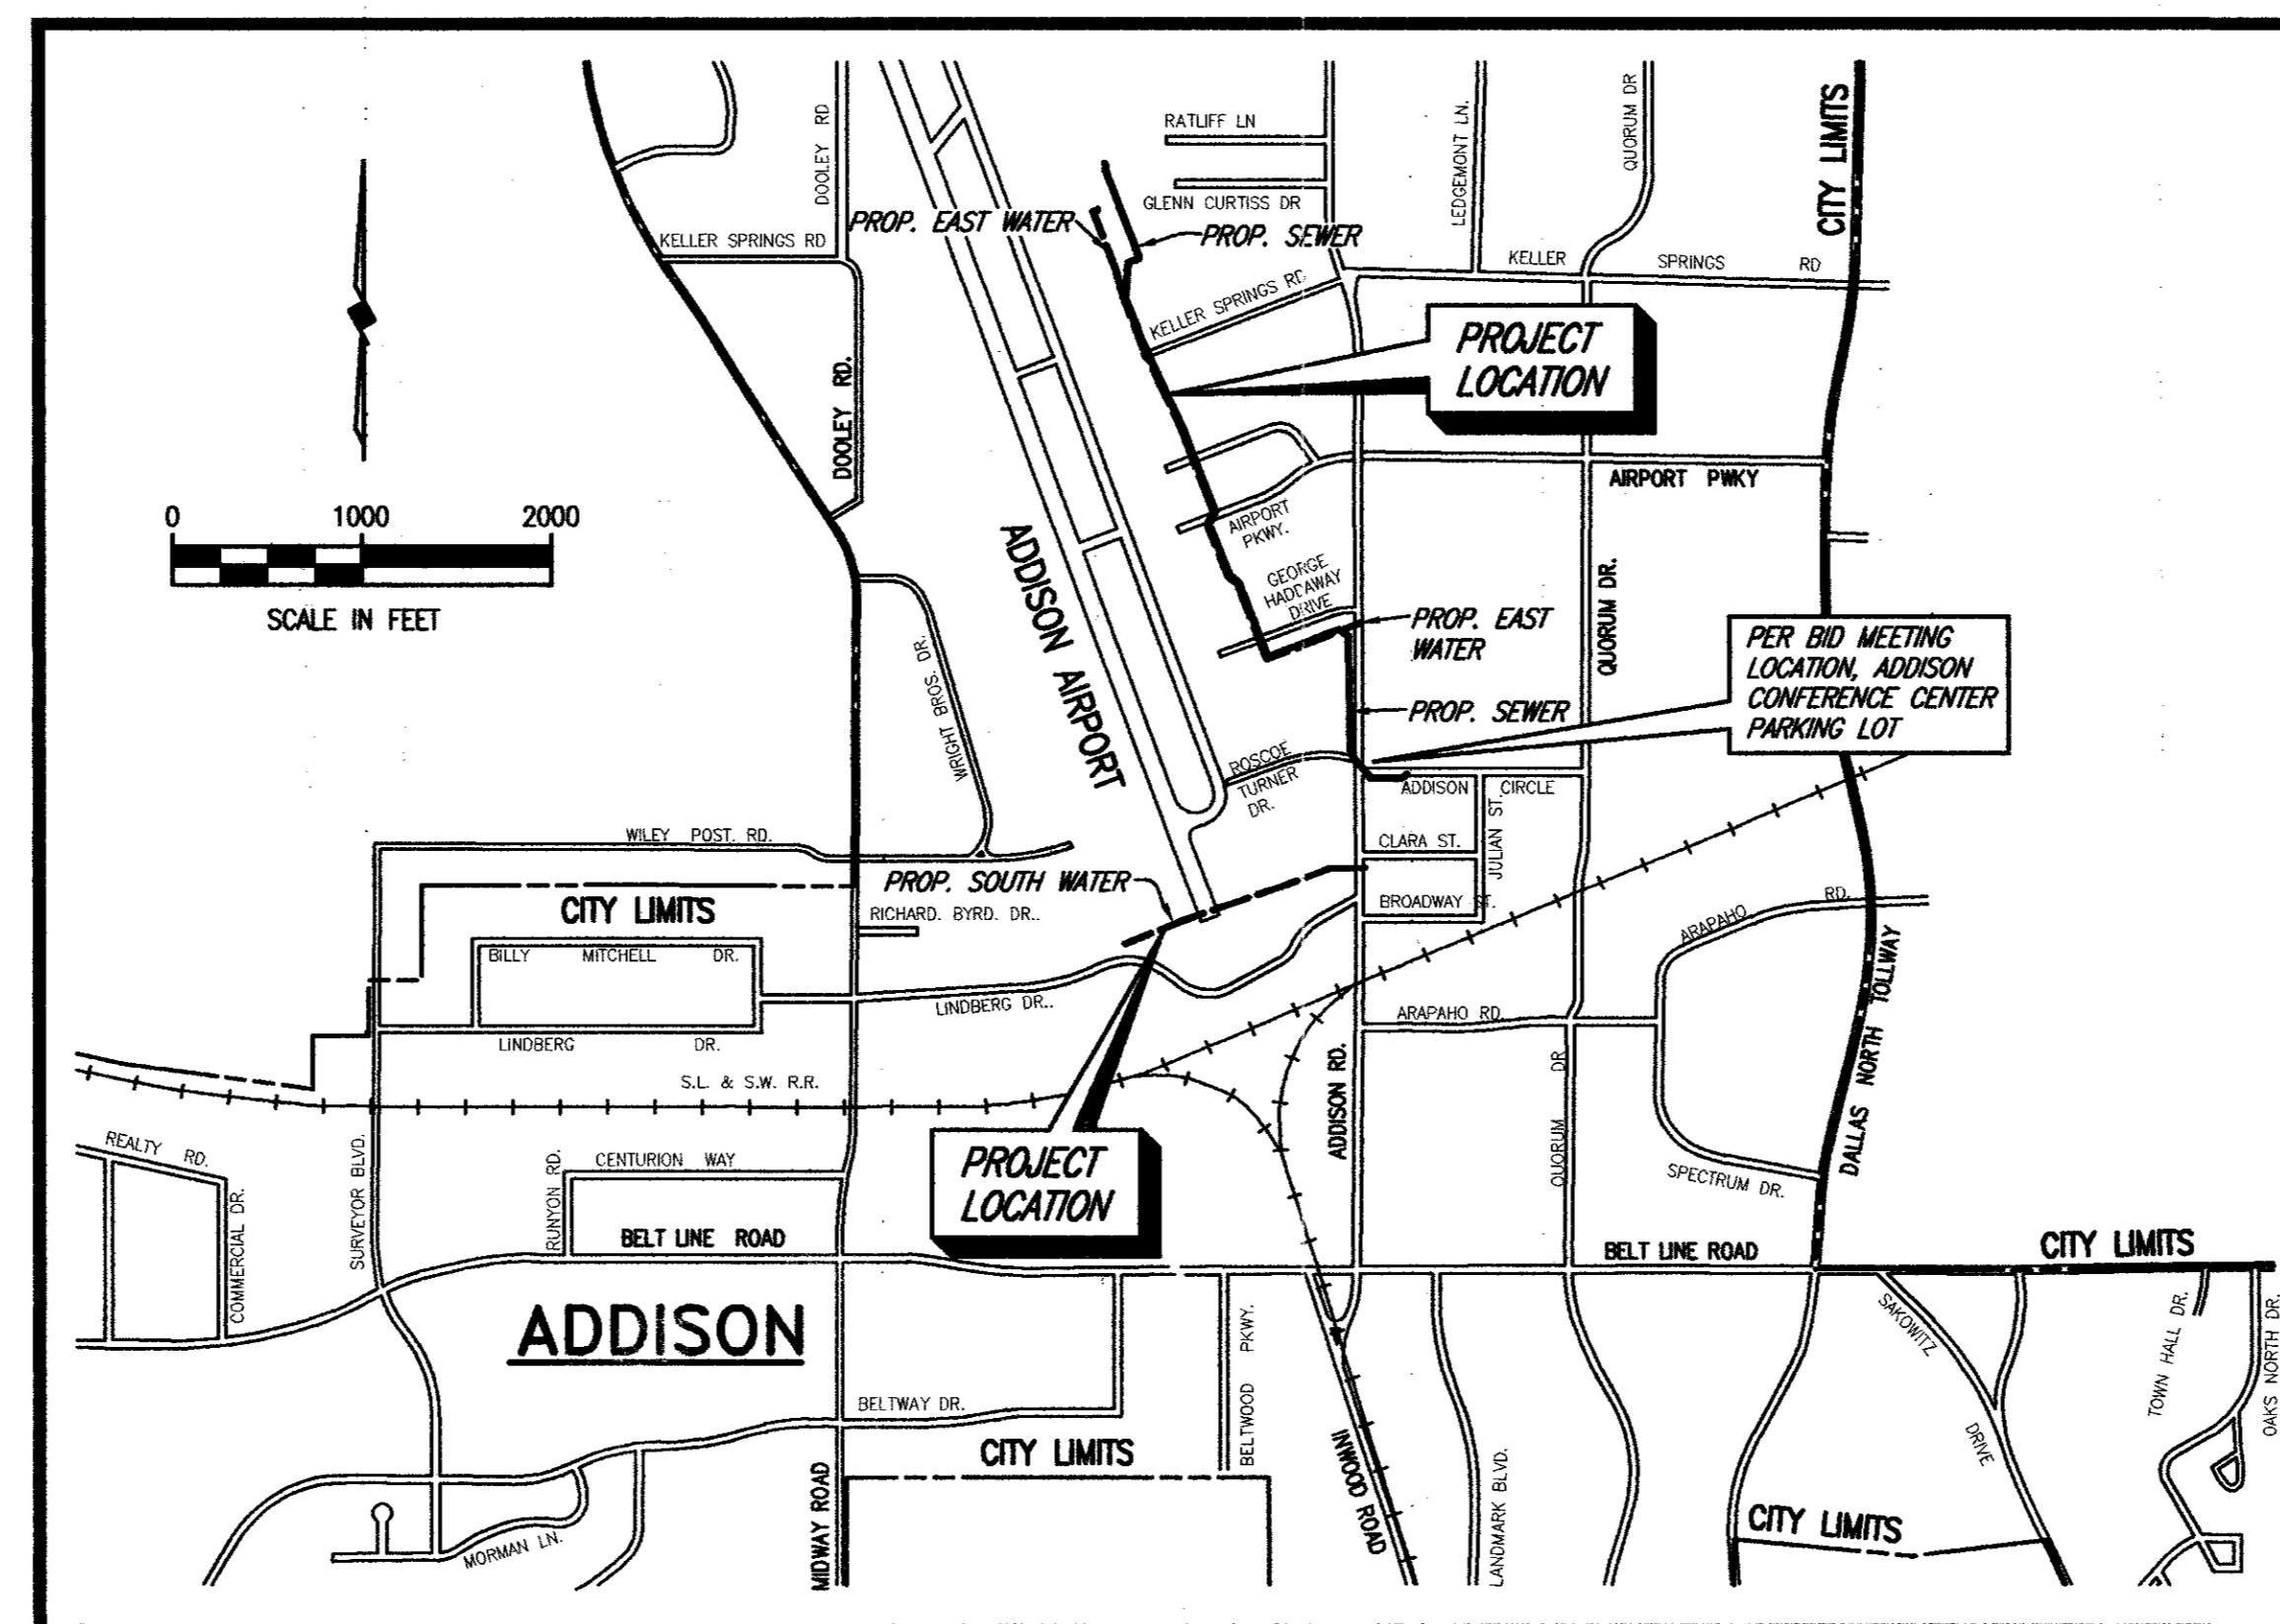

LOCATION MAP

PREPARED BY

SHIMEK, JACOBS & FINKLEA, L.L.P.
CONSULTING ENGINEERS
Dallas, Texas

SEPTEMBER, 1997

REVISED TO CONFORM
TO CONSTRUCTION RECORDS
BY J.W.B. DATE 12/07/98

SHEET INDEX

SHEET NO.	SHEET DESCRIPTION
-	GENERAL
1	COVER SHEET AND LOCATION MAP
1	GENERAL NOTES & HORIZONTAL CONTROL
2	PROPOSED SANITARY SEWER
2	PLAN - PROFILE STA. 0+06.52 TO STA. 4+00
3	PLAN - PROFILE STA. 4+00 TO STA. 9+50
4	PLAN - PROFILE STA. 9+50 TO STA. 14+00
5	PLAN - PROFILE STA. 14+00 TO STA. 19+00
6	PLAN - PROFILE STA. 19+00 TO STA. 25+00
7	PLAN - PROFILE STA. 25+00 TO STA. 30+00
8	PLAN - PROFILE STA. 30+00 TO STA. 35+00
9	PLAN - PROFILE STA. 35+00 TO STA. 39+75
10	PLAN - PROFILE STA. 39+75 TO STA. 42+83.52
11	PROFILE - LAT. SS2 STA. 0+00 TO STA. 3+28.56
12	PROPOSED EAST AIRPORT WATER LINE
12	PLAN - PROFILE STA. 0+07.86 TO STA. 4+50
13	PLAN - PROFILE STA. 4+50 TO STA. 9+50
14	PLAN - PROFILE STA. 9+50 TO STA. 14+50
15	PLAN - PROFILE STA. 14+50 TO STA. 19+50
16	PLAN - PROFILE STA. 19+50 TO STA. 25+00
17	PLAN - PROFILE STA. 25+00 TO STA. 29+00
18	PLAN - PROFILE STA. 29+00 TO STA. 31+25.75
19	PROPOSED SOUTH AIRPORT WATER LINE
19	PLAN - PROFILE STA. 0+00 TO STA. 5+00
20	PLAN - PROFILE STA. 5+00 TO STA. 10+00
21	PLAN - PROFILE STA. 10+00 TO STA. 13+41.57
22 - 25	MISCELLANEOUS STANDARD DETAILS

THESE DOCUMENTS ARE FOR
BIDDING, CONSTRUCTION,
AND PERMIT PURPOSES.
John W. Birkhoff
DATE: 9/5/97



These plans and related specifications were prepared for construction of this specific project only. Reuse of these documents is not permitted without written authorization of Shimek, Jacobs & Finklea, L.L.P.