


**☺ CURVE DATA**  
 $\Delta = 20^{\circ}42'30''$   
 $R = 425.00'$   
 $T = 77.65'$   
 $L = 153.61'$

NOTE: All Driveway Radii are 10' unless otherwise noted

B.M.#7 - Top F.H. 28.5' Rt. Sta. 34+91.50  
 ELEV. 649.13

SUNBELT DEVELOPMENT CO.

BAIRD PROPERTIES, INC.

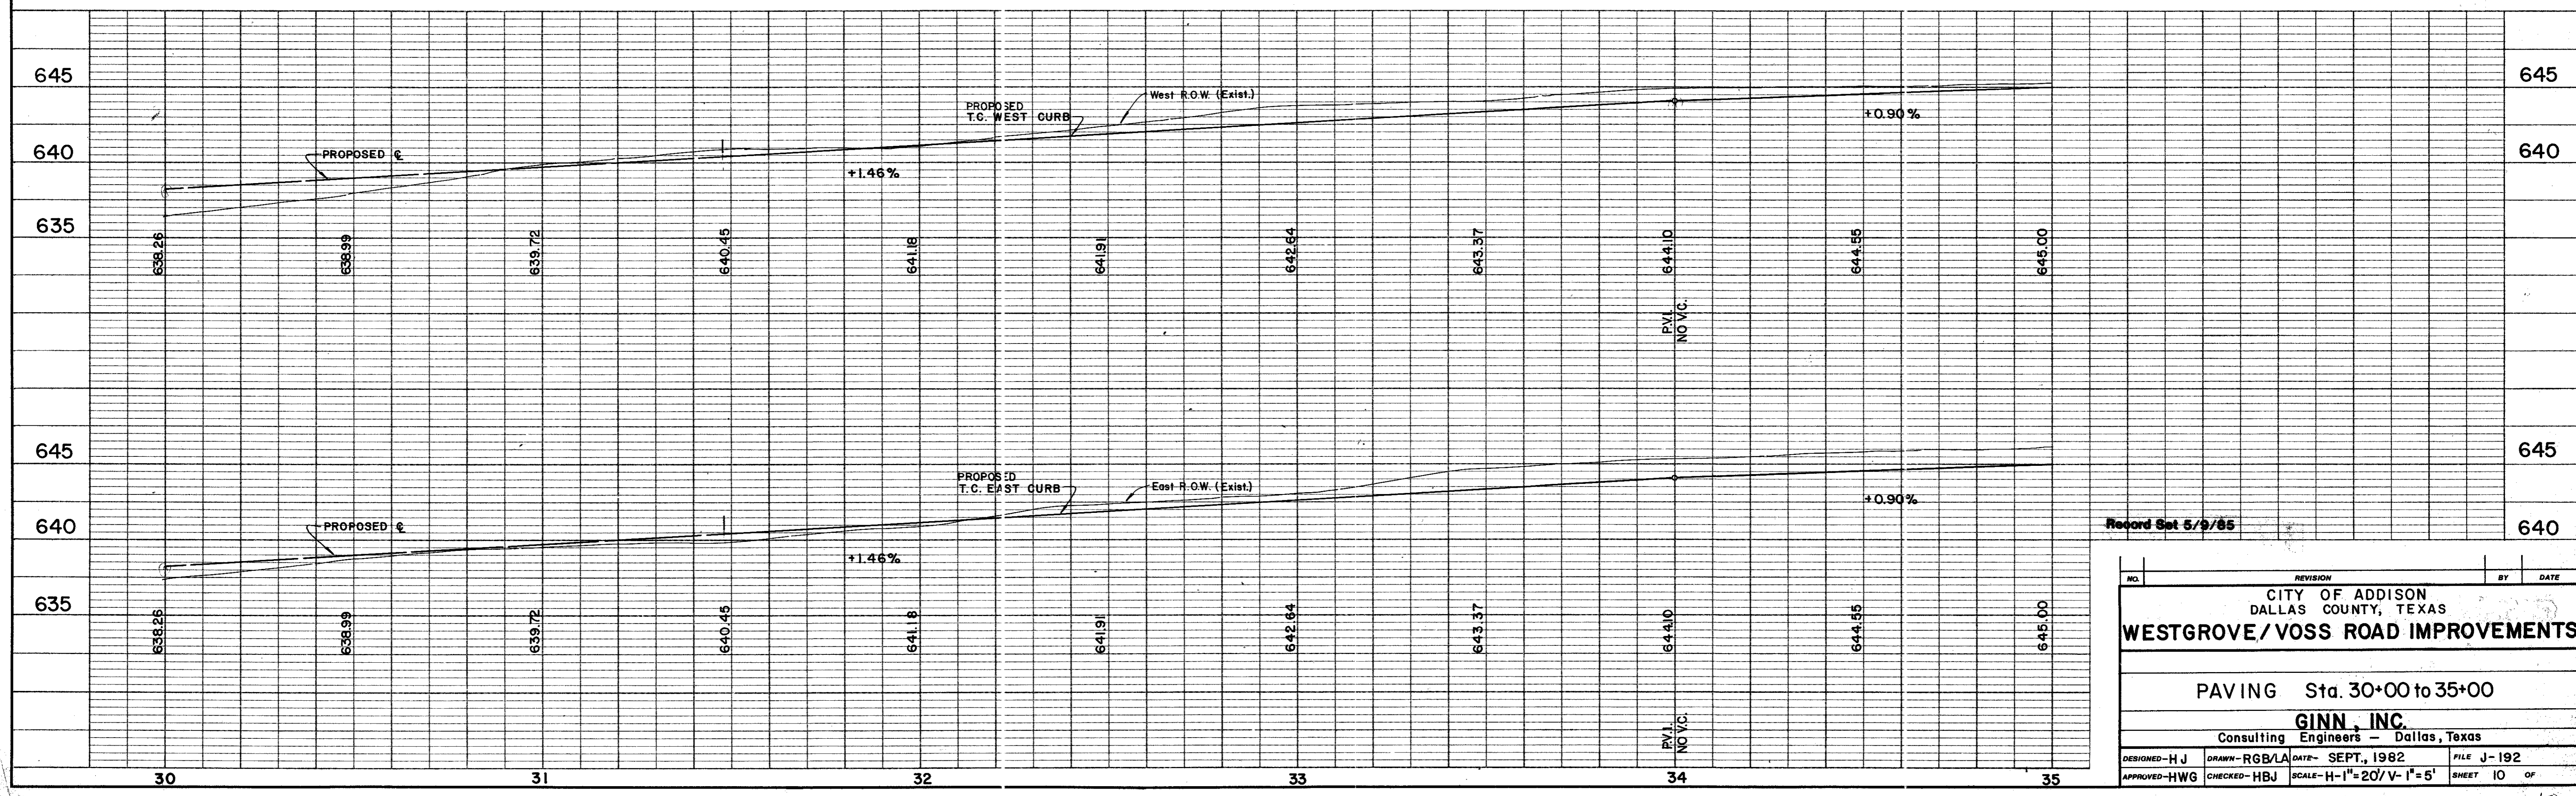

Record Set 5/9/85

NO.	REVISION	BY	DATE
CITY OF ADDISON DALLAS COUNTY, TEXAS <b>WESTGROVE/VOSS ROAD IMPROVEMENTS</b>			
PAVING Sta. 30+00 to 35+00 <b>GINN, INC.</b> Consulting Engineers - Dallas, Texas			
DESIGNED - HJ	DRAWN - RGB/LA	DATE - SEPT, 1982	FILE J-192
APPROVED - HWG	CHECKED - HBJ	SCALE - H-1"=20'/V-1"=5'	SHEET 10 OF