



FELLOWS MFG. CO.

DATA
ACADEMY DR
A = 45°00'00"
R = 235.00'
T = 97.34'
L = 184.57'

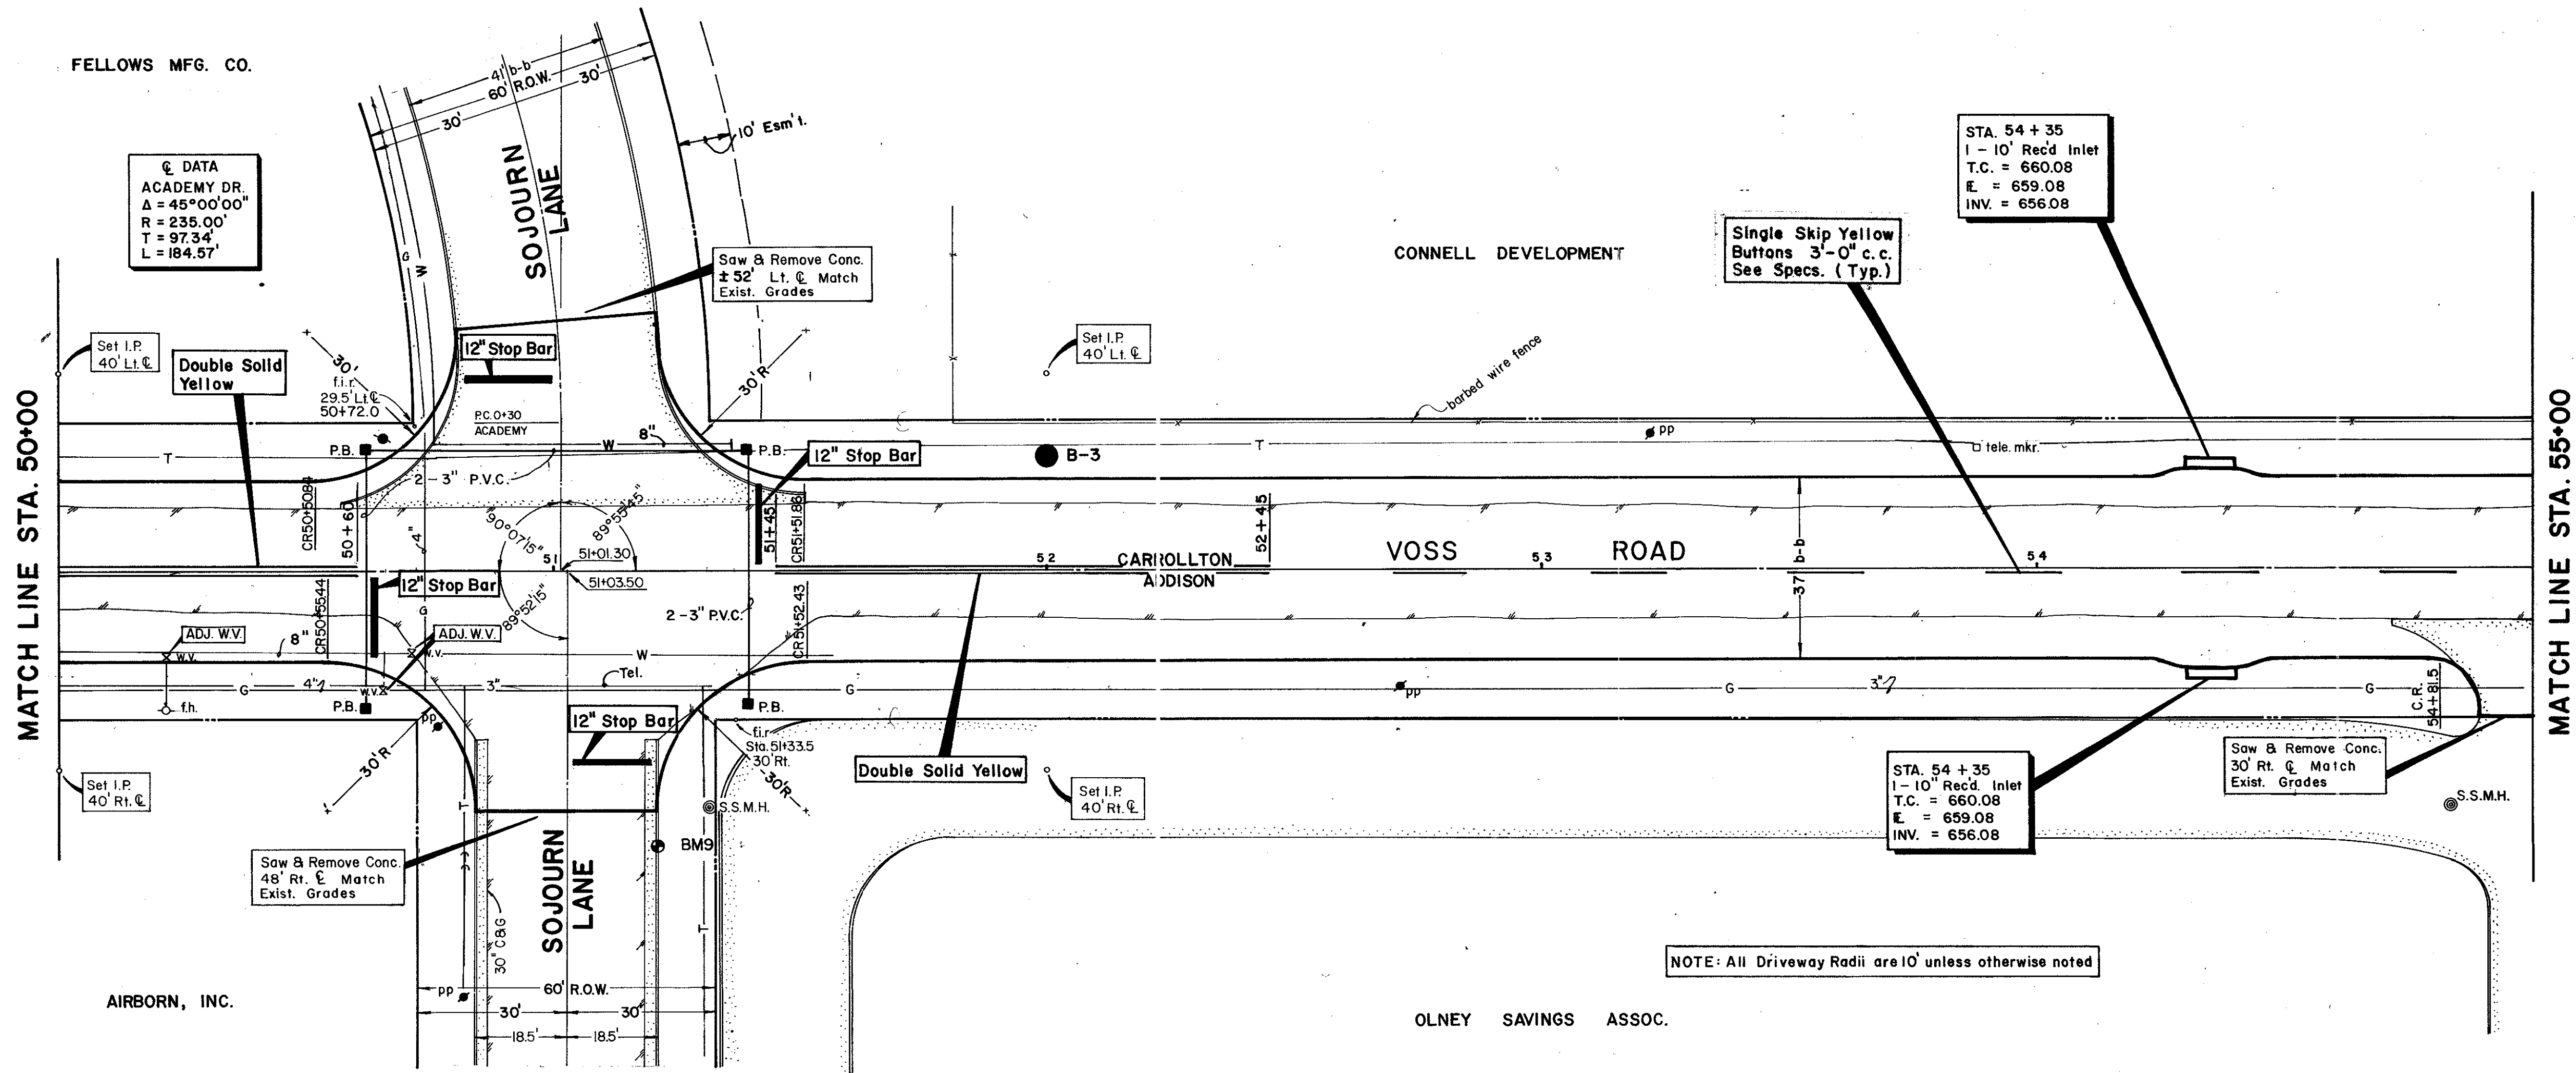

NOTE: All Driveway Radii are 10' unless otherwise noted

B.M.#9 - "□" cut on T.C. No. side Sojourn Ln.
55' Rt. Sta. 51+25
ELEV. 660.49

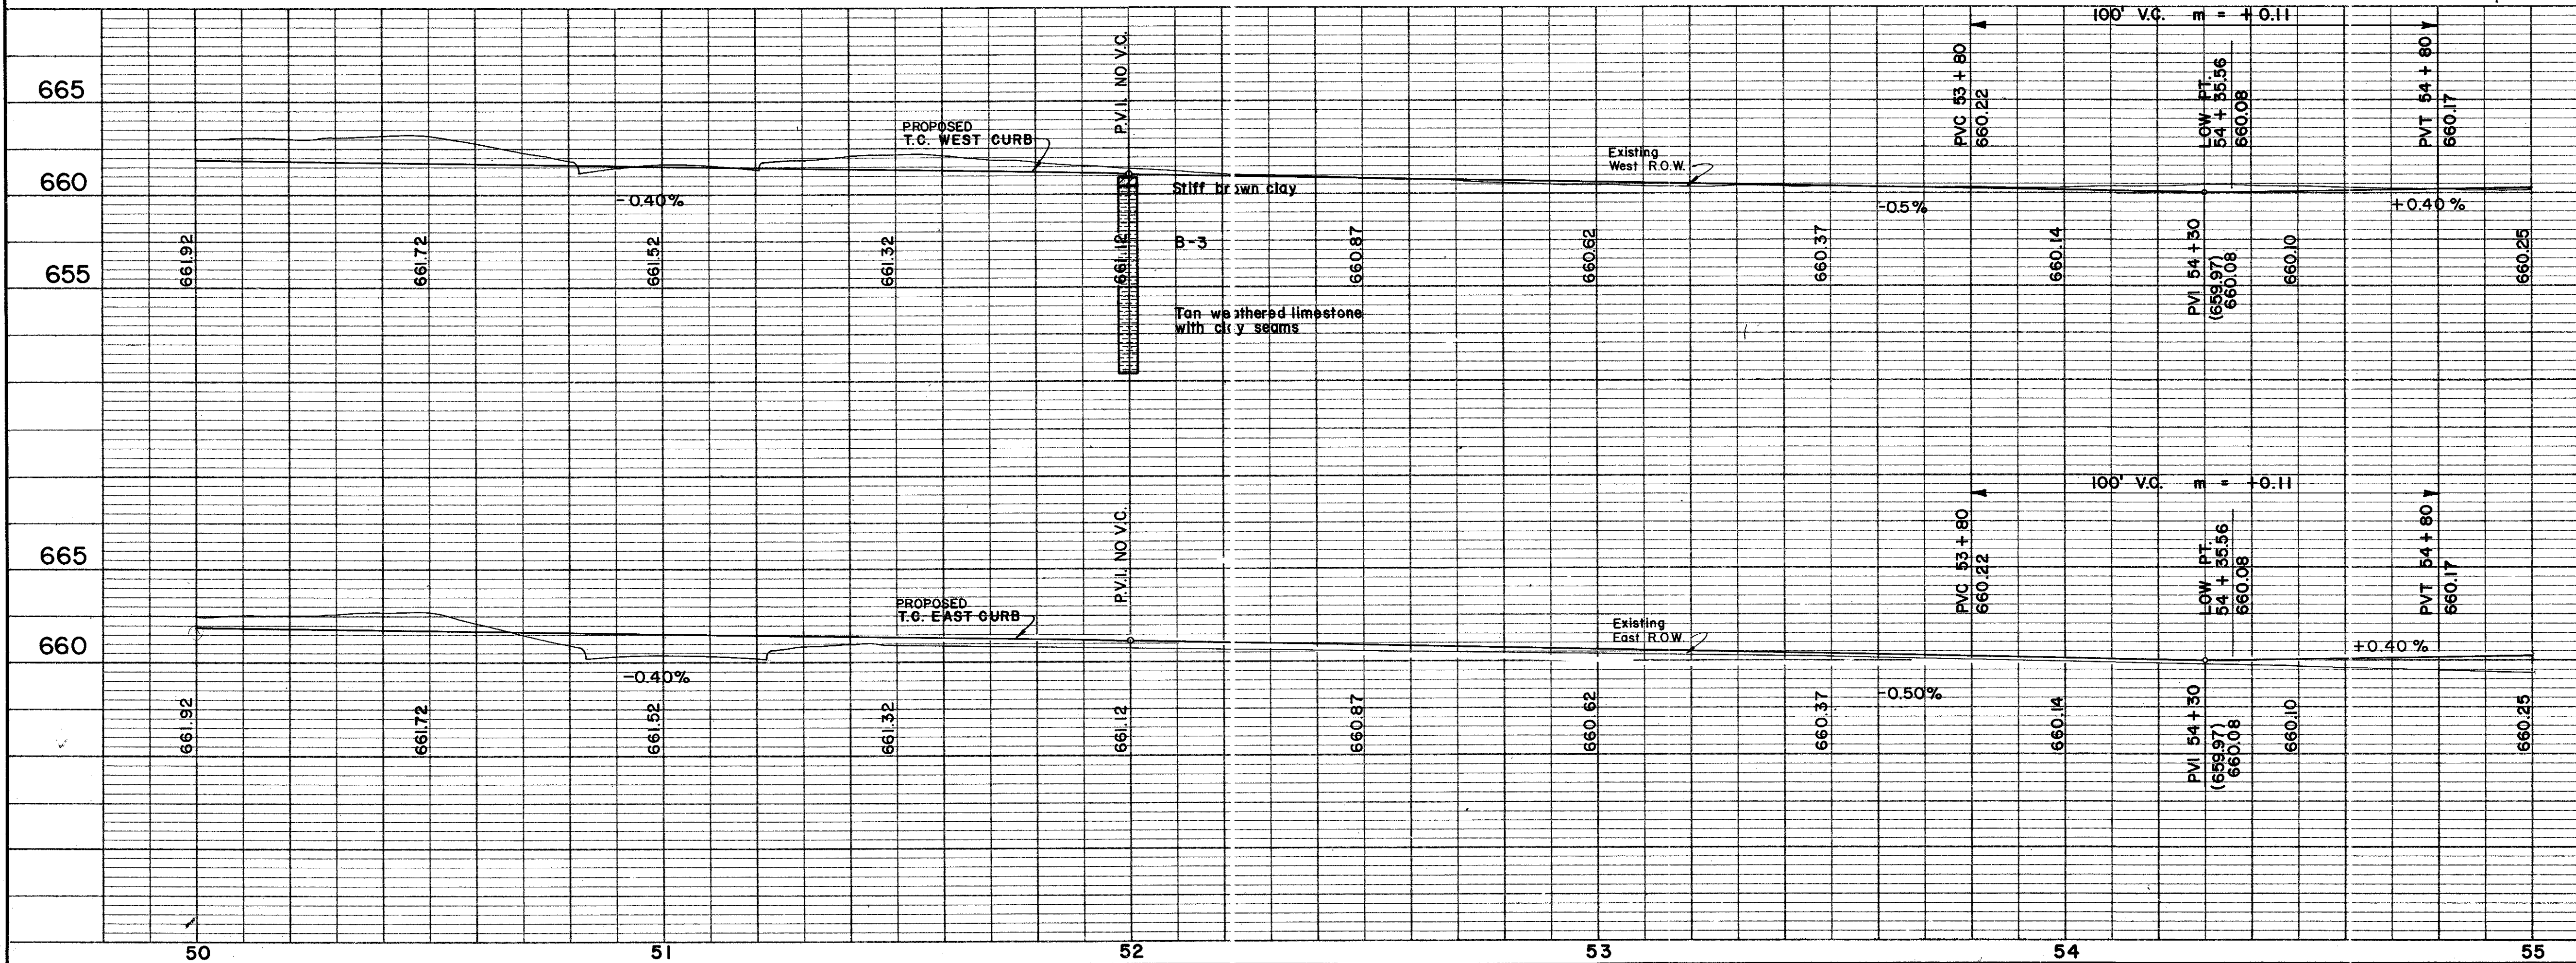

Record Set 5/8/85

NO.	REVISION	BY	DATE
CITY OF ADDISON DALLAS COUNTY, TEXAS			
WESTGROVE/VOSS ROAD IMPROVEMENTS			
PAVING Sta. 50+00 to 55+00			
GINN, INC. Consulting Engineers - Dallas, Texas			
DESIGNED - H.J.	DRAWN - RB/LA	DATE - SEPT., 1982	FILE - J-192
APPROVED - HWG	CHECKED - HBJ	SCALE - H-1"=20'/V-1"=5'	SHEET 14 OF