

MATCH LINE STA. 15+00



MATCH LINE STA. 20+00

WEST & ASSOC. INC.

N. N. REALTY J/V

B.M.#4 - 4" cut on T.C. 41' Rt Sta. 17+00
ELEV. 632.89

NOTE: All Driveway Radii are 10 unless otherwise noted

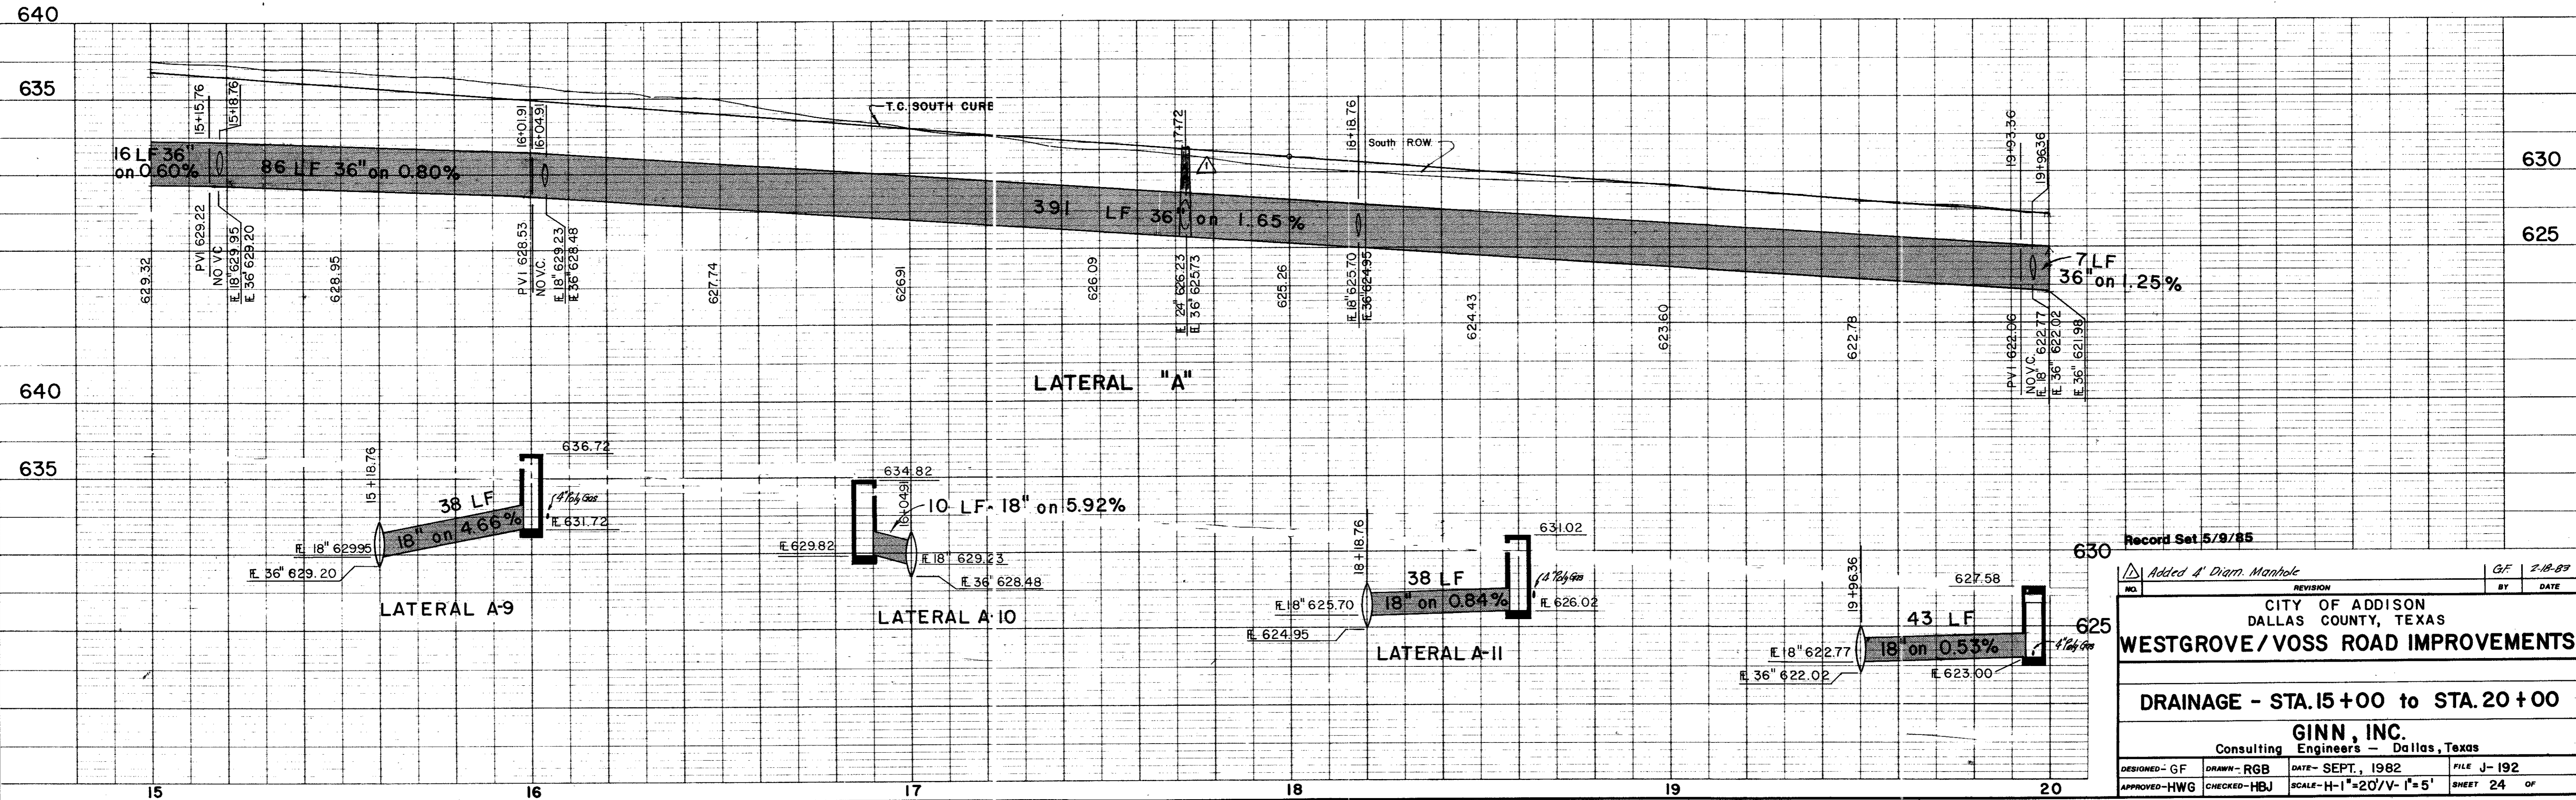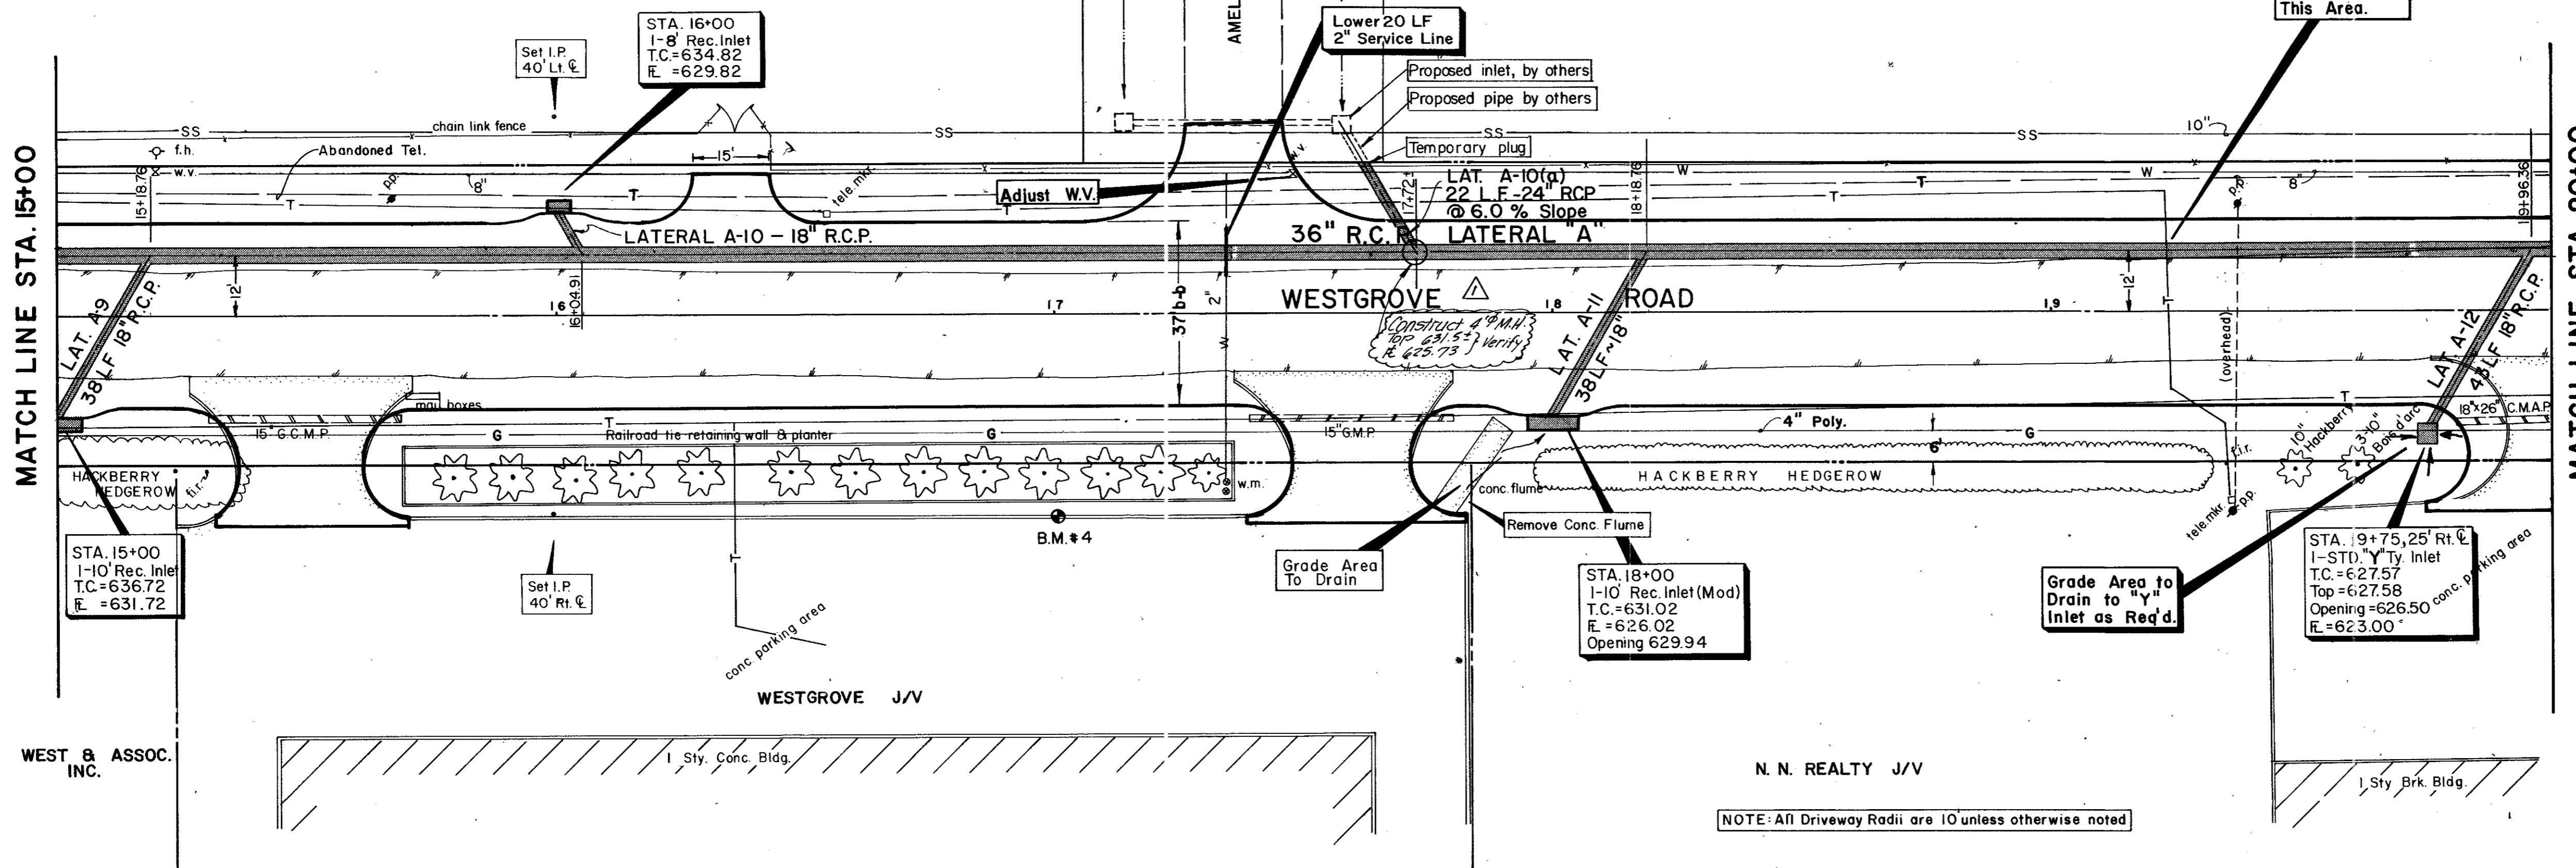

DESIGNED - GF	DRAWN - RGB	DATE - SEPT., 1982	FILE J-192
APPROVED - HWG	CHECKED - HBJ	SCALE - H-1"=20'/V-1"=5'	SHEET 24 OF

Record Set 5/9/85

Added 4' Diam. Manhole

REVISION

BY DATE

GF 2-18-89

CITY OF ADDISON
DALLAS COUNTY, TEXAS

WESTGROVE / VOSS ROAD IMPROVEMENTS

DRAINAGE - STA. 15+00 to STA. 20+00

GINN, INC.
Consulting Engineers - Dallas, Texas