


B.M. # 5 - "□" cut on T.C. Northmost Inlet
So. corner East side Sunbelt Dr.
60' Rt Sta 22+40
ELEV. 628.21

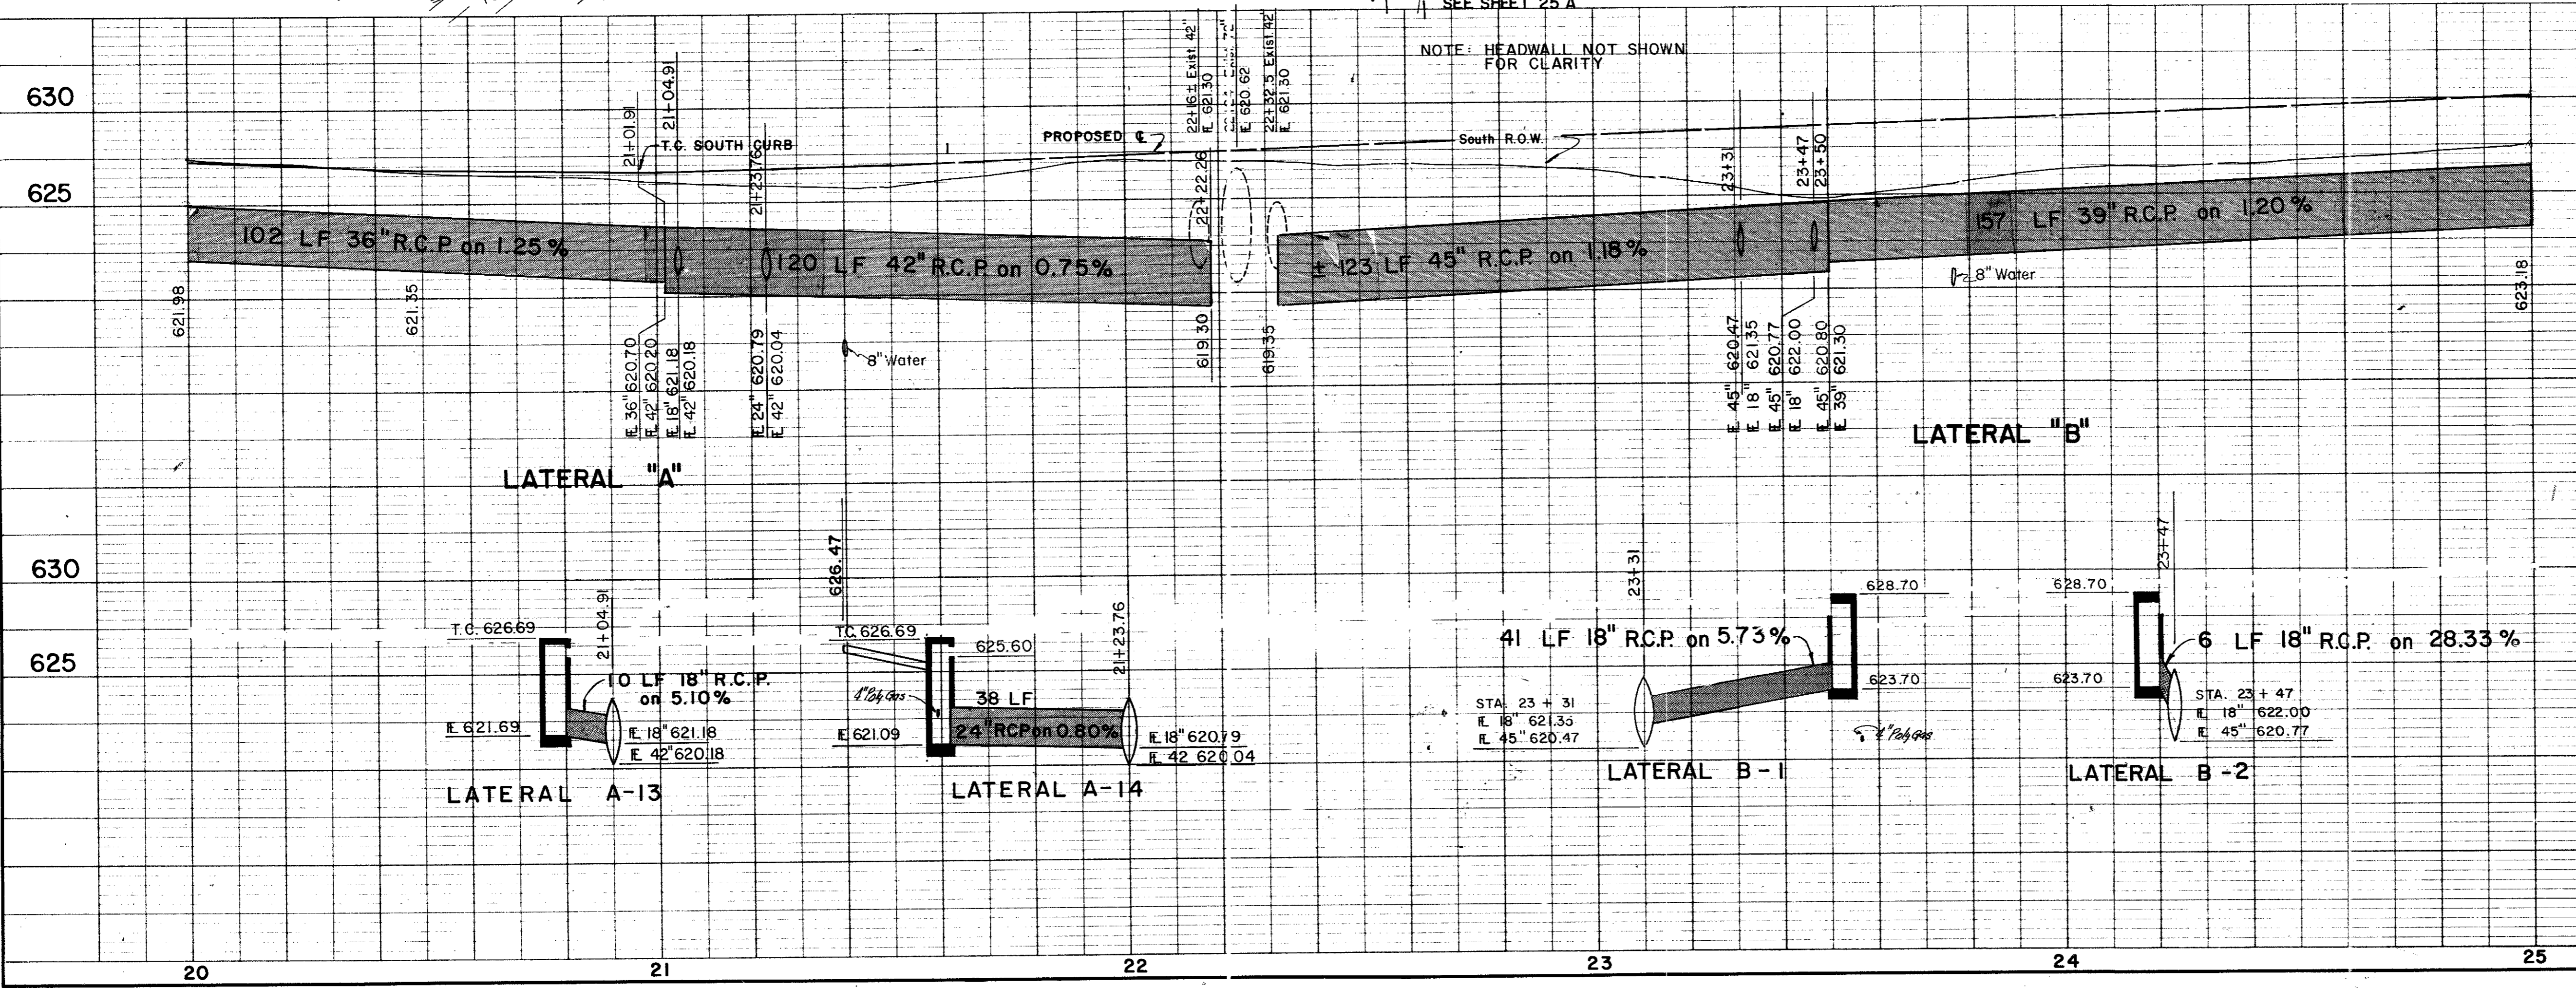

Record Set 5/9/85

NO.	REVISION	BY	DATE
CITY OF ADDISON DALLAS COUNTY, TEXAS WESTGROVE / VOSS ROAD IMPROVEMENTS			
DRAINAGE - STA. 20+00 to 25+00			
GINN, INC. Consulting Engineers - Dallas, Texas			
DESIGNED - GF	DRAWN - RGB	DATE - SEPT, 1982	FILE J-192
APPROVED - HWG	CHECKED - HB	SCALE - H-1"=20'/V-1"=5'	SHEET 25 OF