

PIPE DATA  
 $\Delta = 20^\circ 42' 30''$   
 $T = 66.25'$   
 $R = 362.60'$   
 $L = 131.05'$

CURVE DATA  
 $\Delta = 20^\circ 42' 30''$   
 $R = 425.00'$   
 $T = 77.65'$   
 $L = 153.61'$

ADDISON AIRPORT


STA. 33 + 50  
 1 - 10" Rec'd Inlet  
 T.C. = 643.37  
 E. = 638.37

NOTE: All Driveway Radii are 10' unless otherwise noted

B.M.#7 - Top F.H. 28.5' Rt. Sta. 34+91.50  
 ELEV. 649.13

BAIRD PROPERTIES, INC.

SUNBELT DEVELOPMENT CO.

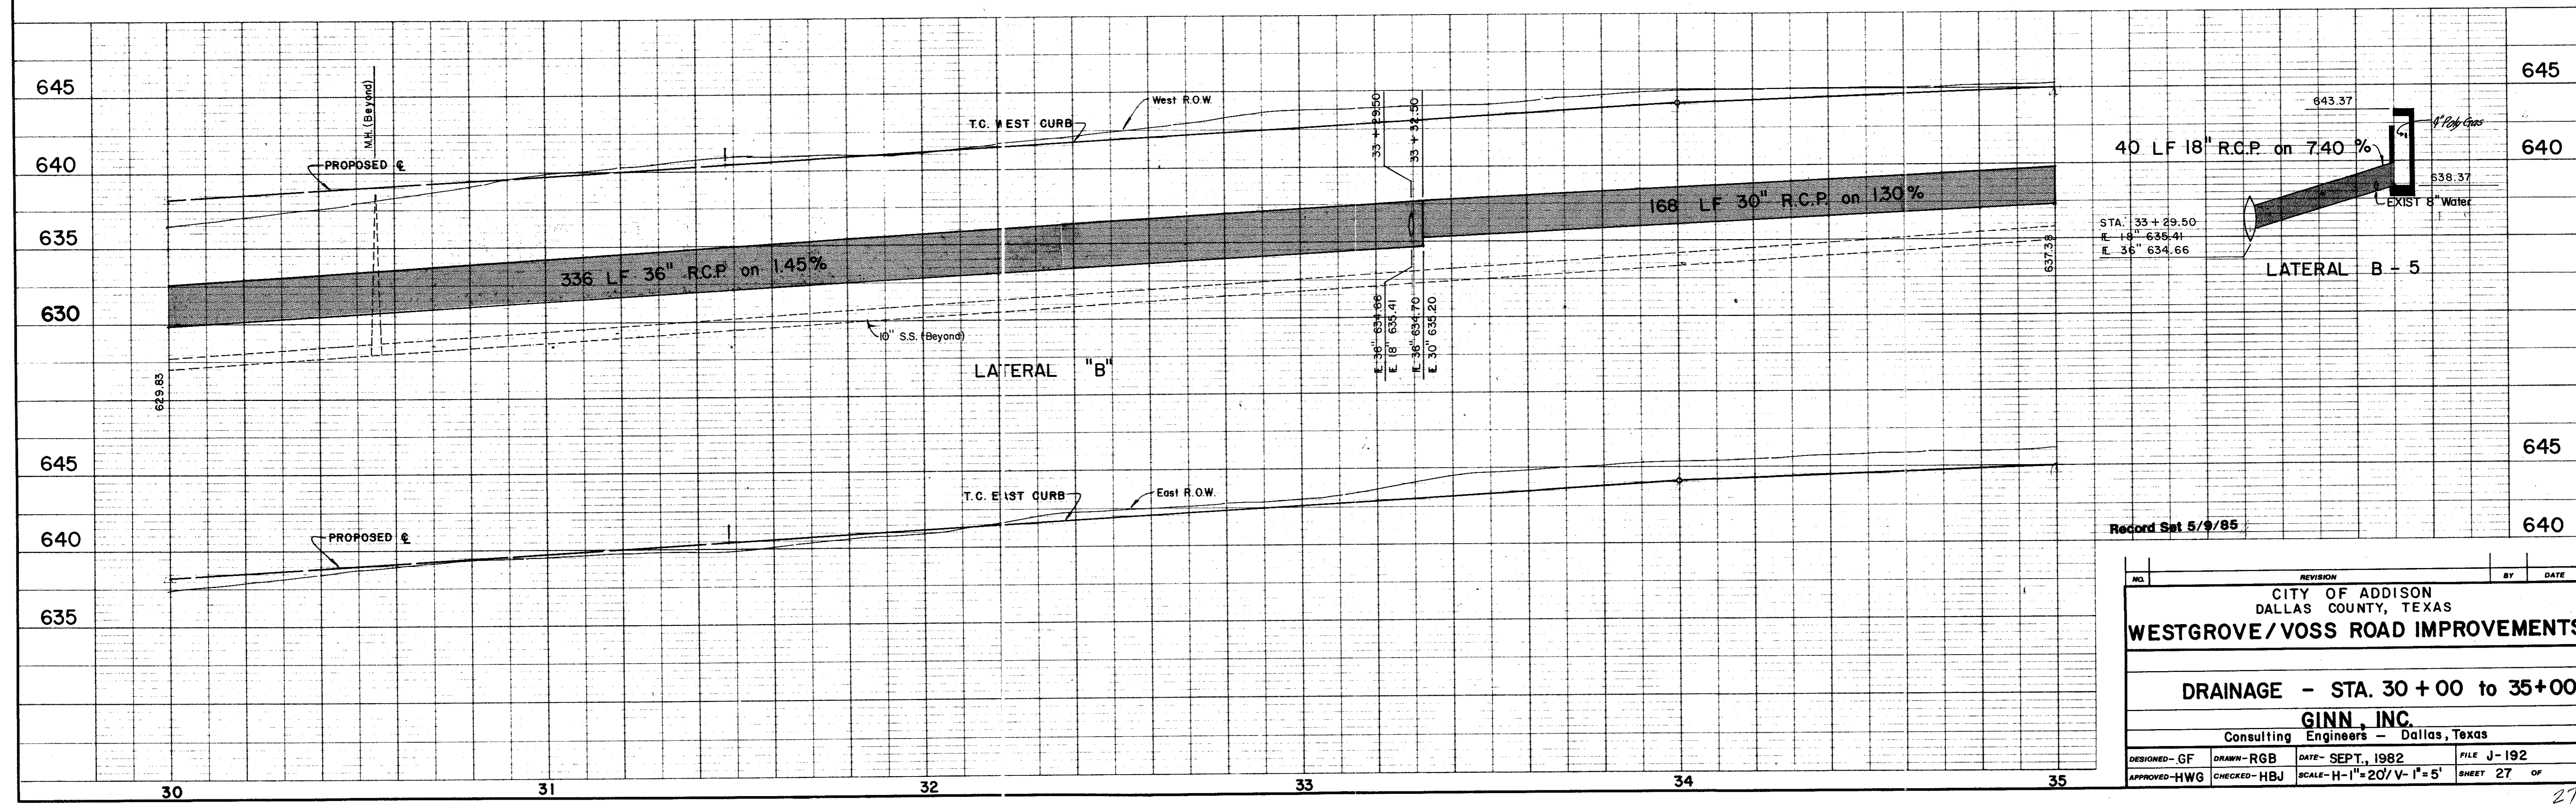

Record Set 5/9/85

NO.	REVISION	BY	DATE
CITY OF ADDISON DALLAS COUNTY, TEXAS			
<b>WESTGROVE/VOSS ROAD IMPROVEMENTS</b>			
<b>DRAINAGE - STA. 30 + 00 to 35 + 00</b>			
<b>GINN, INC.</b> Consulting Engineers - Dallas, Texas			
DESIGNED - GF	DRAWN - RGB	DATE - SEPT., 1982	FILE J-192
APPROVED - HWG	CHECKED - HBJ	SCALE - H-1"=20'/V-1"=5'	SHEET 27 OF