


NOTE: All Driveway Radii are 10' unless otherwise noted

B.M. #8-1 cut on T.C. on No. side of drive
50' Lt. Sta. 42+55
ELEV. 654.92

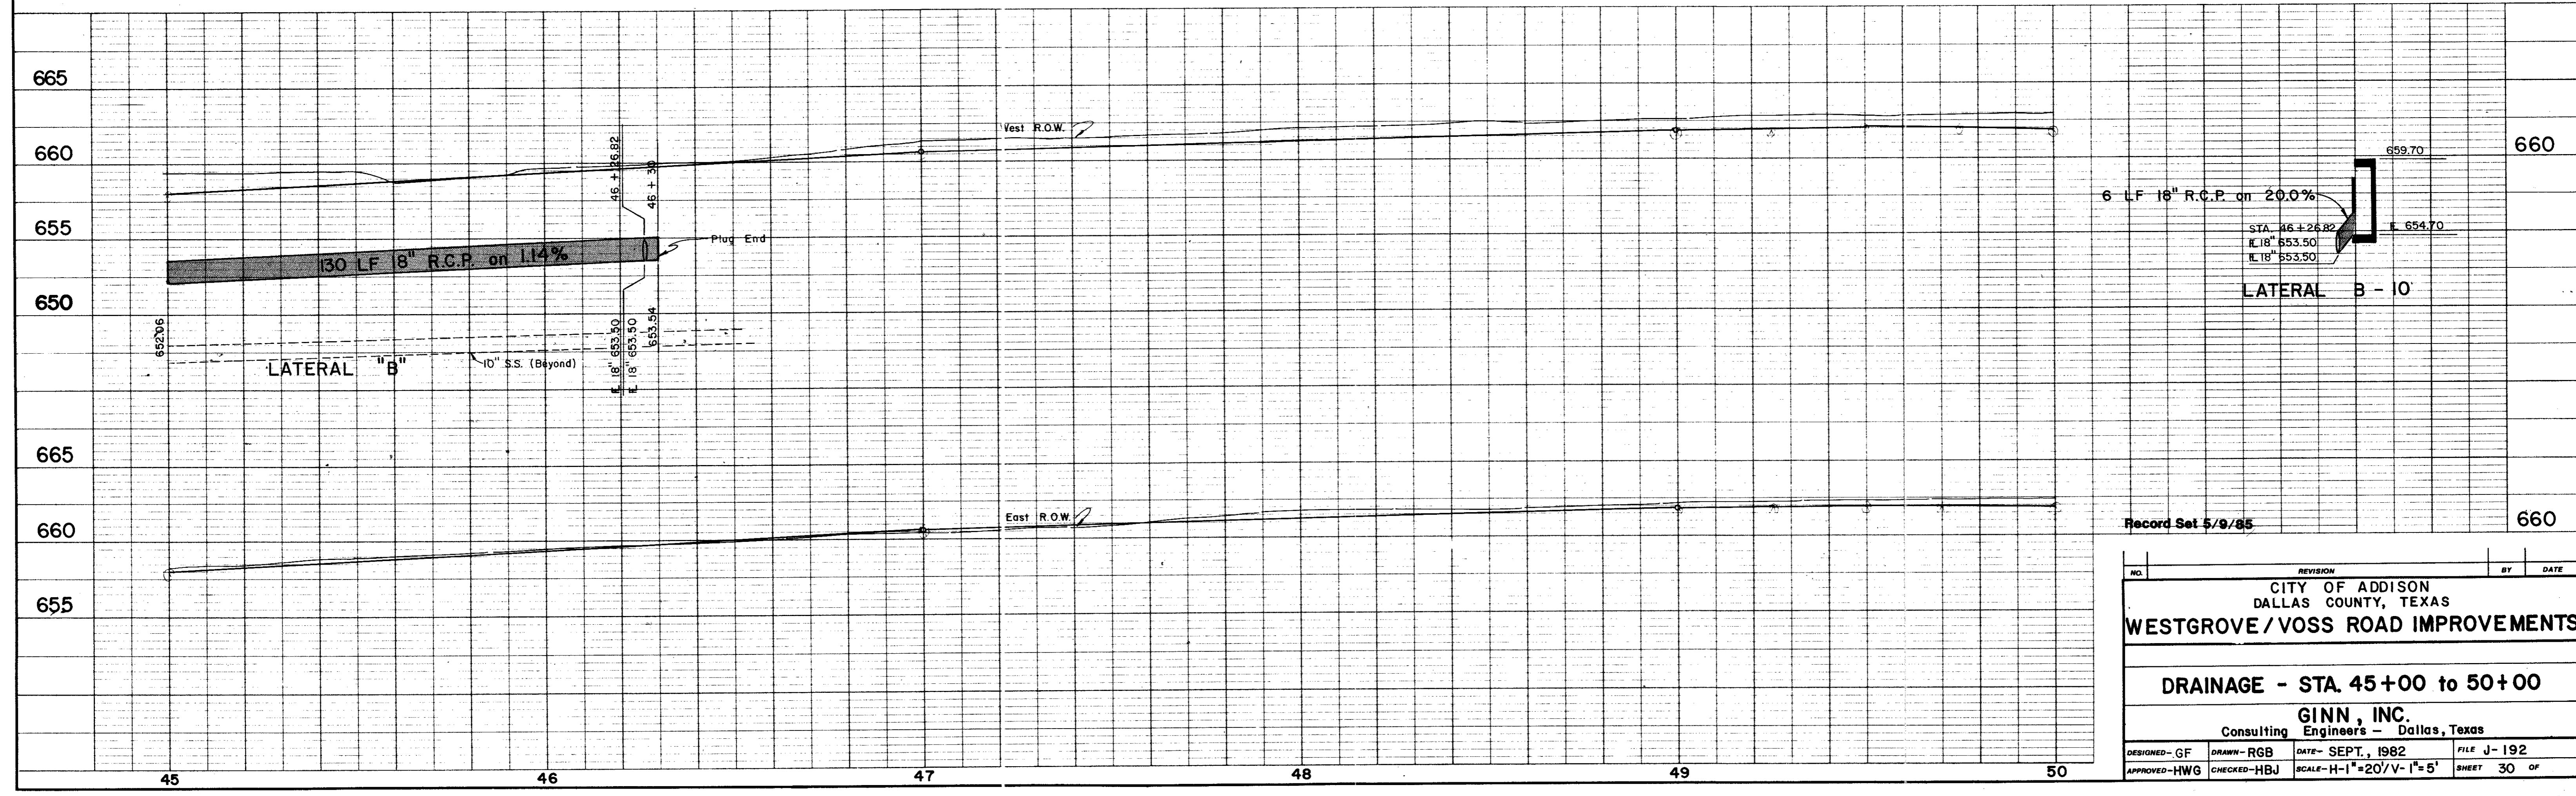

Record Set 5/9/85

NO.	REVISION	BY	DATE
CITY OF ADDISON DALLAS COUNTY, TEXAS			
WESTGROVE / VOSS ROAD IMPROVEMENTS			
DRAINAGE - STA. 45+00 to 50+00			
GINN, INC. Consulting Engineers - Dallas, Texas			
DESIGNED - GF	DRAWN - RGB	DATE - SEPT., 1982	FILE J-192
APPROVED - HWG	CHECKED - HBJ	SCALE - H-1" = 20' / V-1" = 5'	SHEET 30 OF