

MATCH LINE STA. 60+00

GROVER HOPE

CONNELL DEVELOPMENT CO.

JACK POGUE

VOSS ROAD

GRAVEL ROAD

80' R.O.W.

50'

55' R.O.W.

30'

30'

STA. 61 + 00  
1 - 8" Rec'd. Inlet  
T.C. = 662.80  
Opening = 661.80  
INV. = 659.05

STA. 63 + 75  
1 - 8" Rec'd. Inlet  
T.C. = 664.45  
Opening = 663.45  
INV. = 660.45


C-1  
C CURVE DATA  
Δ = 18°35'24"  
R = 342.71'  
T = 56.09'  
L = 111.19'

C-2  
C CURVE DATA  
Δ = 18°48'58"  
R = 319.41'  
T = 52.92'  
L = 104.89'

STA. 61 + 00  
1 - 8" Rec'd. Inlet  
T.C. = 662.80  
Opening = 661.80  
INV. = 659.05

STA. 63 + 75  
1 - 8" Rec'd. Inlet  
T.C. = 664.45  
Opening = 663.45  
INV. = 660.45

B.M. #9 - "□" cut on T.C. No side Sojourn Ln.  
55' Rt. Sta. 51+25  
E L.E.V. 660.49

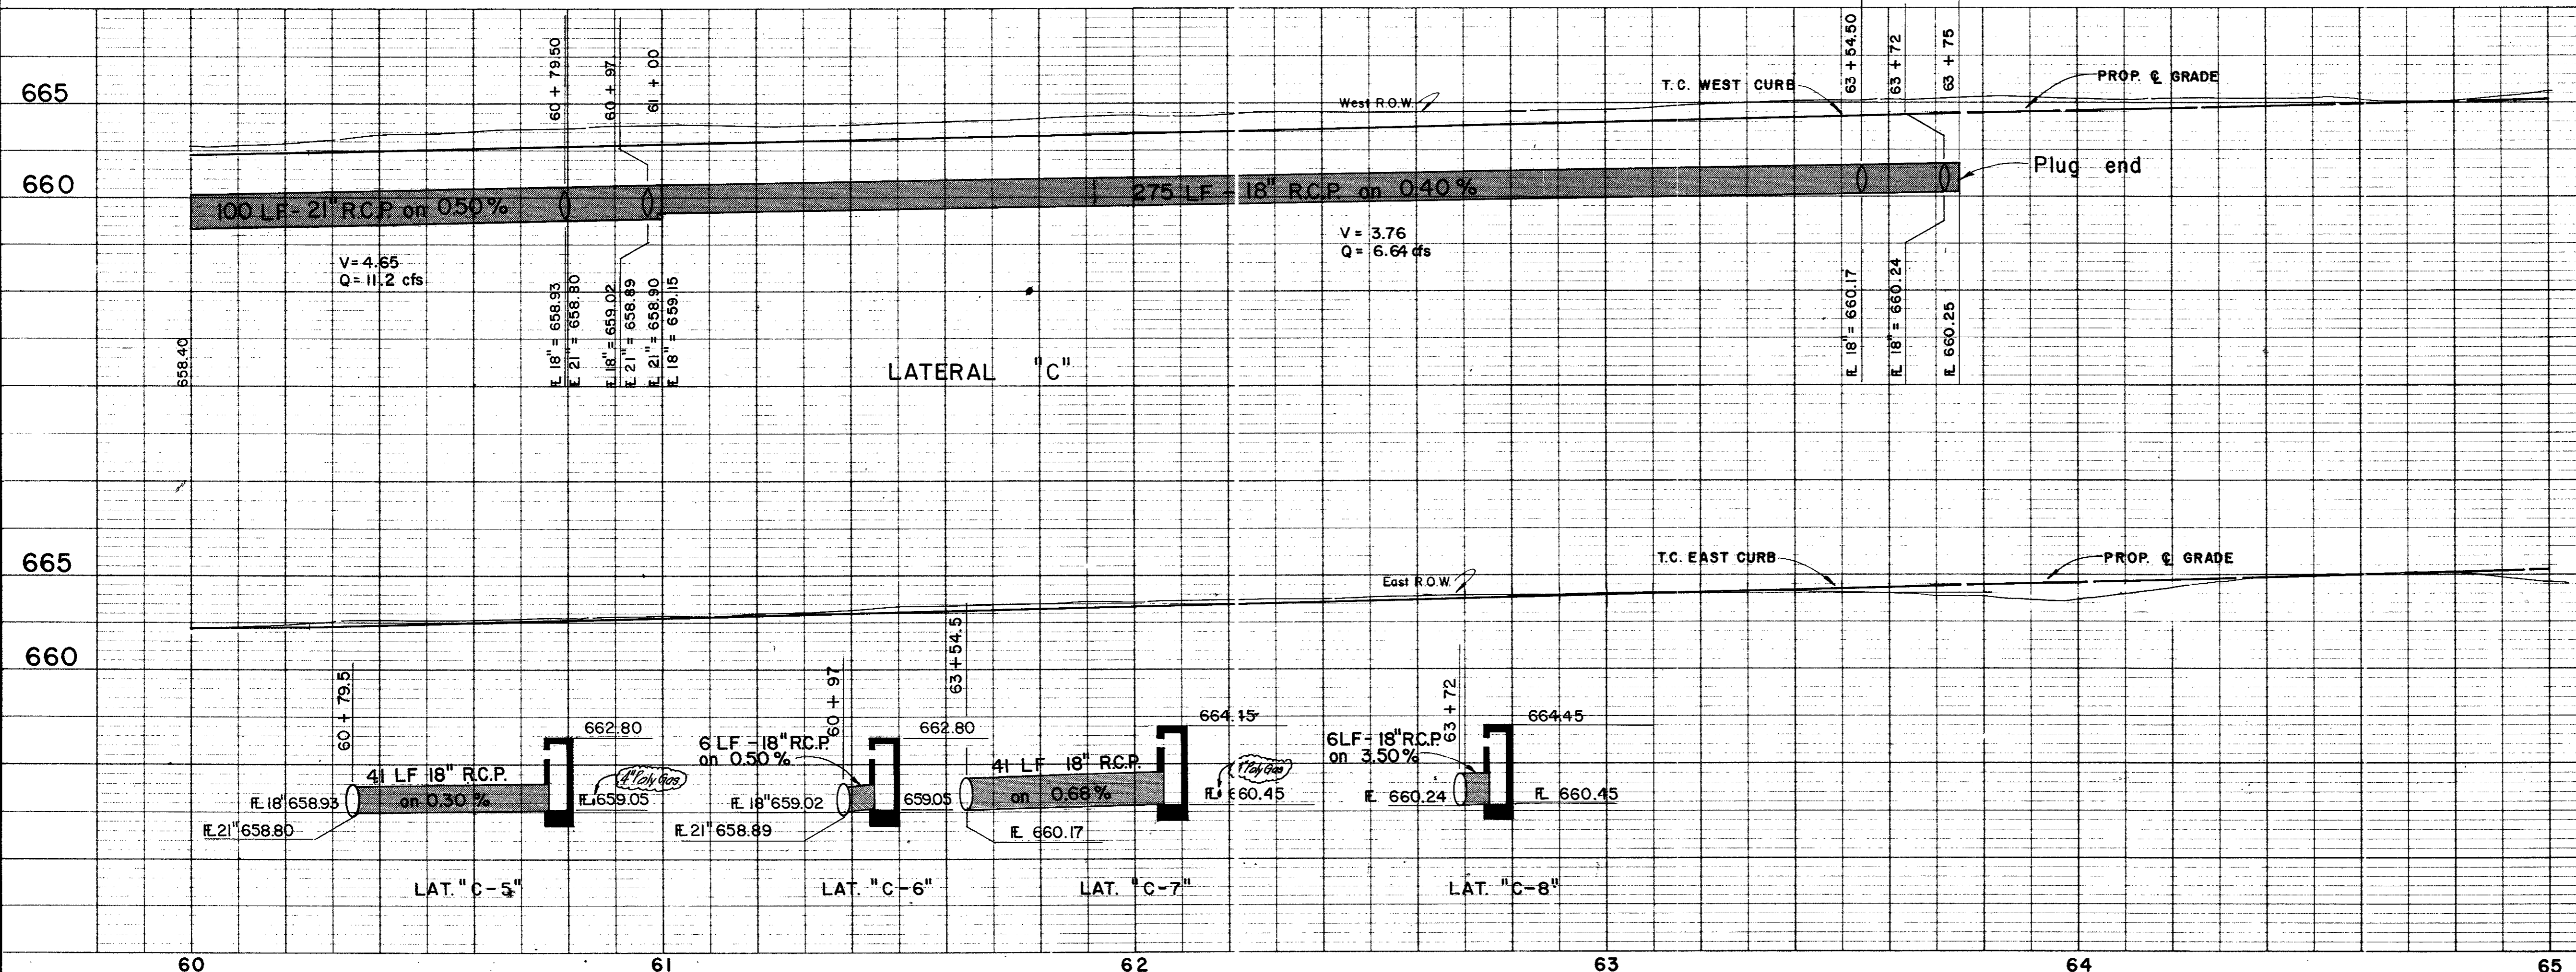

Record Set 5/9/85

NO.	REVISION	BY	DATE
CITY OF ADDISON DALLAS COUNTY, TEXAS			
<b>WESTGROVE/VOSS ROAD IMPROVEMENTS</b>			
<b>DRAINAGE - STA. 60+00 to 65+00</b>			
<b>GINN, INC.</b> Consulting Engineers - Dallas, Texas			
DESIGNED - GF	DRAWN - RGB	DATE - SEPT., 1982	FILE J-192
APPROVED - HWG	CHECKED - HBJ	SCALE - H-1"=20'/V-1"=5'	SHEET 33 OF