

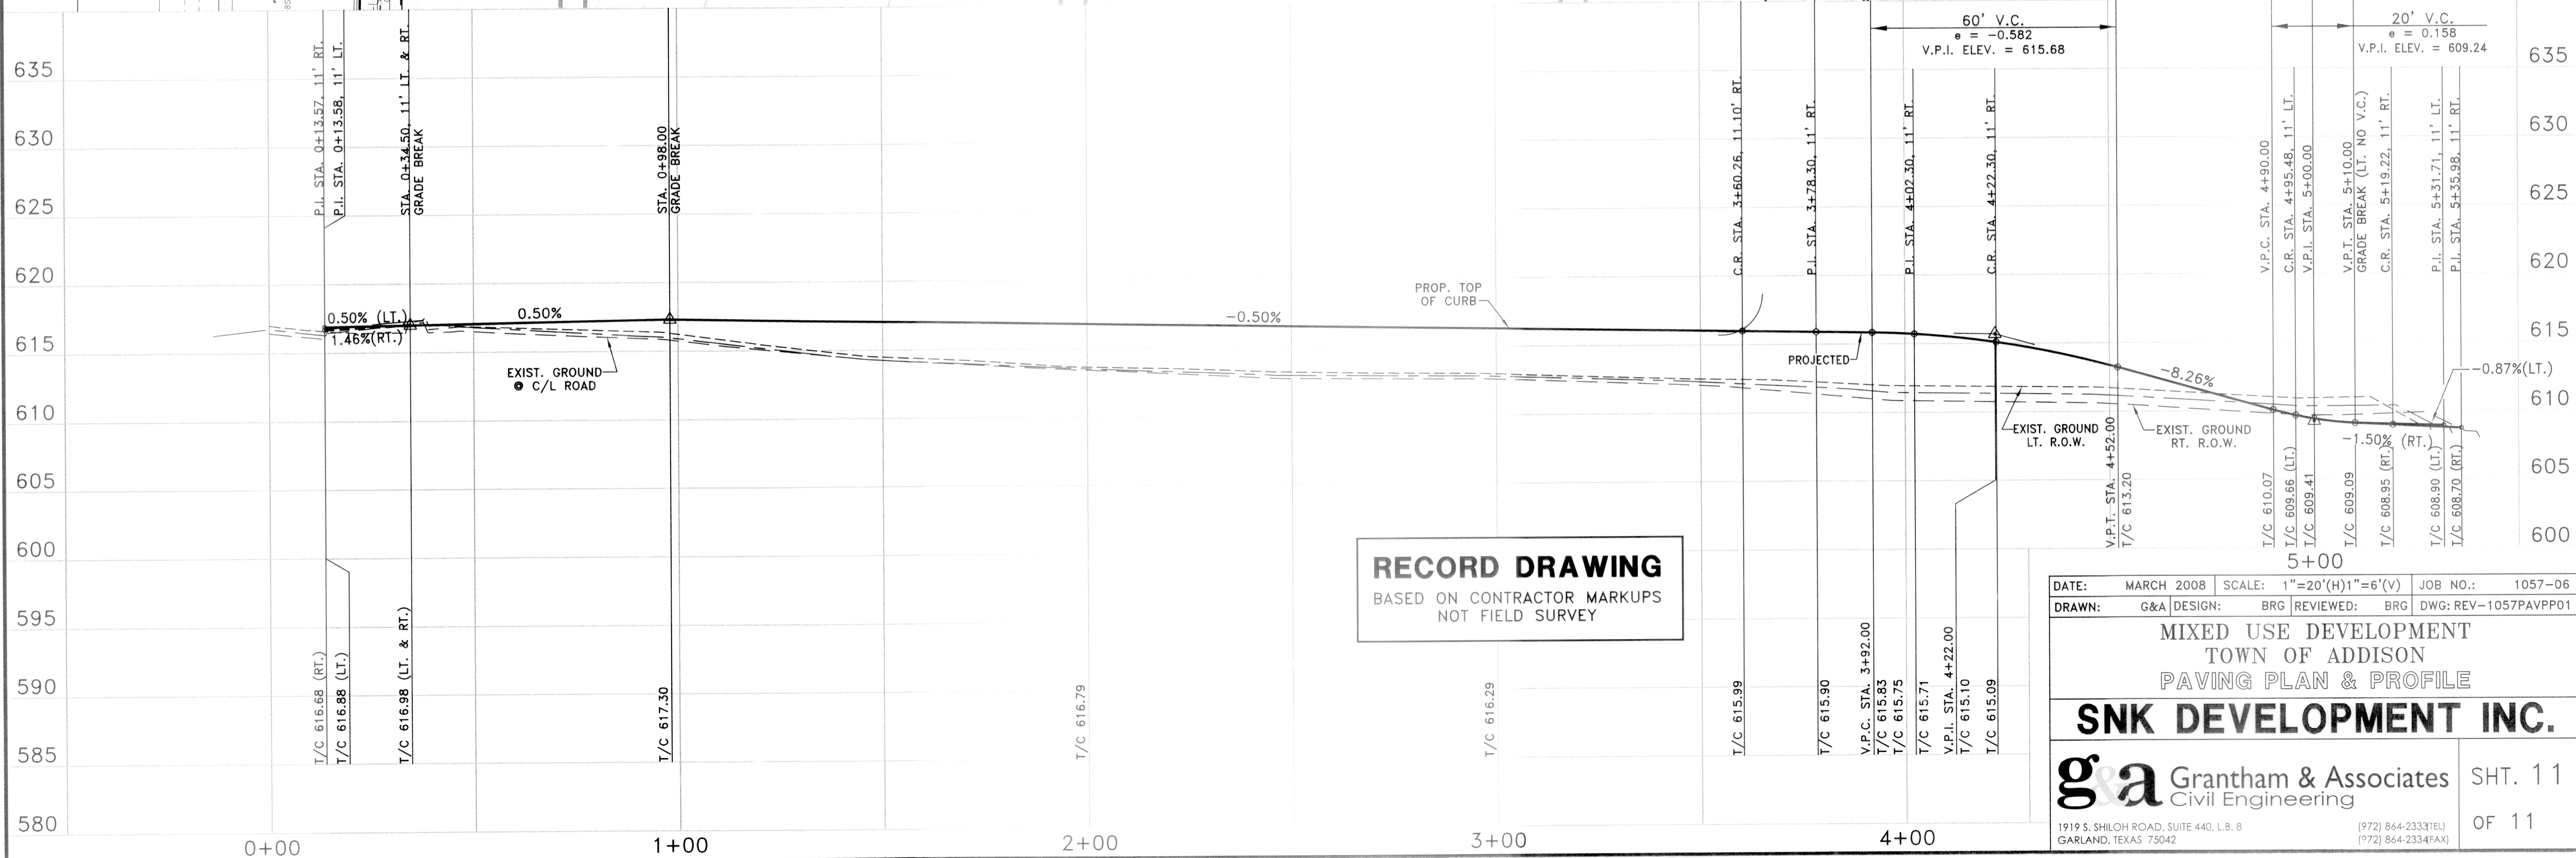


- ① PLACE STOP SIGN(R1-1) WITH STREET NAME BLADES & FINIAL PERADDITION CIRCLE REQUIREMENT
- ② TYPE 'C' PAVERS ON CONCRETE BASE

NO.	DATE	REVISION	APPROV.
1	3/12/08	REVISED CALL OUTS	B.R.G
2			
3			

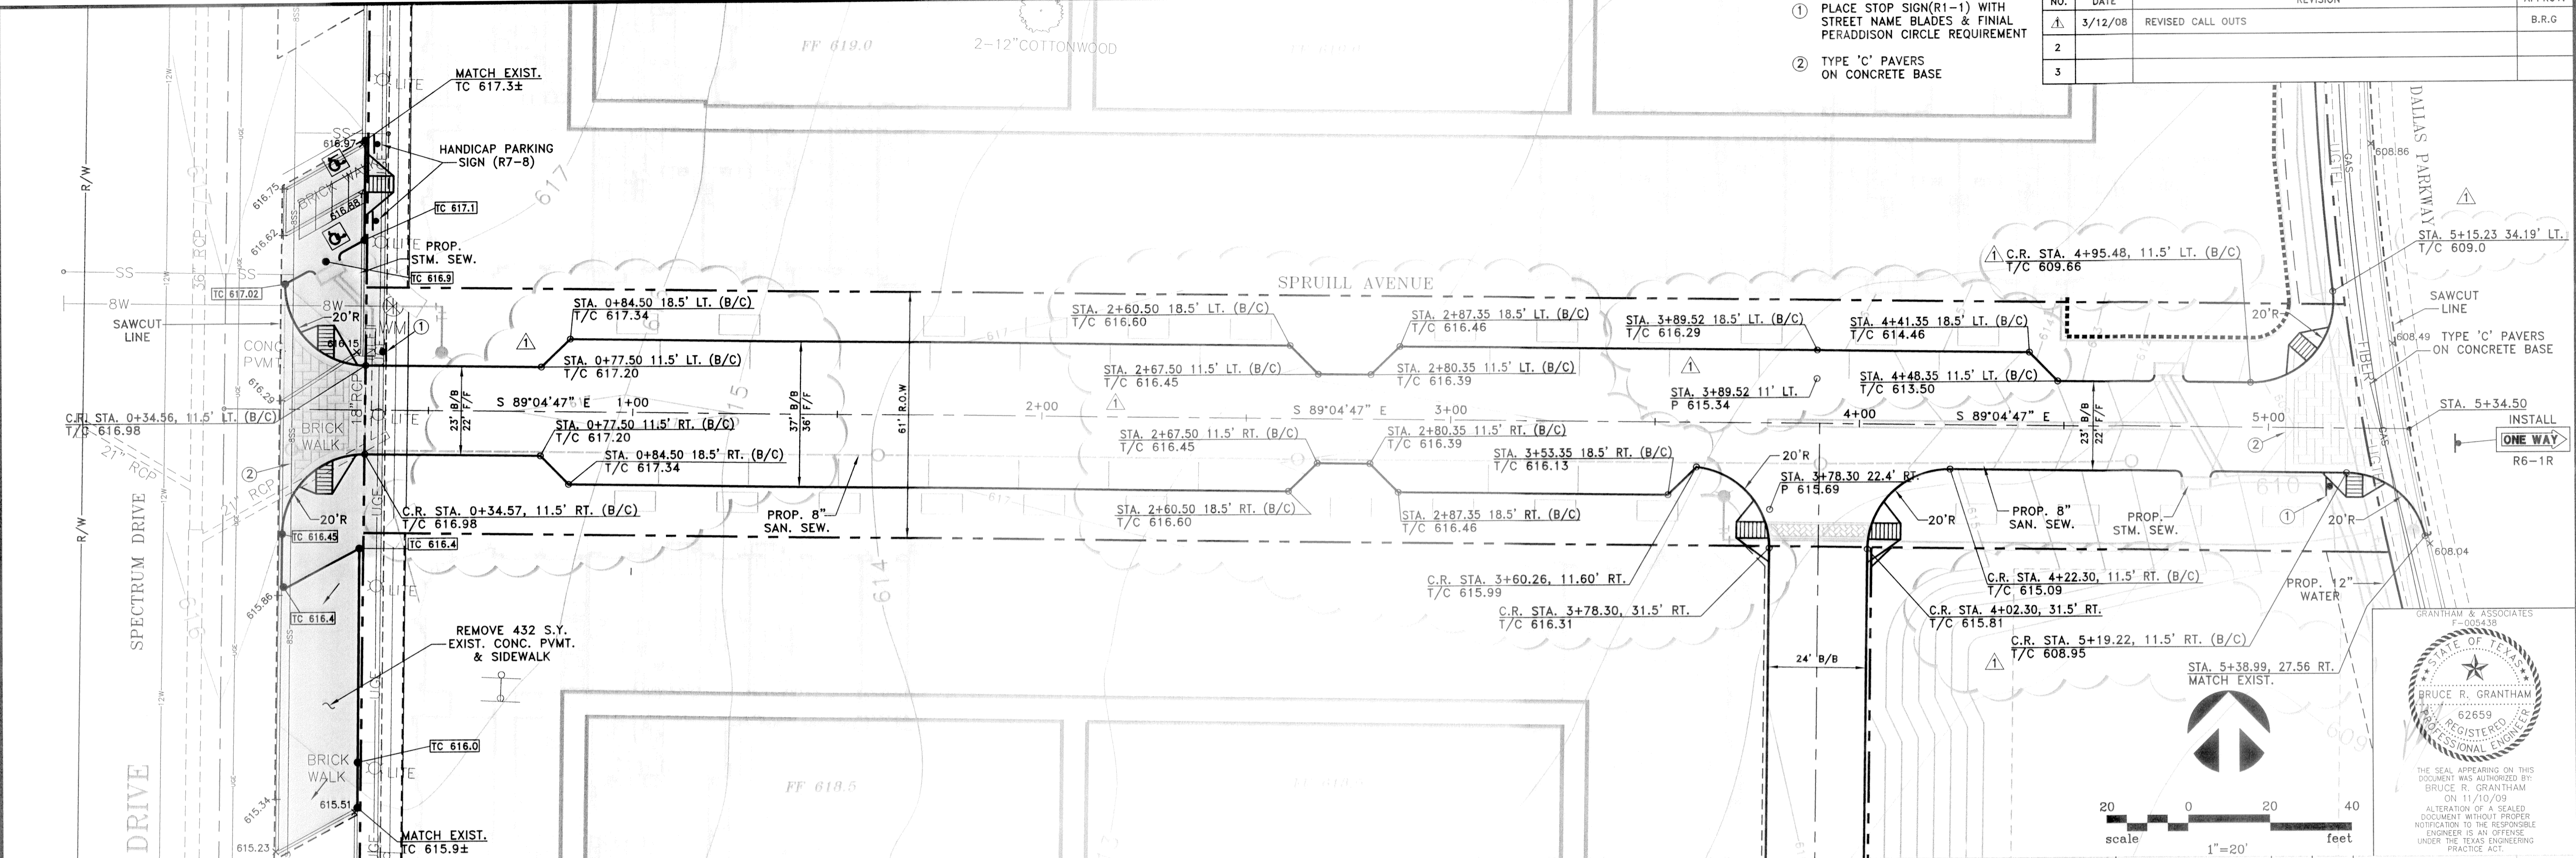

RECORD DRAWING
 BASED ON CONTRACTOR MARKUPS
 NOT FIELD SURVEY

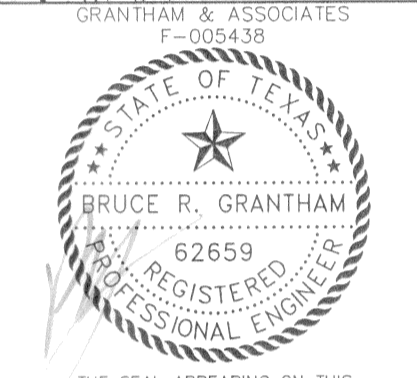

DATE:	MARCH 2008	SCALE:	1"=20'(H)1"=6'(V)	JOB NO.:	1057-06
DRAWN:	G&A	DESIGN:	BRG	REVIEWED:	BRG
				DWG. REV:	1057PAVPP01

MIXED USE DEVELOPMENT
TOWN OF ADDISON
PAVING PLAN & PROFILE

SNK DEVELOPMENT INC.

g&a Grantham & Associates
 Civil Engineering

SHT. 11
OF 11

1919 S. SHILOH ROAD, SUITE 440, L.B. 8 GARLAND, TEXAS 75042 (972) 864-2333(TEL) (972) 864-2334(FAX)