


**STORM SEWER CURVE DATA:**

NUMBER	RADIUS	DELTA	ARC LENGTH	CHORD BEARING	CHORD LENGTH
C1	100.00'	15°56'11"	27.81'	N 20°51'01" W	27.72'

NO.	DATE	REVISION	APPROV.
1	5/14/07	CONNECTION TO TREE DRAIN SHOWN.	B.R.G.
2	10/10/07	REVISED INLET TYPE & STORM SEWER NOTES	B.R.G.
3	11/16/07	REVISED INLET TYPE & STORM SEWER NOTES	B.R.G.

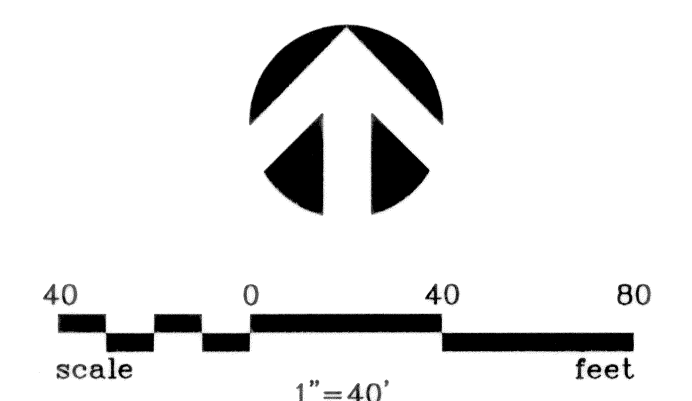

**STORM SYSTEM CALCULATIONS - LINE 'A'**

STATION	DOWN-STREAM	DISTANCE	INCOMING LATERAL	D.A (S) COLLECTED	Q <sub>100</sub> (cfs)	SELECTED PIPE SLOPE (%)	SELECTED PIPE SIZE (in)	PIPE CAPACITY (cfs)	VELOCITY (fps)	Sf (ft/ft)
UP-STREAM	DOWN-STREAM	(ft)	(ft)	(ft)	(cfs)	(%)	(in)	(cfs)	(fps)	(ft/ft)
4+01.01	3+90.45	11.6	8" INLET	5	3.7	0.70%	27	25.9	0.9	0.014%
3+90.45	1+00.00	290.5	LAT A-1	-	25.8	0.70%	27	25.9	6.5	0.66%

**STORM SYSTEM CALCULATIONS - LAT 'A-1'**

STATION	DOWN-STREAM	DISTANCE	INCOMING LATERAL	D.A (S) COLLECTED	Q <sub>100</sub> (cfs)	SELECTED PIPE SLOPE (%)	SELECTED PIPE SIZE (in)	PIPE CAPACITY (cfs)	VELOCITY (fps)	Sf (ft/ft)
UP-STREAM	DOWN-STREAM	(ft)	(ft)	(ft)	(cfs)	(%)	(in)	(cfs)	(fps)	(ft/ft)
0+27.31	0+14.68	12.6	6" INLET	4.10	5.2	1.57%	24	28.3	1.7	0.05%
0+14.68	0+00.00	14.7	LAT A-2	-	22.1	1.57%	24	28.3	7.0	0.95%

**STORM SYSTEM CALCULATIONS - LINE 'A-2'**

STATION	DOWN-STREAM	DISTANCE	INCOMING LATERAL	D.A (S) COLLECTED	Q <sub>100</sub> (cfs)	SELECTED PIPE SLOPE (%)	SELECTED PIPE SIZE (in)	PIPE CAPACITY (cfs)	VELOCITY (fps)	Sf (ft/ft)
UP-STREAM	DOWN-STREAM	(ft)	(ft)	(ft)	(cfs)	(%)	(in)	(cfs)	(fps)	(ft/ft)
1+04.20	0+00	104.2	AD	11, 12, 14, 15, 16, 17	16.9	1.46%	21	19.1	7.0	1.13%

**STORM SYSTEM CALCULATIONS - LINE 'B'**

STATION	DOWN-STREAM	DISTANCE	INCOMING LATERAL	D.A (S) COLLECTED	Q <sub>100</sub> (cfs)	SELECTED PIPE SLOPE (%)	SELECTED PIPE SIZE (in)	PIPE CAPACITY (cfs)	VELOCITY (fps)	Sf (ft/ft)
UP-STREAM	DOWN-STREAM	(ft)	(ft)	(ft)	(cfs)	(%)	(in)	(cfs)	(fps)	(ft/ft)
1+20.17	1+25.35	5.2	6" INLET	6	4.3	4.90%	18	23.2	2.4	0.17%
1+10.00	1+20.17	10.2	AD	1, 3	5.1	4.90%	18	23.2	2.9	0.24%
1+00	1+10.00	10.0	-	-	5.1	14.67%	18	40.2	2.9	0.24%

**STORM SYSTEM CALCULATIONS - LAT '1'**

STATION	DOWN-STREAM	DISTANCE	INCOMING LATERAL	D.A (S) COLLECTED	Q <sub>100</sub> (cfs)	SELECTED PIPE SLOPE (%)	SELECTED PIPE SIZE (in)	PIPE CAPACITY (cfs)	VELOCITY (fps)	Sf (ft/ft)
UP-STREAM	DOWN-STREAM	(ft)	(ft)	(ft)	(cfs)	(%)	(in)	(cfs)	(fps)	(ft/ft)
0+09.97	0+00	10.0	AD	1	2.8	3.20%	18	28.3	1.6	0.071%

**STORM SYSTEM CALCULATIONS - AREA DRAINS FOR BUILDINGS**

DRAIN NUMBER	DISTANCE (ft)	D.A (S) COLLECTED (ft)	Q <sub>100</sub> (cfs)	SELECTED PIPE SLOPE (%)	SELECTED PIPE SIZE (in)	PIPE CAPACITY (cfs)	EXCESS CAPACITY (cfs)
AD-1	180	13	0.8	0.8%	12	3.2	2.4
AD-2	195	18	0.8	1.8%	12	4.8	4.0
AD-3	140	12	2.9	1.0%	12	3.6	0.6
AD-4	186	11, 12	5.9	1.8%	15	8.7	2.8
AD-5	99	10	2.9	4.5%	12	7.7	4.7
AD-6	62	8	2.9	2.8%	15	10.8	5.0
AD-7	138	16	5.9	1.0%	12	3.6	0.6
AD-8	145	15, 16	5.9	1.0%	15	6.5	0.5
AD-8A	40	14, 15, 16, 17	11.0	3.5%	15	12.1	1.1
AD-9	210	14, 17	5.0	2.1%	12	5.2	0.1
AD-10	84	9	0.8	2.8%	12	5.8	4.9

**HEAD LOSS CALCULATIONS**

FROM	TO	Pipe Length (ft)	Q pipe (cfs)	Pipe Size (in)	n	Sf (ft/ft)	HGL Elev.	U/S Elev.	D/S Elev.	V1 (in) ft/sec	V2 (out) ft/sec	V1/2G ft.	V2/2G ft.	Kj	Hk	Design HGL Elev.	Inlet HGL Reg. Analysis Elev.
<b>Line A</b>																	
3+97.46	4+01.01	3.55	3.70	27	0.013	0.00014	609.50	609.50	0.00	0.93	0.00	0.01	1.25	-	0.02	609.51	606.86
3+73.12	3+97.46	24.34	25.80	27	0.013	0.00894	608.96	608.96	0.93	6.49	0.01	0.65	1.00	0.01	0.64	609.50	609.50
1+09.97	3+73.12	263.15	25.80	27	0.013	0.00894	608.37	608.53	6.49	6.49	0.65	0.65	0.48	-	0.31	608.69	608.69
1+00	1+09.97	6.97	25.80	27	0.013	0.00894	606.30	606.25	6.49	6.49	0.65	0.65	0.35	-	0.23	606.53	606.53
<b>LAT A-1</b>																	
0+14.64	0+27.31	12.67	5.20	24	0.013	0.00053	607.40	607.39	0.00	1.66	0.00	0.04	1.25	-	0.05	607.45	609.29
0+00	0+14.64	14.64	22.10	24	0.013	0.00894	606.67	606.53	1.66	7.03	0.04	0.77	1.00	0.04	0.73	607.39	607.39
<b>LAT A-2</b>																	
0+00	0+99.20	99.20	16.90	21	0.013	0.01138	608.52	607.39	0.00	7.03	0.00	0.77	0.50	0.00	0.77	609.29	609.29
<b>Line B</b>																	
1+18.42	1+25.35	6.93	2.80	18	0.013	0.00071	611.66	611.65	0.00	1.58	0.00	0.04	1.20	-	0.05	611.70	613.23
1+11.39	1+18.42	7.03	6.50	18	0.013	0.00383	611.47	611.44	1.58	3.68	0.04	0.21	0.75	0.03	0.18	611.65	611.65
1+00	1+11.39	11.39	6.50	18	0.013	0.00383	611.37	611.33	3.68	3.68	0.21	0.21	0.35	-	0.07	611.44	611.44
	1+11.39	22.00	6.50	18	0.013	0.00383	611.33	611.24	3.68	3.68	0.21	0.21	0.35	-	0.00	611.33	611.33
	1+10	49.00	6.50	21	0.013	0.00168	611.20	611.12	3.68	2.70	0.21	0.11	0.35	-	0.04	611.24	611.24
<b>LAT 1</b>																	
0+00	0+09.97	9.97	16.90	21	0.013	0.01138	607.81	607.70	0.00	7.03	0.00	0.77	1.25	-	0.96	608.77	607.14

Notes:  
 1. HGL elevation at connection to existing pipe in Dallas North Parkway assumed to be the top of pipe.  
 2. HGL elevation at connection to existing pipe in Spectrum Drive taken from Spectrum Drive Extension Plans

**STORM SEWER NOTES:**


- CONTRACTOR SHALL REFER TO LANDSCAPE PLANS FOR LOCATION OF ALL AREA DRAINS AND SUBSURFACE TREE DRAINS.
- CONTRACTOR SHALL REFER TO BUILDING PLANS FOR LOCATION OF ALL ROOF DRAINS.
- ALL LANDSCAPE AREA DRAINS SHALL BE CONNECTED WITH 6" PVC SDR-35 DIRECTLY TO ADJACENT PVC STORM SEWERS SHOWN IN THIS SHEET AT 45 DEGREE ANGLE.
- ALL TREE WELL DRAINS SHALL BE CONNECTED WITH 4" PVC SDR-35 DIRECTLY TO ADJACENT PVC STORM SEWERS SHOWN IN THIS SHEET AT 90 DEGREE ANGLE.
- ALL ROOF DRAINS SHALL BE CONNECTED WITH PVC SDR-35 (PIPE SIZE TO MATCH ROOF DRAIN SIZE) DIRECTLY TO ADJACENT PVC STORM SEWERS SHOWN IN THIS SHEET AT 45 DEGREE ANGLE.
- CONTRACTOR TO CONTACT DIGESTS AND POTHOLES ALL POTENTIAL CONFLICTS WITH PROPOSED DRAINAGE IMPROVEMENTS PRIOR TO CONSTRUCTION. CONTACT ENGINEER IMMEDIATELY IF A CONFLICT IS IDENTIFIED.
- HORIZONTAL ALIGNMENT OF ALL PVC PIPE FOR AREA DRAINS, SUBSURFACE TREE DRAINS AND ROOF DRAINS (BELOW GRADE) SHALL BE THE SHORTEST DIRECT ROUTE TO THE ADJACENT PVC STORM SEWER SHOWN ON THIS SHEET.
- CONTRACTOR SHALL REFER TO LANDSCAPE COURTYARD PLANS FOR INFORMATION ON THE 10' COURTYARD DRAINS.

**RECORD DRAWING**  
 BASED ON CONTRACTOR MARKUPS  
 NOT FIELD SURVEY

- INSTALL 15" PVC SDR-35 90° BEND  
FL. 15" = 607.0  
N = 5446.52  
E = 4899.65
- INSTALL 15" PVC SDR-35 45° BEND  
FL. 15" = 609.0  
N = 5342.64  
E = 4759.32
- INSTALL 15" PVC SDR-35 45° BEND  
FL. 15" = 609.7  
N = 5287.69  
E = 4755.32
- INSTALL 15"x12" PVC SDR-35 45° WYE  
FL. 15" = 608.7  
N = 5306.86  
E = 4775.11
- INSTALL 15"x12" PVC SDR-35 45° WYE  
FL. 15" = 606.9  
N = 5446.40  
E = 4904.65
- INSTALL 12" PVC SDR-35 45° BEND  
FL. 12" = 612.5  
N = 5362.96  
E = 4444.92
- INSTALL 12" PVC SDR-35 45° BEND  
FL. 12" = 609.9  
N = 5341.38  
E = 4837.57
- INSTALL 12" PVC SDR-35 45° BEND  
FL. 12" = 609.0  
N = 5327.24  
E = 4851.27
- INSTALL 12" PVC SDR-35 30° BEND  
FL. 12" = 608.6  
N = 5297.12  
E = 4443.86
- INSTALL 12" PVC SDR-35 45° BEND  
FL. 12" = 607.0  
N = 5441.52  
E = 4899.57
- CONNECT TO ROOF DRAIN (SEE ARCHITECT PLAN)

**LEGEND**

- PVC SDR-35 STORM COLLECTION PIPE
- - - PVC SDR-26 STORM COLLECTION PRESSURE PIPE
- == RCP STORM SEWERS (CLASS III)
- CURB INLET

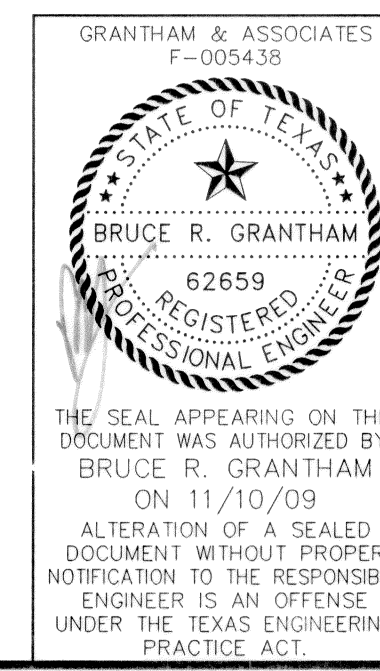

DATE: FEBRUARY 2009 SCALE: 1"=40' JOB NO.: 1057-06  
 DRAWN: G&A DESIGN: BRG REVIEWED: BRG DWG: 1057STORMPLN01

MIXED USE DEVELOPMENT  
 TOWN OF ADDISON  
 STORM SEWER PLAN

**SNK DEVELOPMENT INC.**

g&a Grantham & Associates  
 Civil Engineering

1919 S. SHILOH ROAD, SUITE 440, L.B. GARLAND, TEXAS 75042 (972) 864-2333 (TEL) (972) 864-2334 (FAX)

SHT. 7  
 OF 11