


SOUTHERN PACIFIC RAILROAD  
(100' R.O.W.)

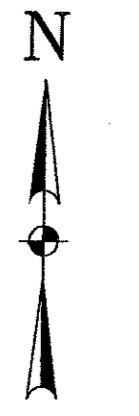

0 15 30 45 60  
SCALE IN FEET

**LEGEND**


- 8" SS → EXIST. SANITARY SEWER
- 12" W → EXIST. WATER
- RCP → EXIST. STORM SEWER
- ⊗ → OVERHEAD ELECTRIC
- - - - - PROPOSED SANITARY SEWER
- 6" W → PROPOSED WATER
- 12" RCP → PROPOSED STORM SEWER
- - - - - PROPERTY LINE
- - - - - EASEMENT LINE
- SF — PROPOSED SILT FENCE
- PROPOSED INLET PROTECTION

**BENCHMARKS:**

- BM#1 - "I" CUT ON INLET SEE CORNER OF BELTLINE AND SURVEYOR  
ELEV= 594.94
- BM#2 - "I" CUT ON W. TBC COMMERCIAL DR. @ 2ND FIRE HYDRANT NORTH OF BELTLINE RD.  
ELEV= 586.94

OSTEOMED CORPORATION FACILITY  
ADDISON, TEXAS

THE SEAL APPEARING ON THIS DRAWING HAS APPROVED BY SENATOR CHAVAN, P.L. 73288 ON 02-27-02. PROPER NOTICE TO THE PROFESSIONAL ENGINEER IS AN OFFENSE UNDER THE TEXAS ENGINEERING PRACTICE ACT. THIS DRAWING IS THE PROPERTY OF HALFF ASSOCIATES, INC. AND IS NOT TO BE REPRODUCED OR TRANSMITTED IN ANY FORM OR BY ANY MEANS, ELECTRONIC OR MECHANICAL, INCLUDING PHOTOCOPYING, RECORDING, OR BY ANY INFORMATION STORAGE AND RETRIEVAL SYSTEM, WITHOUT THE WRITTEN PERMISSION OF HALFF ASSOCIATES, INC. 8616 NORTHWEST PLAZA DRIVE, DALLAS, TEXAS 75225

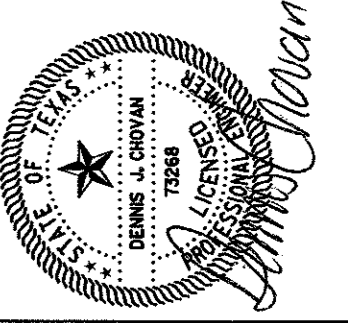

**Half Associates, Inc.**  
ENGINEERS • ARCHITECTS • SCIENTISTS • PLANNERS • SURVEYORS  
8616 NORTHWEST PLAZA DRIVE  
DALLAS, TEXAS 75225  
TEL (214) 346-6300  
FAX (214) 739-0055

Project No:	AVO # 20079	
Issued:	05/13/02	
Revisions:		
No.	Date	Description
1	05/13/02	INLET RELOCATION
2	8/20/2002	AS PER SITE CHANGES
Drawn by:	DD	
Checked by:	DJC	
Sheet Title:	EROSION CONTROL PLAN	
Sheet Number:	C1.1	

CONSTRUCT SILT FENCE  
SEE SHEET C1.2 FOR DETAIL

INSTALL DROP INLET PROTECTION  
SEE SHEET C1.2 FOR DETAIL

INSTALL DROP INLET PROTECTION  
SEE SHEET C1.2 FOR DETAIL

BELT LINE - MARSH BUSINESS PARK  
LOT 4F, BLOCK 1  
VOL. 95100, PG. 3275  
D.R.D.C.T.

INSTALL CURB INLET PROTECTION  
SEE SHEET C1.2 FOR DETAIL

INSTALL DROP INLET PROTECTION  
SEE SHEET C1.2 FOR DETAIL

PROPOSED 30' X 30'  
CONSTRUCTION ENTRANCE  
SEE SHEET C1.2 FOR DETAIL

CONSTRUCT SILT FENCE  
SEE SHEET C1.2 FOR DETAIL

BELT LINE - MARSH BUSINESS PARK  
LOT 1, BLOCK 1  
VOL. 83042, PG. 425  
D.R.D.C.T.

REALTY ROAD  
(84' R.O.W.)

ARAPAHO ROAD  
(VARIABLE WIDTH R.O.W.)

COMMERCIAL DRIVE  
(60' R.O.W.)

BELT LINE - MARSH BUSINESS PARK  
LOT 1, BLOCK 3R  
VOL. 95100, PG. 3275  
D.R.D.C.T.

"AS-BUILT PLAN BASED ON CONTRACTOR'S RECORD DRAWINGS"

