


OSTEOMED CORPORATION FACILITY  
ADDISON, TEXAS

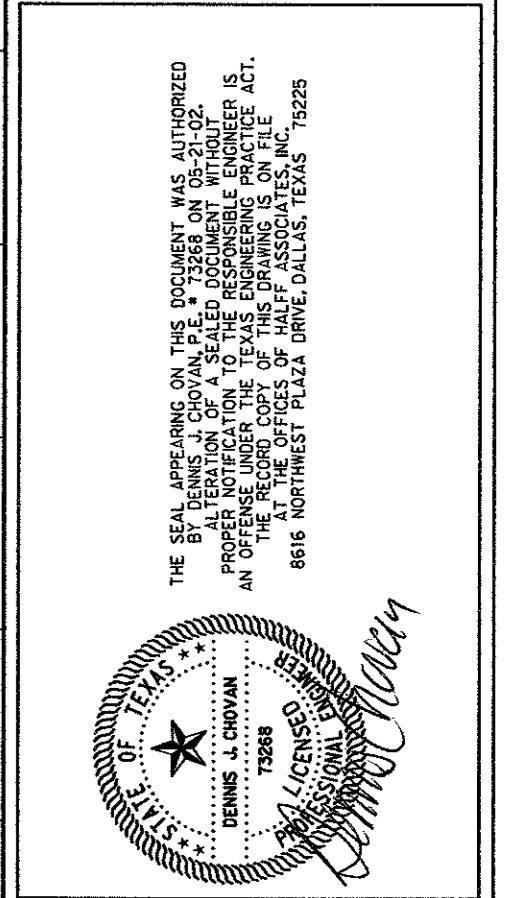

**Half Associates, Inc.**  
ENGINEERS • ARCHITECTS • SCIENTISTS • PLANNERS • SURVEYORS  
865 NORTHWEST PLAZA DRIVE  
DALLAS, TEXAS 75225  
FAX (214) 739-0095

Project No:	AVO # 20079	
Issued:	05-15-02	
Revisions:		
No.	Date	Description
1	09/30/02	INLET RELOCATION
2	8/20/2002	AS PER SITE CHANGES
3	11/19/02	"AS-BUILT" CHANGES
Drawn by:	DD	
Checked by:	DJC	
Sheet Title:	STORM DRAINAGE PROFILES	
Sheet Number:	C5.3	

"AS-BUILT PLAN BASED ON CONTRACTOR'S RECORD DRAWINGS"