



JOB NO SHEET

JOB NO SHEET


JOB NO SHEET

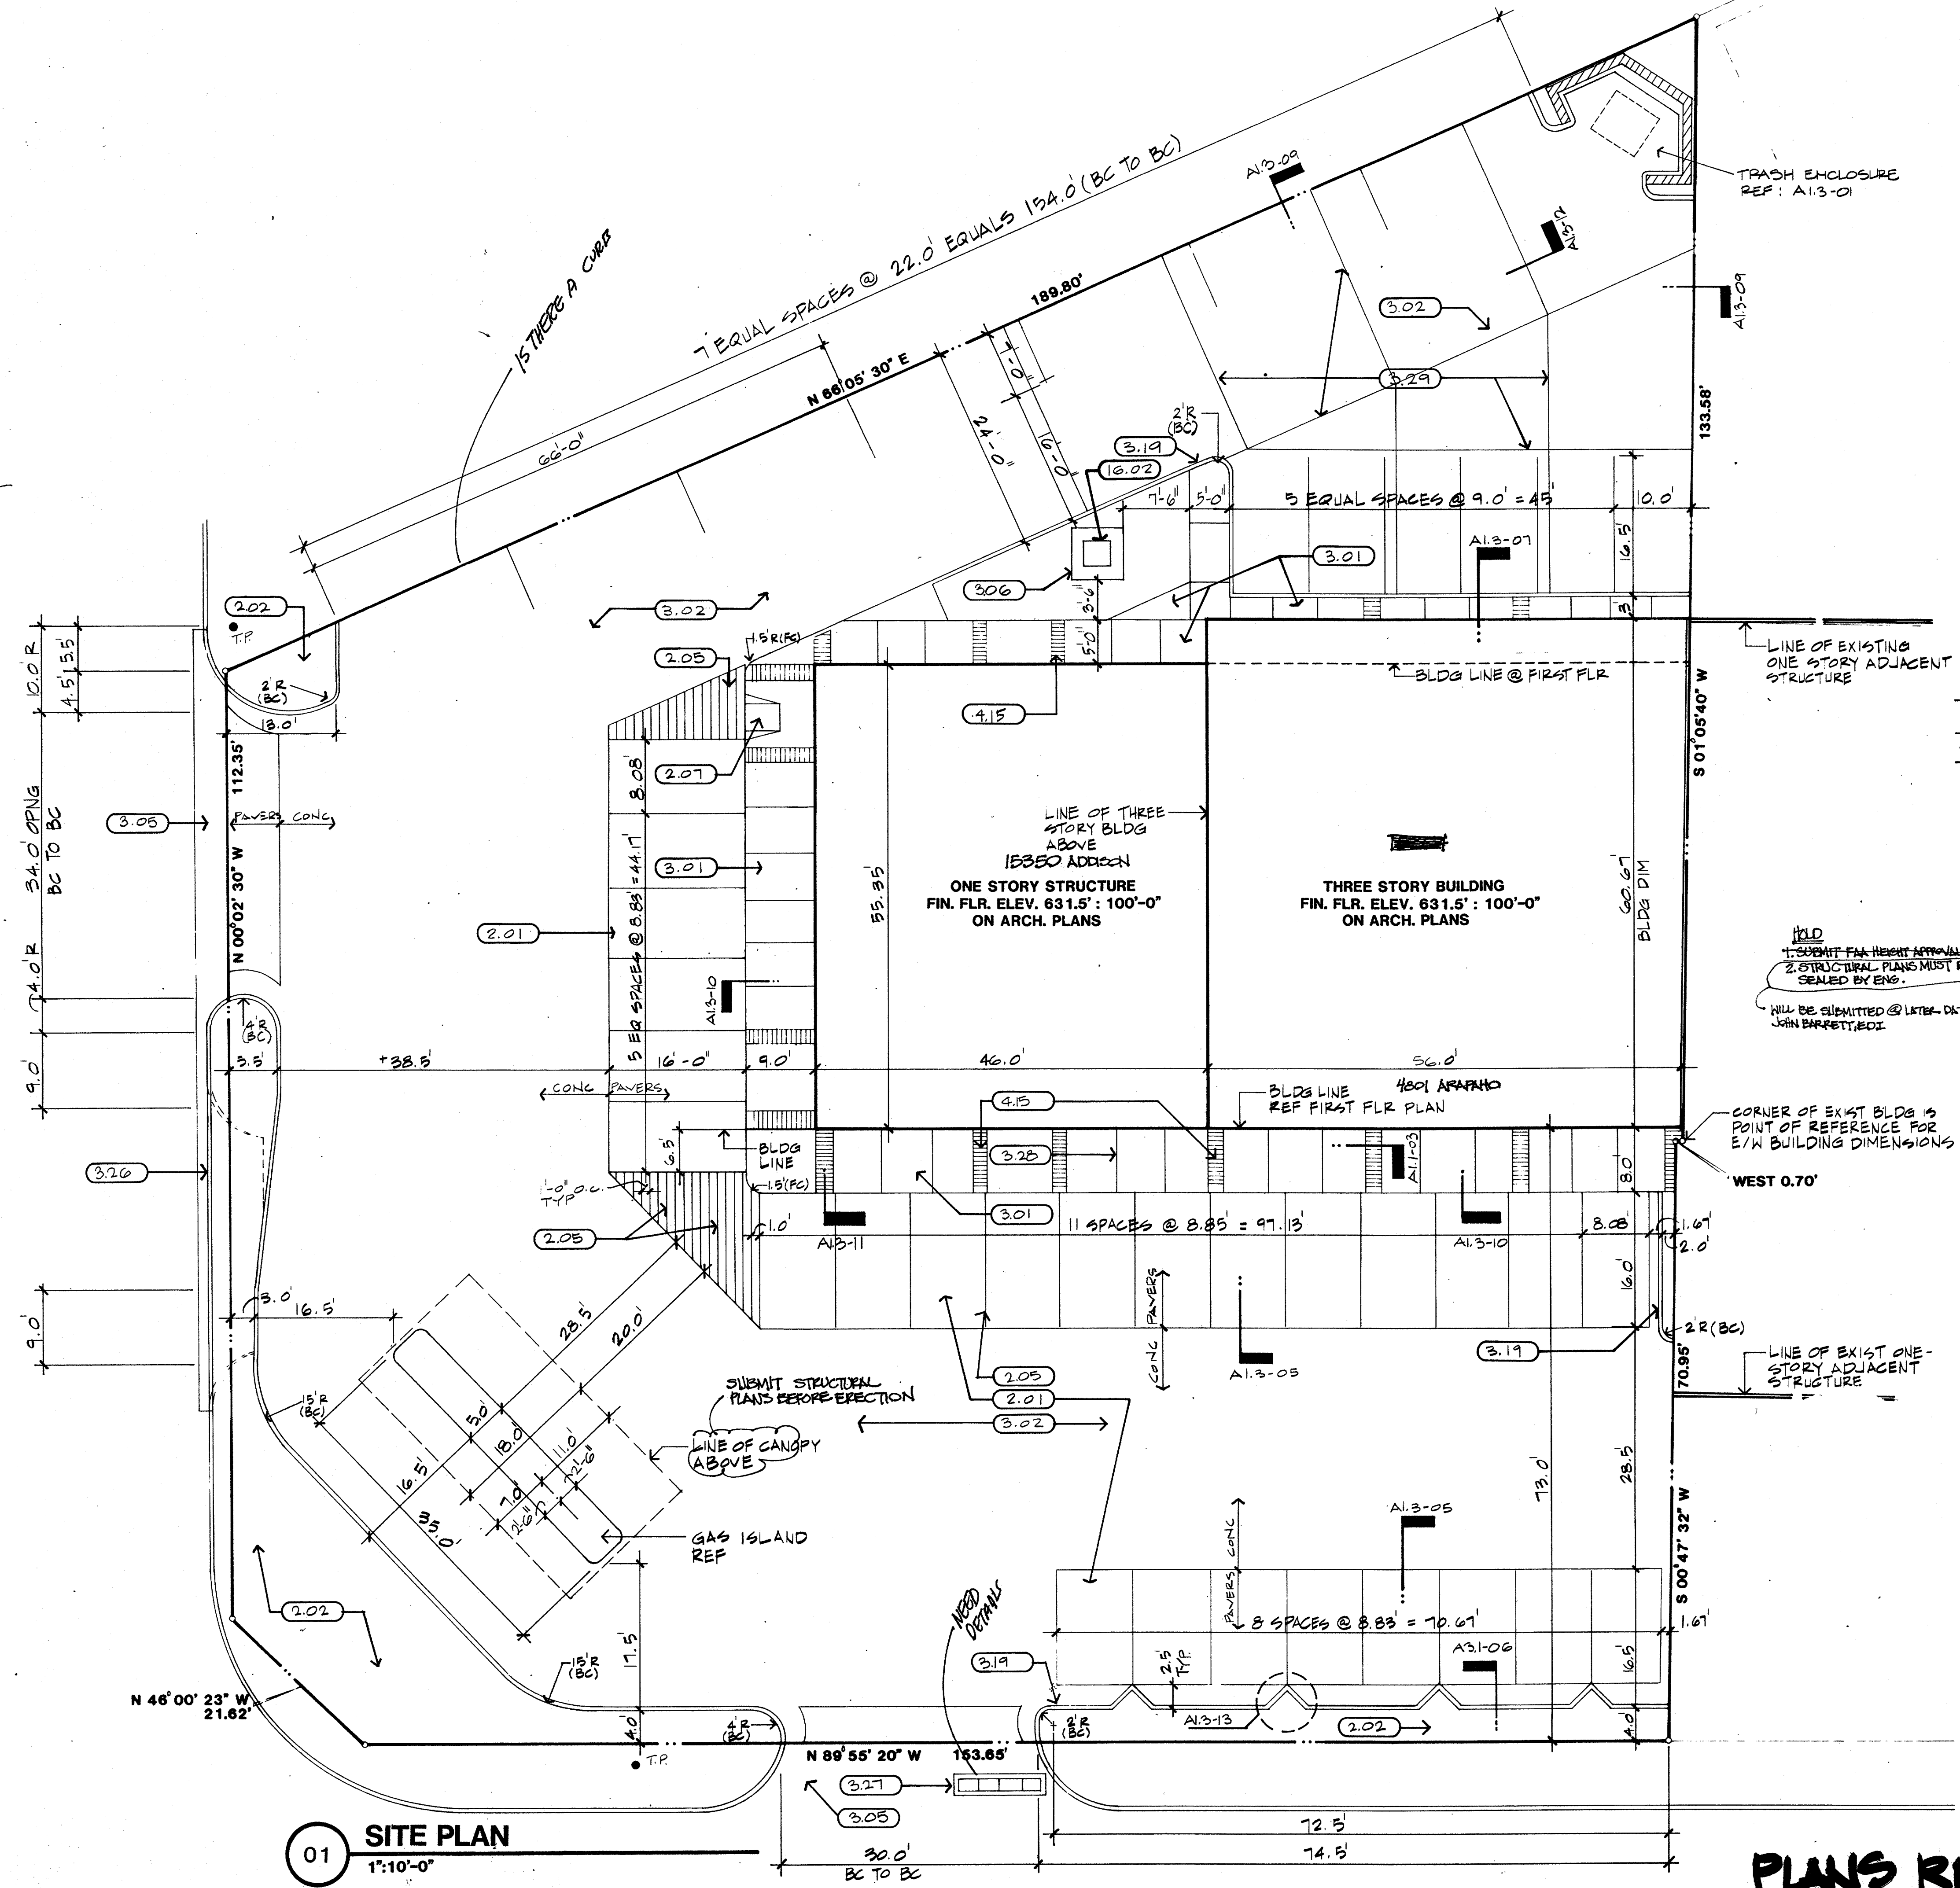

01 SITE PLAN
1"=10'-0"

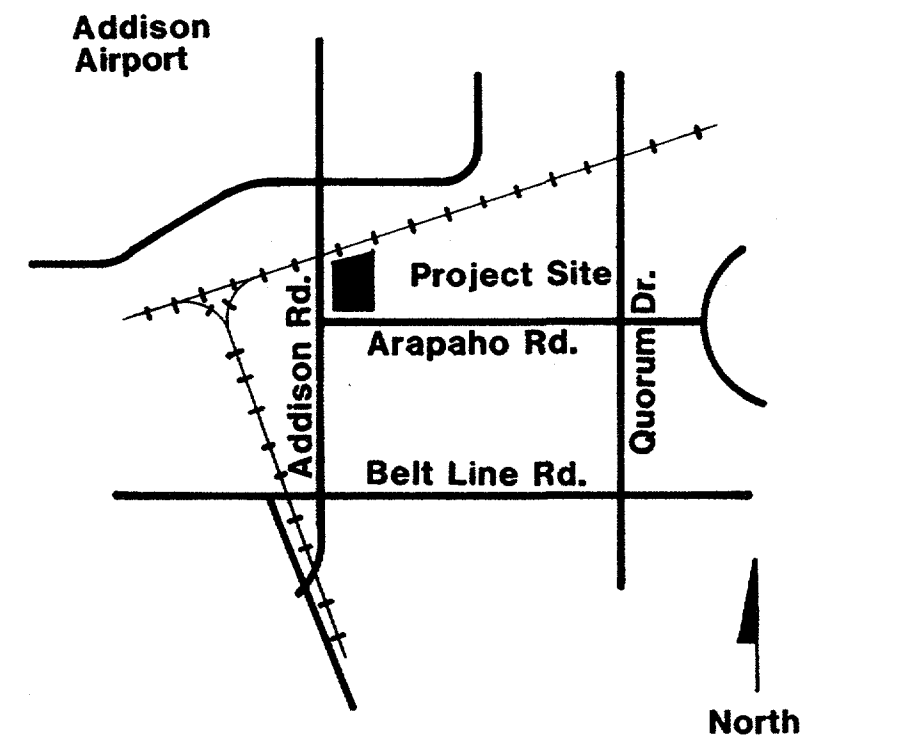

02 LOCATION MAP
NTS

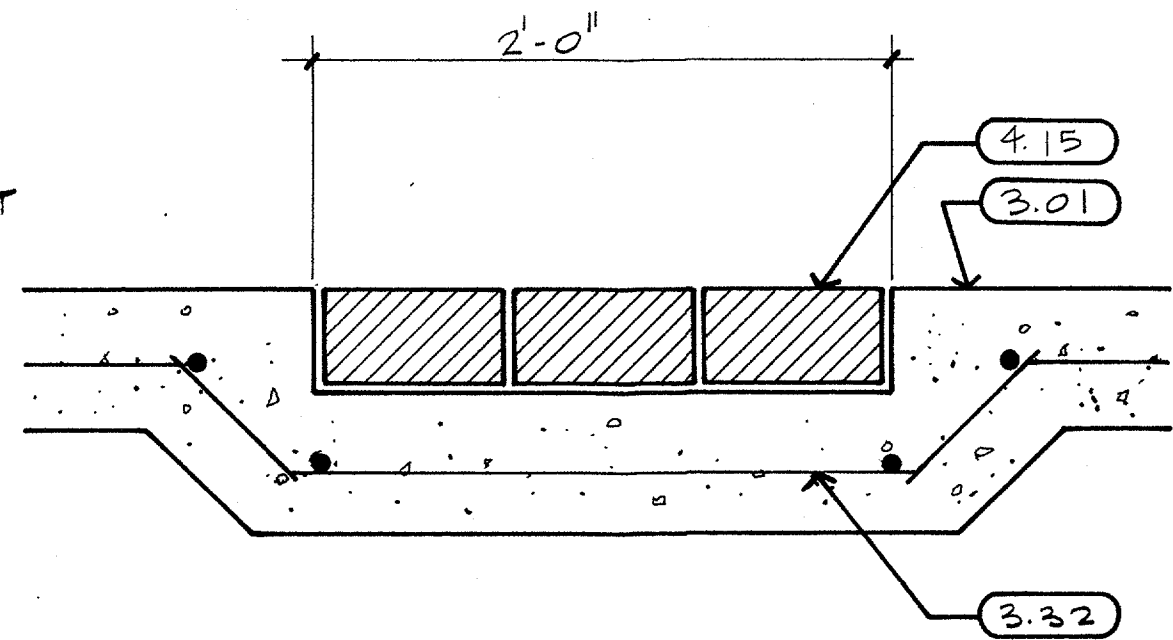

03 SECTION
1 1/2"=1'-0"

HOLD
1. SUBMIT F.A. HEIGHT APPROVAL.
2. STRUCTURAL PLANS MUST BE SEALED BY ENG.
WILL BE SUBMITTED @ LATER DATE PER JOHN BARRETT, E.O.I.

VII CONSTRUCTION (W/ 1STORY INCREASE ALLOWED WITH SPRINKLER)
B-2 CONSTRUCTION (R-1 MAY BE IN OFFICE BLDG.)

INSPECTION REVIEW	HOLD	APPROVED	REVIEWED BY
BUILDING	#	NOTES 3/21/85	DP
PLUMBING		3/21/85	J.C.P.
ELECTRICAL		3/22/85	ROC
MECHANICAL		4-2-85	
HEALTH		OK Note released per Neil	

ELEC PLANS ON A1-7 & IN 7-11 INTERIOR PLANS
PLUG " " A2.4 " " " "

DEPARTMENTAL REVIEW	HOLD	APPROVED	REVIEWED BY
FIRE		3-28-85	TMS
ENGINEERING		4-19-85	CMH
UTILITIES			
STREETS		5-8-85	RDT
LANDSCAPE			


submit sprinkler plans... plans must be approved by STATE before C.O. issued

WHERE WILL UNDERGROUND GAS STORAGE TANKS BE LOCATED?



PLANS RECVD 3.20.85

ISSUED FOR PERMIT ONLY

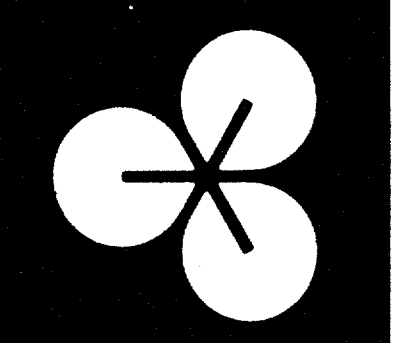

EDI ARCHITECTS, INC.
ARCHITECTURE PLANNING ENGINEERING INTERIOR DESIGN
3430 WALNUT HILL LANE
SUITE 100, DALLAS, TEXAS 75231
DALLAS, TEXAS 75231
814 / 750-1848

Old Town 7-11/Strip Center
Addison, Texas
Ben Pinnell

DATE: 14 MAR 85

SHEET NO:

A1.1
OF SHEETS

JOB NO: 8431