


SCALE (IN FEET)  
0 10 20 40

EXISTING RAIL LINE

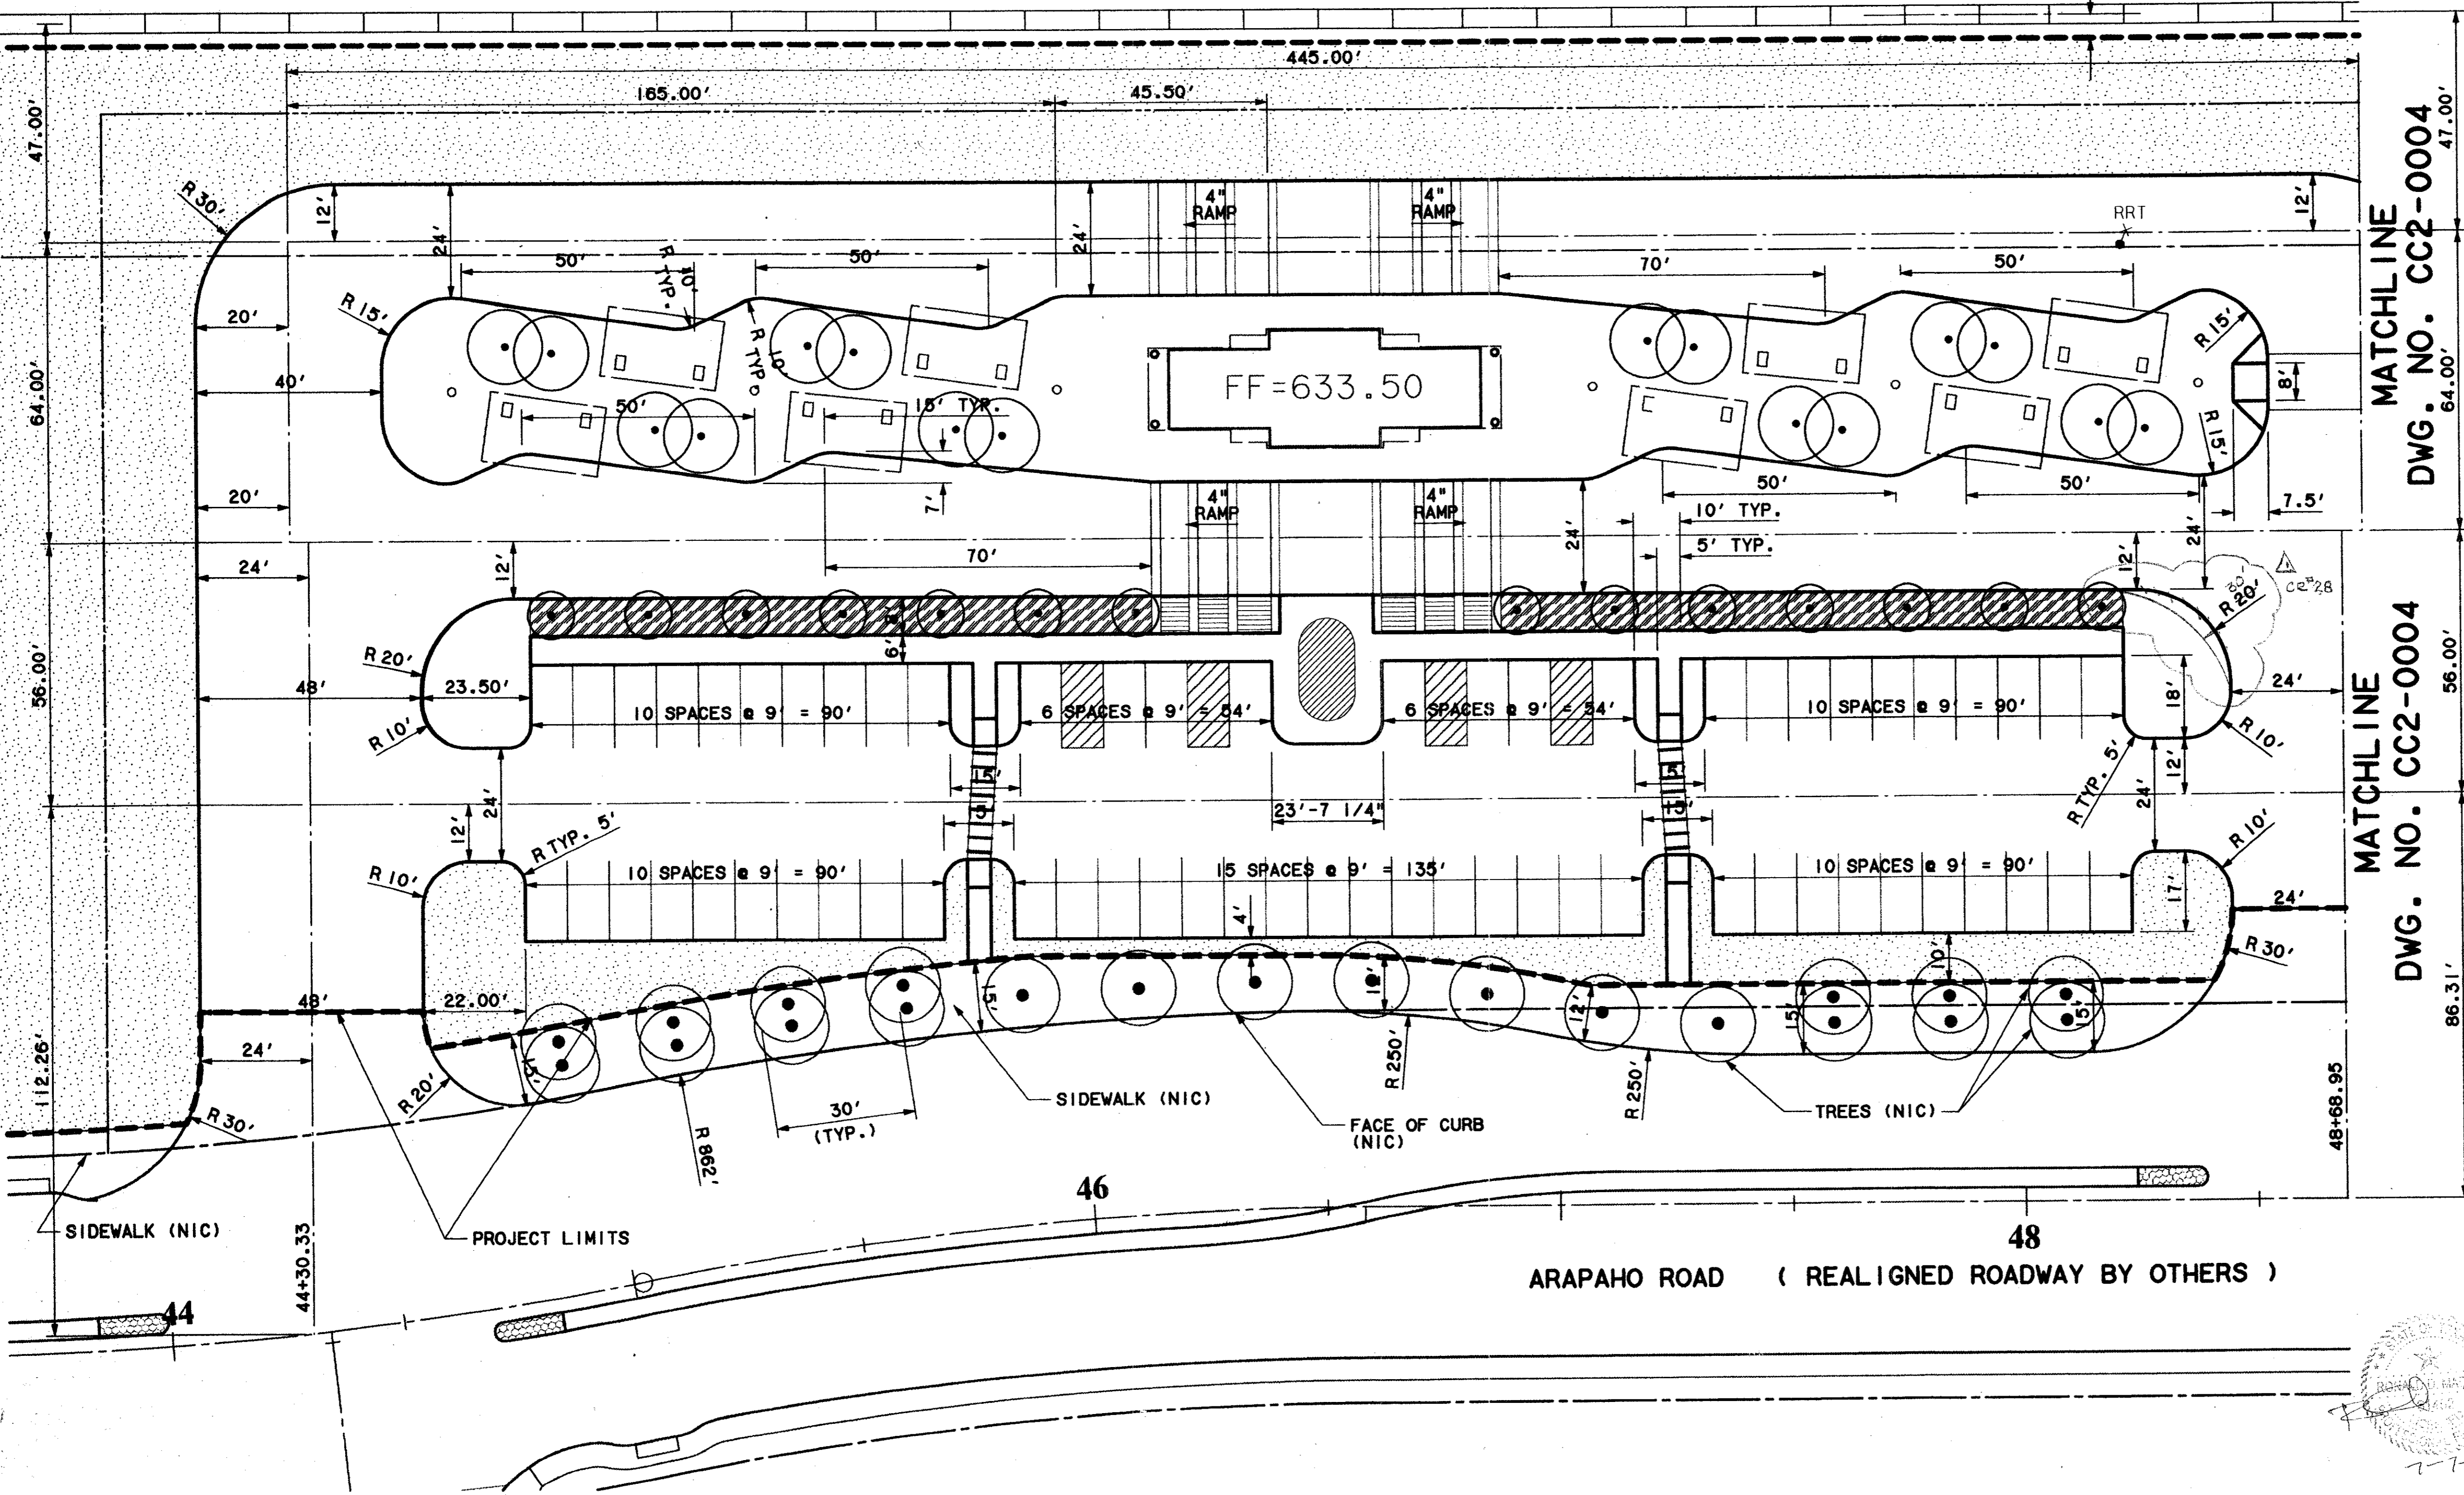

MATCHLINE  
DWG. NO. CC2-0004

MATCHLINE  
DWG. NO. CC2-0004

**NOTES:**

1. ALL WORK TO BE DONE BY THIS CONTRACTOR IS DELINEATED BY PROJECT LIMITS.
2. ALL DIMENSIONS TO CURBS ARE TO FACE OF CURB.
3. ALL WORK OUTSIDE PROJECT LIMIT LINE ARE NOT IN CONTRACT (NIC) UNLESS OTHERWISE SHOWN.
4. FOR BUS BAY LENGTH REFER TO DETAIL 3/CC6-0002.

**CONFORMED**

CONTRACT SHEET No. 14 OF 95

**ADDISON  
TRANSIT CENTER  
PAVING DIMENSIONS**

REV	DATE	DESCRIPTION	BY	ENG	CHK	APP	REV	DATE	DESCRIPTION	BY	ENG	CHK	APP
△	8/30/99	RECORD (AS-BUILT) DRAWINGS		SLM		SLM	△						
△							△						
△							△						
△							△						
△							△						



WENDY LOPEZ & ASSOC.  
LOCKWOOD, ANDREWS & NEWMAN  
THE SWA GROUP  
GERARD & ASSOCIATES  
ZAXON



SCALE	1"=20'
DRAWN	D. KRUCIAK
DESIGNED	P. ZHAO
CHECKED	V. STEVENS
IN CHARGE	V. STEVENS
DATE	AUG. 14, 1997

CONTRACT C-97000136 DWG No. CC2-0003 REV 0