


N 5164.0330  
E 4906.2830  
2'x2' GRATE INLET  
TOP 625.80  
FL 622.35

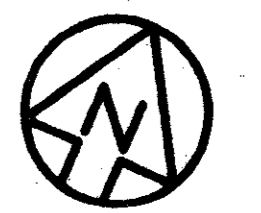

SCALE (IN FEET)  
0 20 40 80

01 DETAIL

A PROFILE  
CC2-0005

B PROFILE  
CC2-0005

C PROFILE  
CC2-0005

01 DETAIL  
CC6-0001

01 DETAIL  
CC6-0001

04 DETAIL  
LC2-0004

TREEWELL DRAIN LINE 01  
SCALE: 1"=20'


NOTE:  
1. SEE DWG. CC5-0006 FOR FINE GRADING IN PLATFORM AREA, SIDEWALKS, & PARKWAY  
2. REFER TO DWG. GC1-0004 FOR GENERAL NOTES ON COMPACTION.  
3. SEE DWG. CC6-0001 FOR CONTROL POINT LOCATION @ INLETS.

BENCHMARKS  
TBM-1  
60d NAIL IN UTILITY POLE AT THE SOUTHEAST CORNER OF JULIAN AND BROADWAY ELEV.=632.50  
TBM-2  
"D" CUT ON SOUTHEAST CORNER OF CONCRETE WALK AT FRONT ENTRANCE TO 4805 ARAPAHO ROAD. ELEV.=630.61

**CONFORMED**

CONTRACT SHEET No. 17 OF 95

REV	DATE	DESCRIPTION	BY	ENG	CHK	APP	REV	DATE	DESCRIPTION	BY	ENG	CHK	APP
△	8/30/99	Record As Built Summary		RDM		DLW							
△													
△													
△													
△													

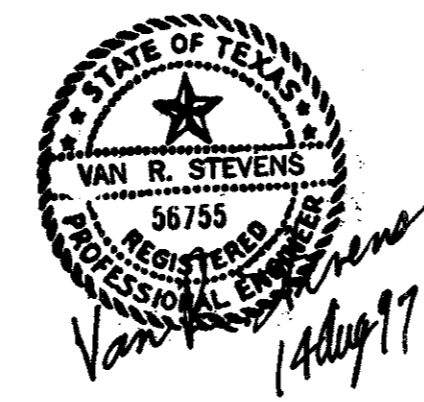

WENDY LOPEZ & ASSOC.  
LOCKWOOD, ANDREWS & NEWNAM  
THE SWA GROUP  
GERARD & ASSOCIATES  
ZAXON

**WLA**  
WENDY LOPEZ & ASSOCIATES, INC.  
ENGINEERING • SURVEYING • CONSTRUCTION SERVICES  
102 MARKET CENTER BLVD - SUITE 200  
DALLAS, TEXAS 75201  
(972) 76-7777

**DART PROJECT**

SCALE 1"=40'

DRAWN D. KRUCIAK  
DESIGNED P. ZHAO  
CHECKED V. STEVENS  
IN CHARGE V. STEVENS  
DATE AUG. 14, 1997

CAES

**ADDISON TRANSIT CENTER DRAINAGE AND GRADING PLAN**

CONTRACT C-97000136 DWG No. CC5-0002 REV 01