
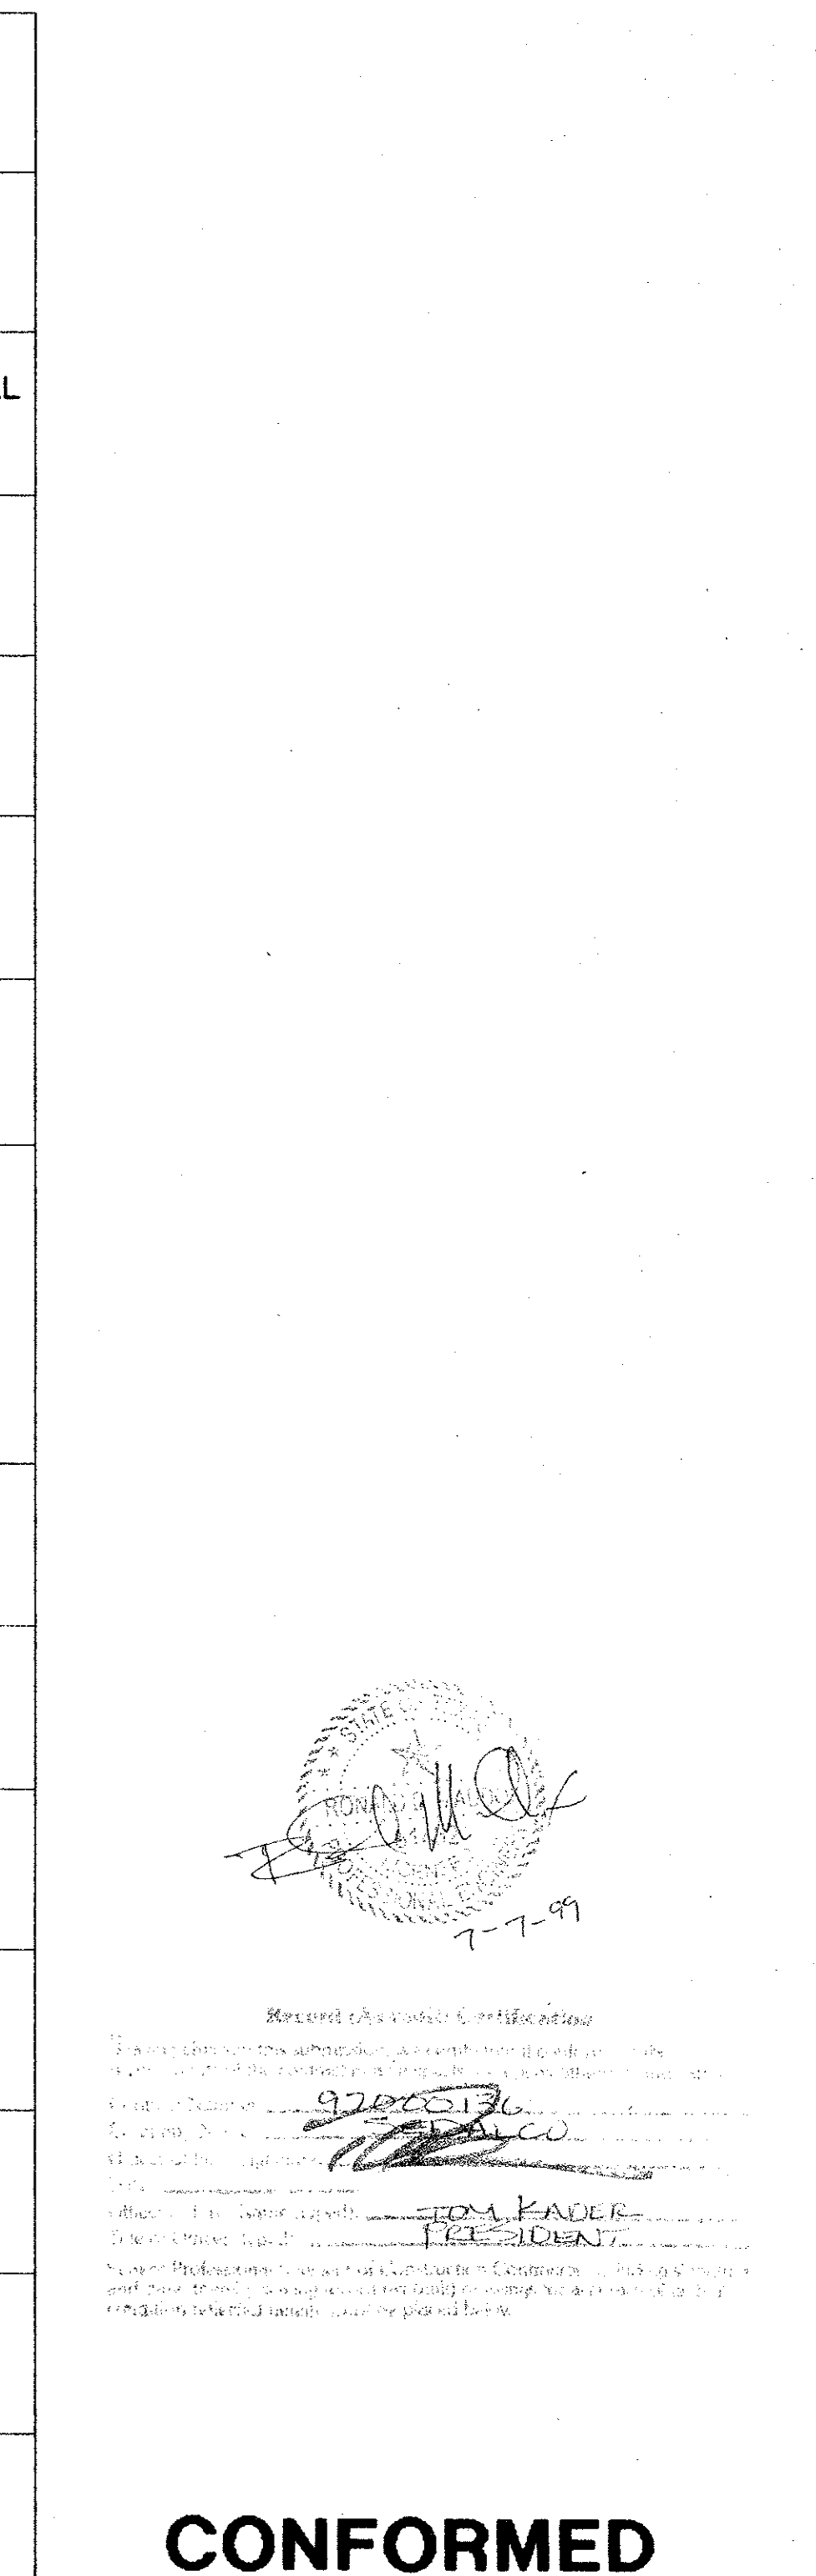


\\server\nti-cadd\94010.212\sh\at
14-AUG-97
DART, TBL
JAMES LANDRY

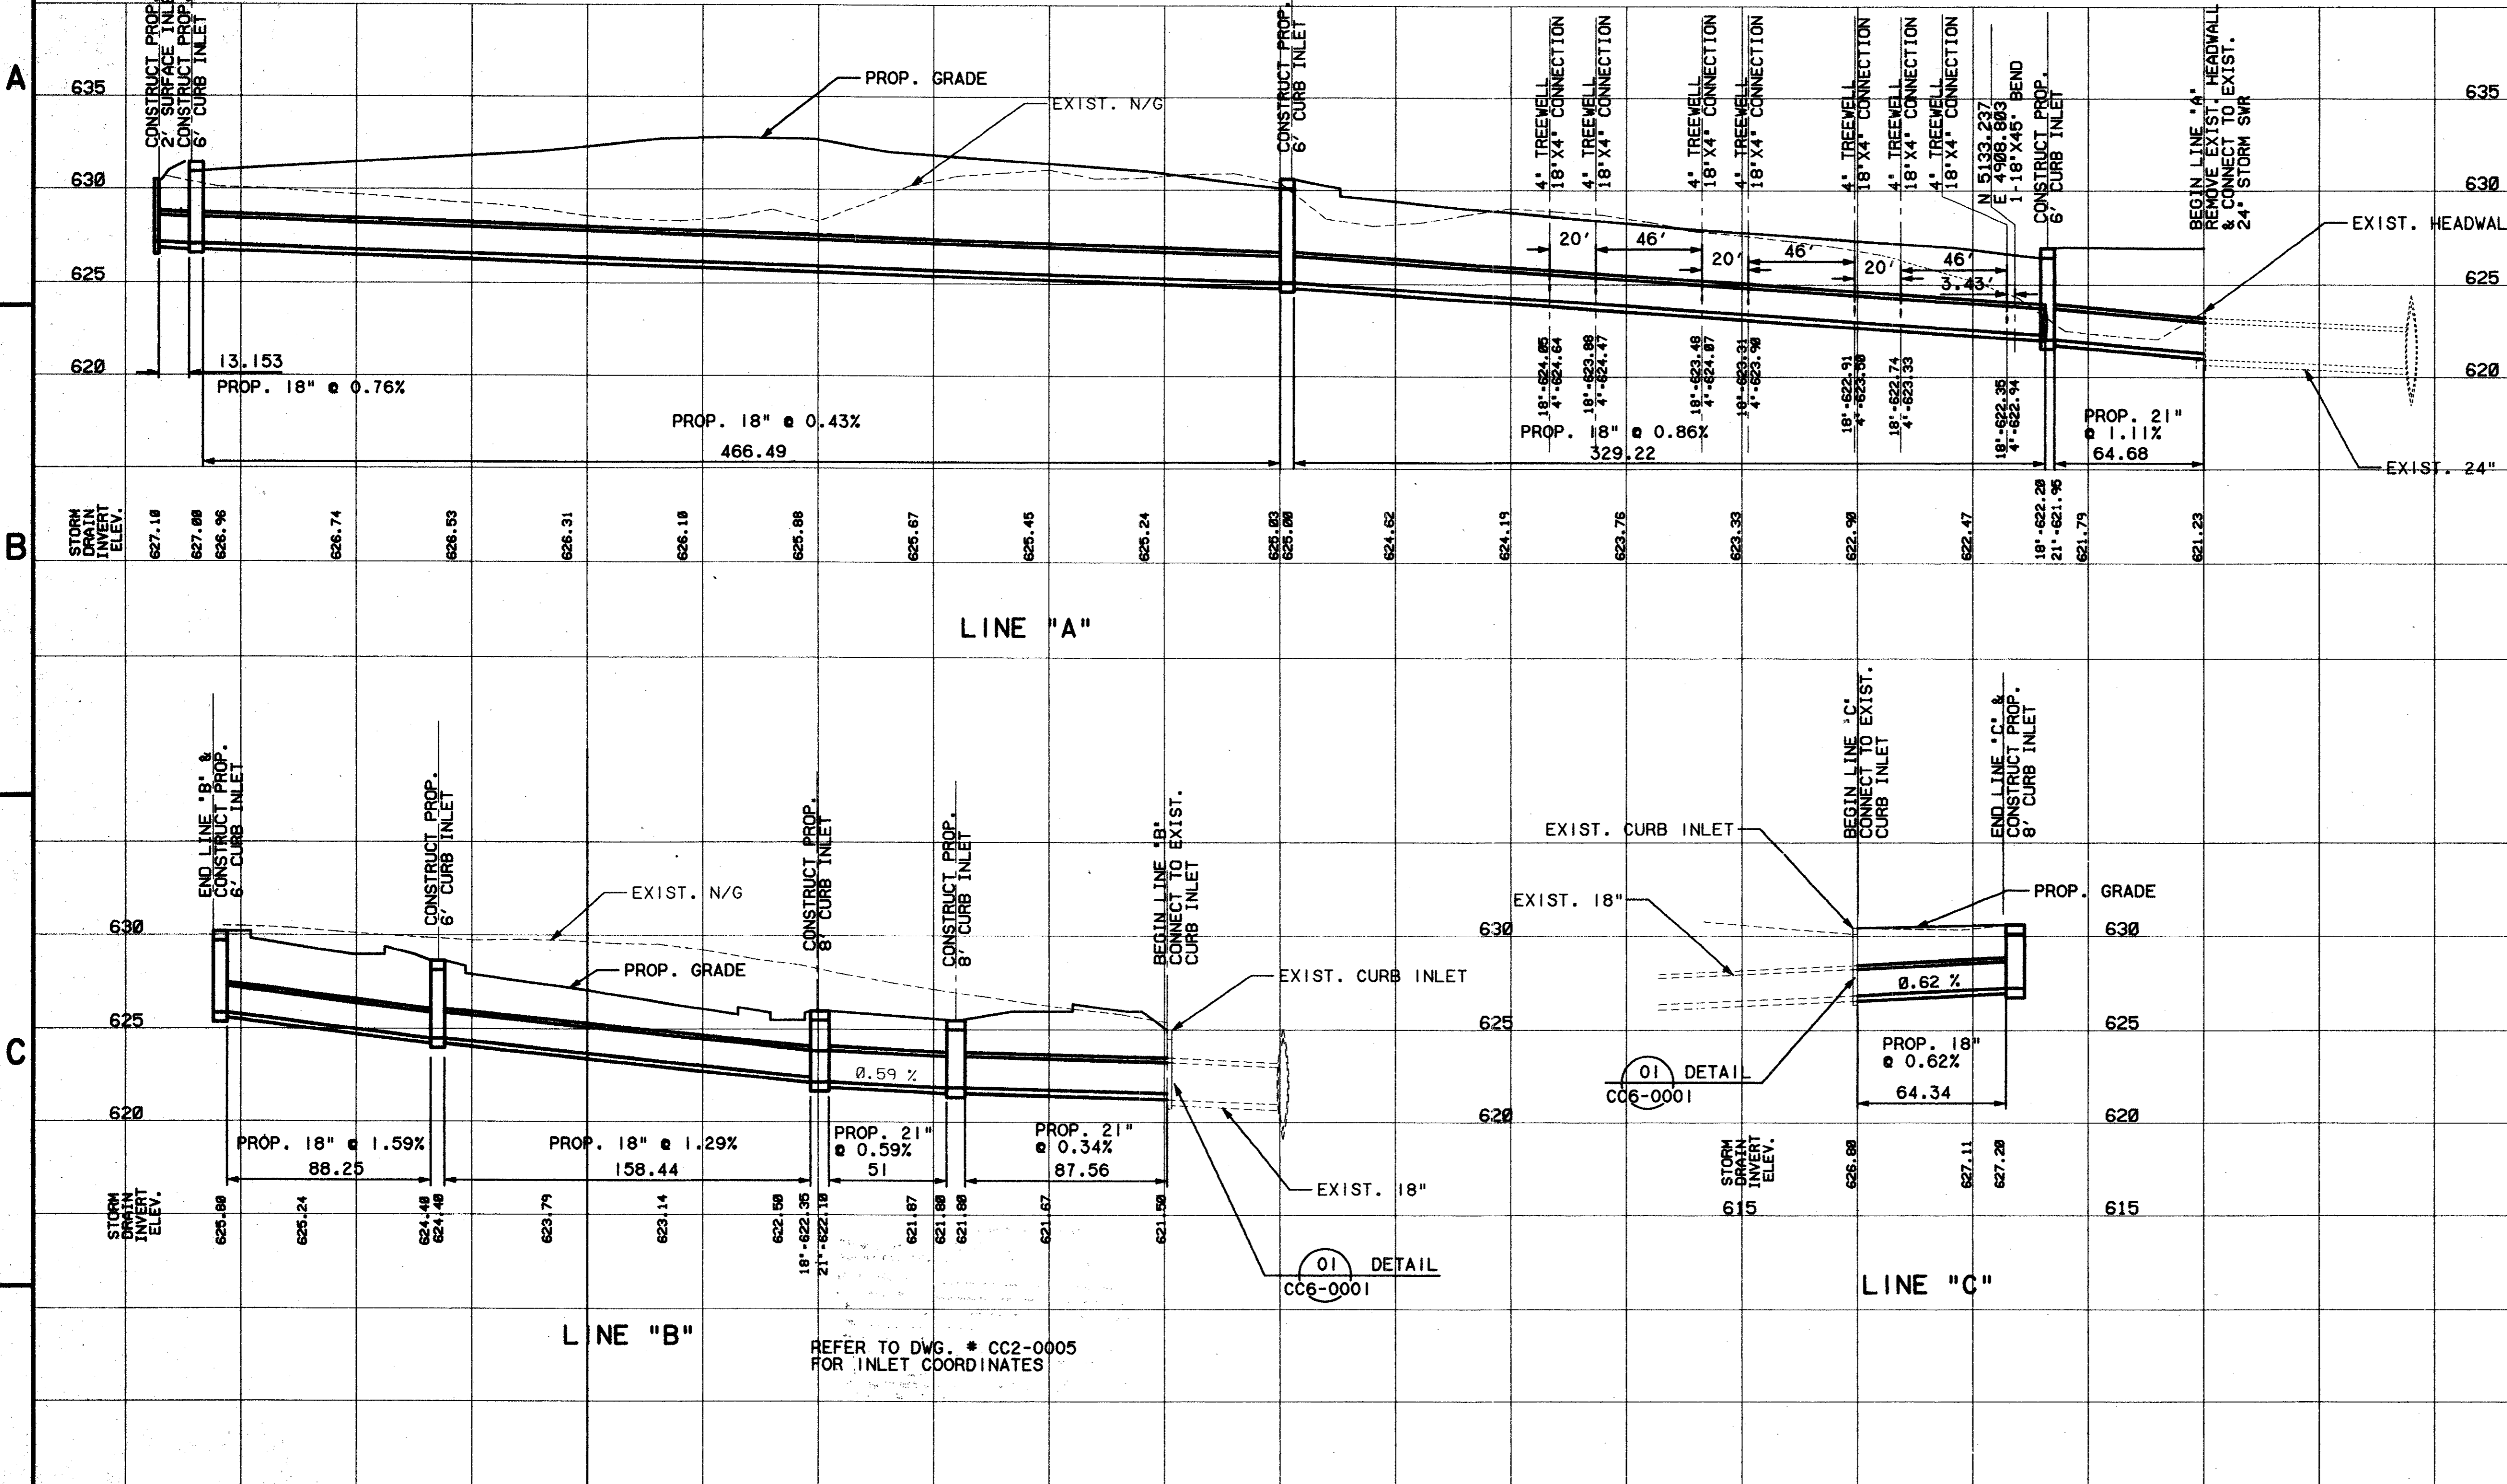


7-7-99

CONFORMED
 I hereby certify that the above is a true and correct copy of the original as shown to me by the engineer or architect.
 JAMES LANDRY
 JAMES LANDRY
 JAMES LANDRY



CONFORMED

CONTRACT SHEET No. 18 OF 95

REV	DATE	DESCRIPTION	BY	ENG	CHK	APP

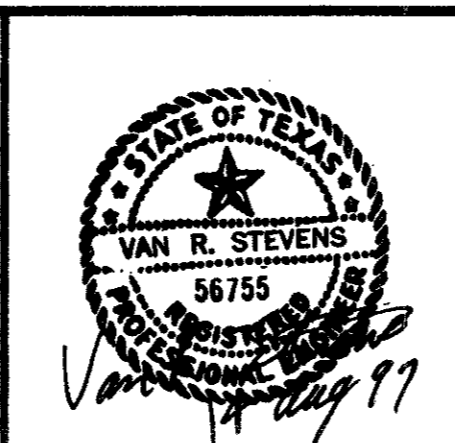

WENDY LOPEZ & ASSOC.
 LOCKWOOD, ANDREWS & NEWMAN
 THE SWA GROUP
 GERARD & ASSOCIATES
 ZAXON

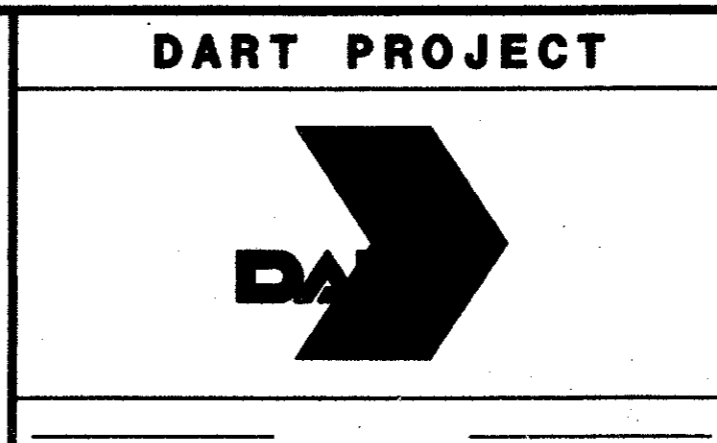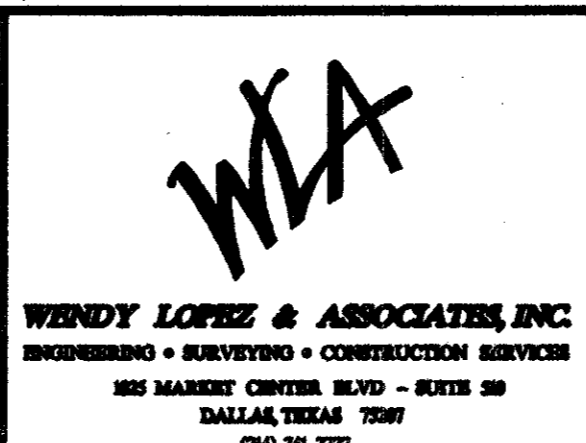

SCALE	1"=40'
DRAWN	D. KRUCIAK
DESIGNED	P. ZHAO
CHECKED	V. STEVENS
IN CHARGE	V. STEVENS
DATE	14-AUG-1997

ADDISON TRANSIT CENTER
STORM SEWER PROFILES

CONTRACT C-97000136 DWG No. CC2-0005 REV 0