

BROADWAY STREET

EXISTING RAIL LINE

QUORUM DRIVE

ARAPAHO ROAD (REALIGNED ROADWAY BY OTHERS)

4" 4000 PSI CONCRETE REINFORCED WITH #4 BARS AT 18" O.C.E.W.  
6" LIME TREATED SUBBASE EXTENDED 1 FT. OUTSIDE OF NEW PAVEMENT EDGE (35LBS/SY) (8X)

#4 DOWELS @ 15" O.C. FOR COLD JOINTS SAW CUT CONSTRUCTION JOINT & SEAL.

GRADE @ -0.50% AWAY FROM EXIST. CONC. EDGE  
NO CURB 181'

TRANSVERSE SAWED CONTROL JOINTS 15' MAX.

CANOPY (TYP.)

FF=633.50

MATCH EXIST. ELEVATION

80 LF OF NEW CURB

MATCH EXIST. CURB

8' WIDE CONCRETE SIDEWALK, 4" 4000 PSI CONCRETE REINFORCED WITH #3 BARS AT 18" O.C.E.W.

8 CM CONC. PAVERS (SEE LANDSCAPE DWG.'S)  
12" 4000 PSI CONCRETE REINFORCED WITH #4 BARS AT 18" O.C.E.W.

8" 4000 PSI CONCRETE REINFORCED WITH #4 BARS AT 18" O.C.E.W.

6" 4000 PSI CONCRETE REINFORCED WITH #4 BARS AT 18" O.C.E.W.

PAVEMENT LEGEND

- 12" BUSWAY CONC. PAVEMENT INCLUDING PAVERS
- 8" BUSWAY CONC. PAVEMENT
- 6" NON-BUSWAY CONC. PAVEMENT
- 4" CONC. PAVEMENT

- NOTE:
- SEE DWG. #CC6-0004 FOR 12" BUSWAY CONCRETE PAVEMENT SECTION, SHOWING FULL DEPTH CONCRETE OR SECTION INCLUDING PAVERS.
  - FOR NEW LOCATION & DETAILS OF RELOCATED LIGHT POLE, CONTRACTOR SHALL COORDINATE WITH THE CONTRACTING OFFICER. REFER TO SPECIFICATION SECTION 02072.

COMPACTED FILL TO A MINIMUM OF 95 PERCENT OF MAXIMUM DRY DENSITY AS DETERMINED BY ASTM D-698 (ALLOWABLE ± OF OPTIMUM MOISTURE CONTENT PER SOILS REPORT).

6" LIME TREATED SUBBASE (35LBS/SY) (8X)

COMPACTED FILL TO A MINIMUM OF 95 PERCENT OF MAXIMUM DRY DENSITY AS DETERMINED BY ASTM D-698 (ALLOWABLE ± OF OPTIMUM MOISTURE CONTENT PER SOILS REPORT).

6" LIME TREATED SUBBASE (35LBS/SY) (8X)

6" LIME TREATED SUBBASE (35LBS/SY) (8X)

COMPACTED FILL TO A MINIMUM OF 95 PERCENT OF MAXIMUM DRY DENSITY AS DETERMINED BY ASTM D-698 (ALLOWABLE ± OF OPTIMUM MOISTURE CONTENT PER SOILS REPORT).

BUSWAY PAVEMENT w/ PAVER BANDS DETAIL

SCALE: 1"=1'-0"

BUSWAY PAVEMENT DETAIL

SCALE: 1"=1'-0"


NON-BUSWAY PAVEMENT DETAIL

SCALE: 1"=1'-0"

CONFORMED


CONTRACT SHEET No. 21 OF 95

REV	DATE	DESCRIPTION	BY	ENG	CHK	APP	REV	DATE	DESCRIPTION	BY	ENG	CHK	APP
△	8/30/97	RECORD AS BUILT	EDM		SLM								
△													
△													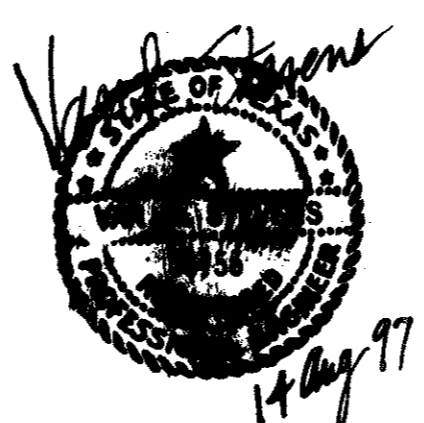
WENDY LOPEZ & ASSOC.  
LOCKWOOD, ANDREWS & NEWNAM  
THE SWA GROUP  
GERARD & ASSOCIATES  
ZAXON

**WLA**  
WENDY LOPEZ & ASSOCIATES, INC.  
ENGINEERING • SURVEYING • CONSTRUCTION SERVICES  
1825 MARKET CENTER BLVD - SUITE 510  
DALLAS, TEXAS 75207  
(214) 746-7777

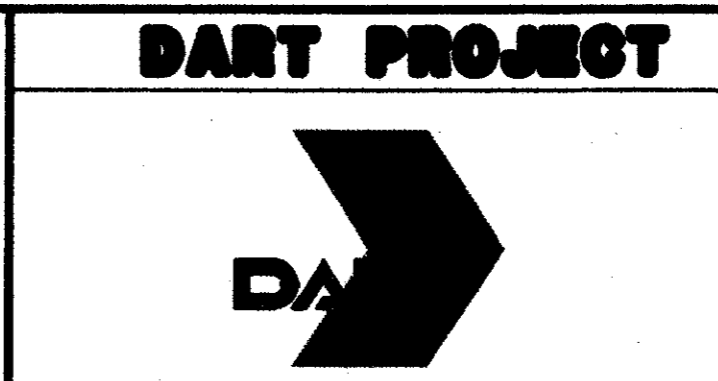

SCALE 1"=40'  
DRAWN D. KRUCIAK  
DESIGNED P. ZHAO  
CHECKED V. STEVENS  
IN CHARGE J. STEVENS  
DATE AUG. 14, 1997

ADDISON TRANSIT CENTER  
PAVING PLAN