




c:\cadd\94010.2\12\sh\dtcc\01.37
 02 MAR 98
 DART.TBL
 \$(USER)

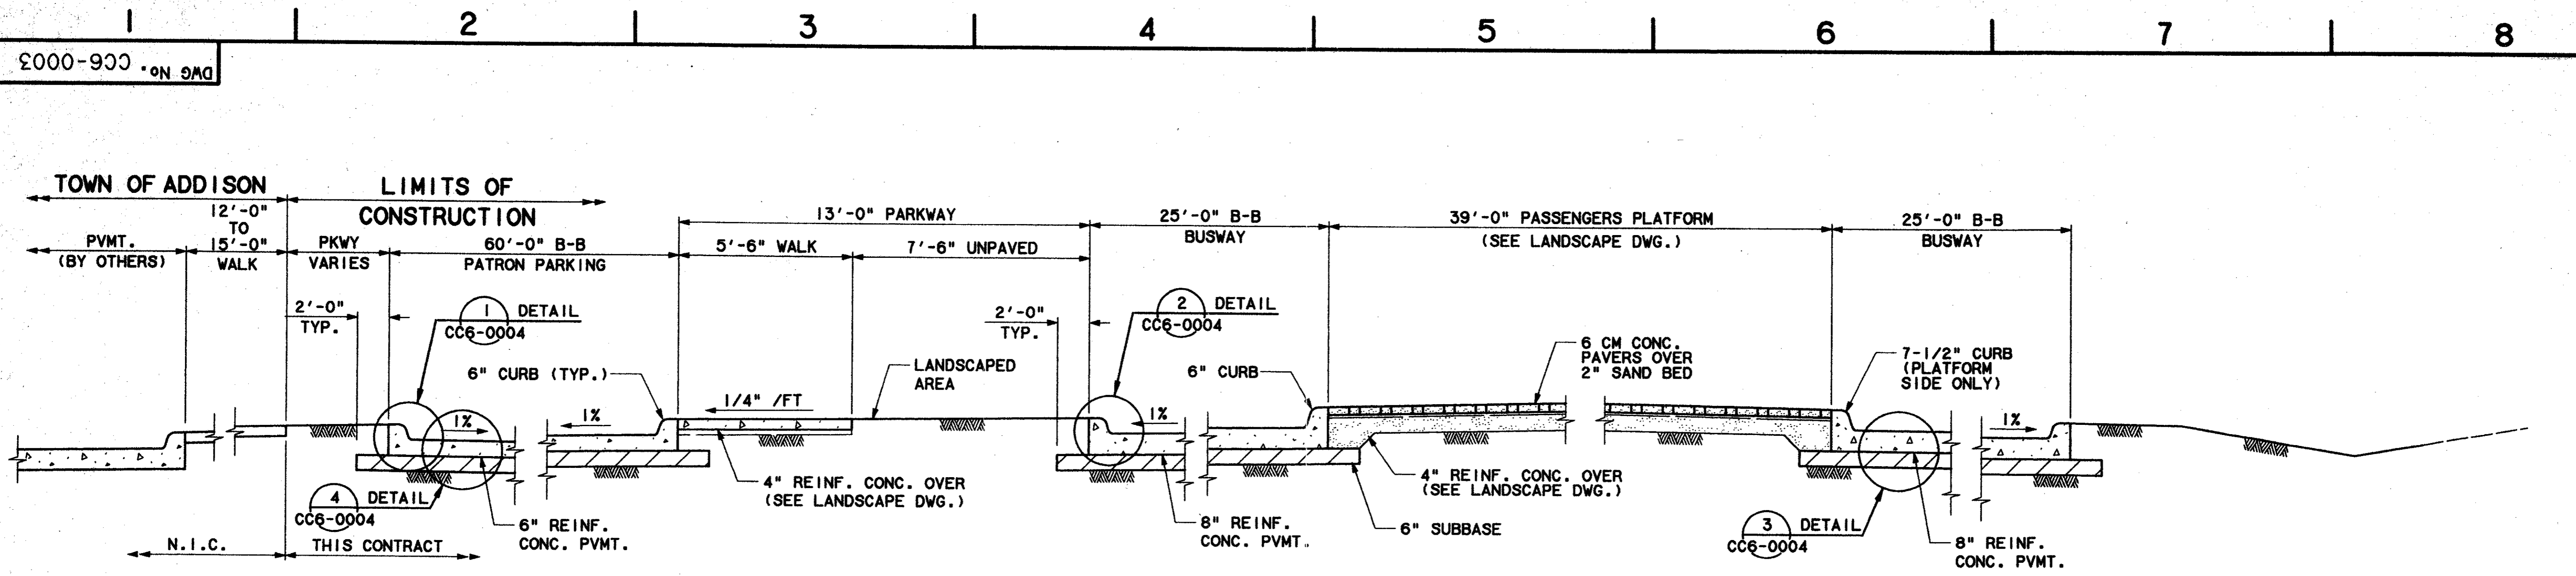


SECTION A
 SCALE: 3/8"=1'-0" CC5-0004

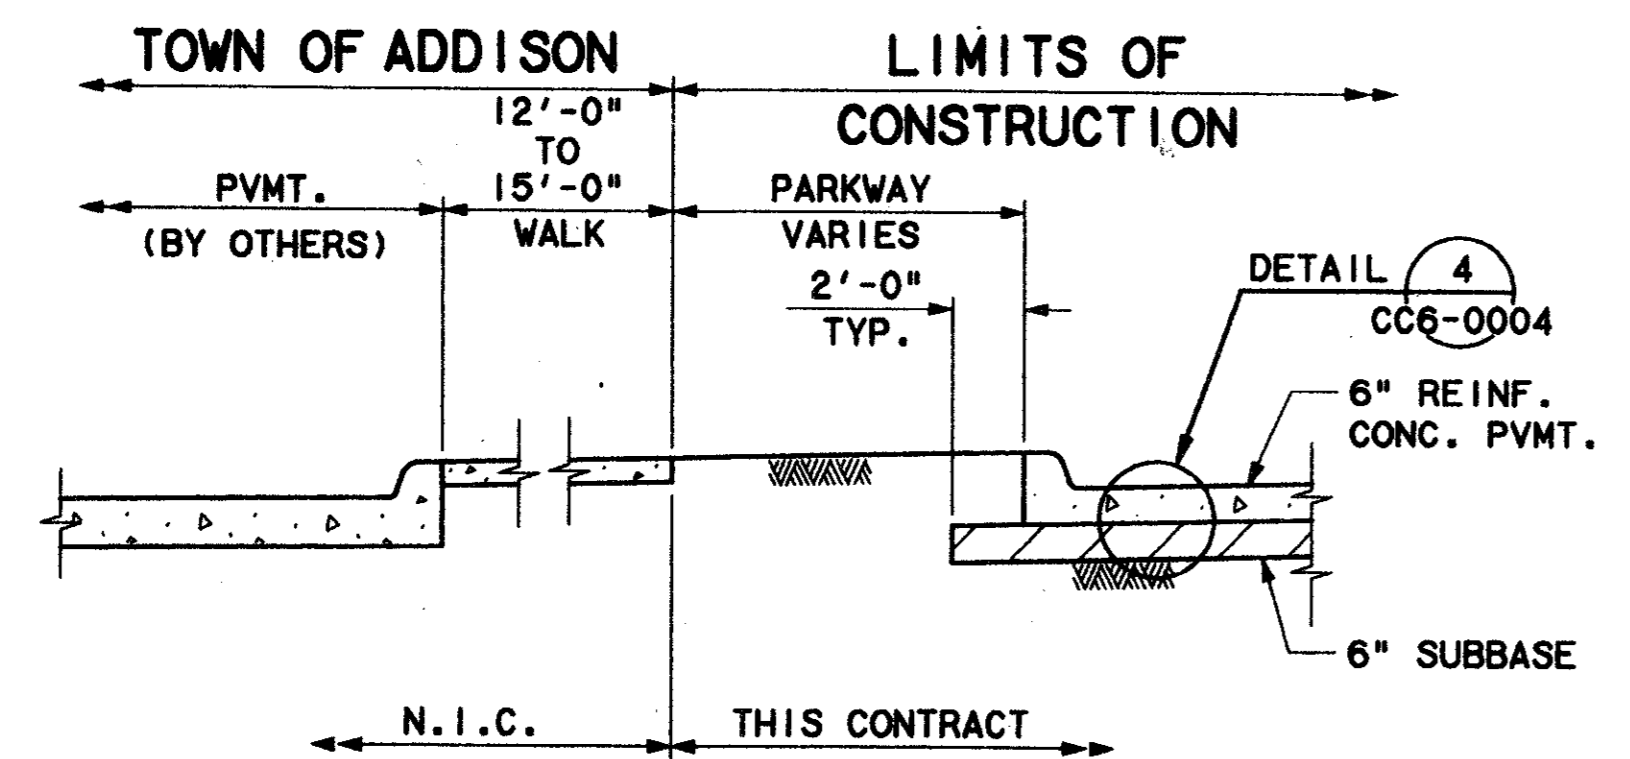

SECTION D
 SCALE: 3/8"=1'-0" CC5-0004

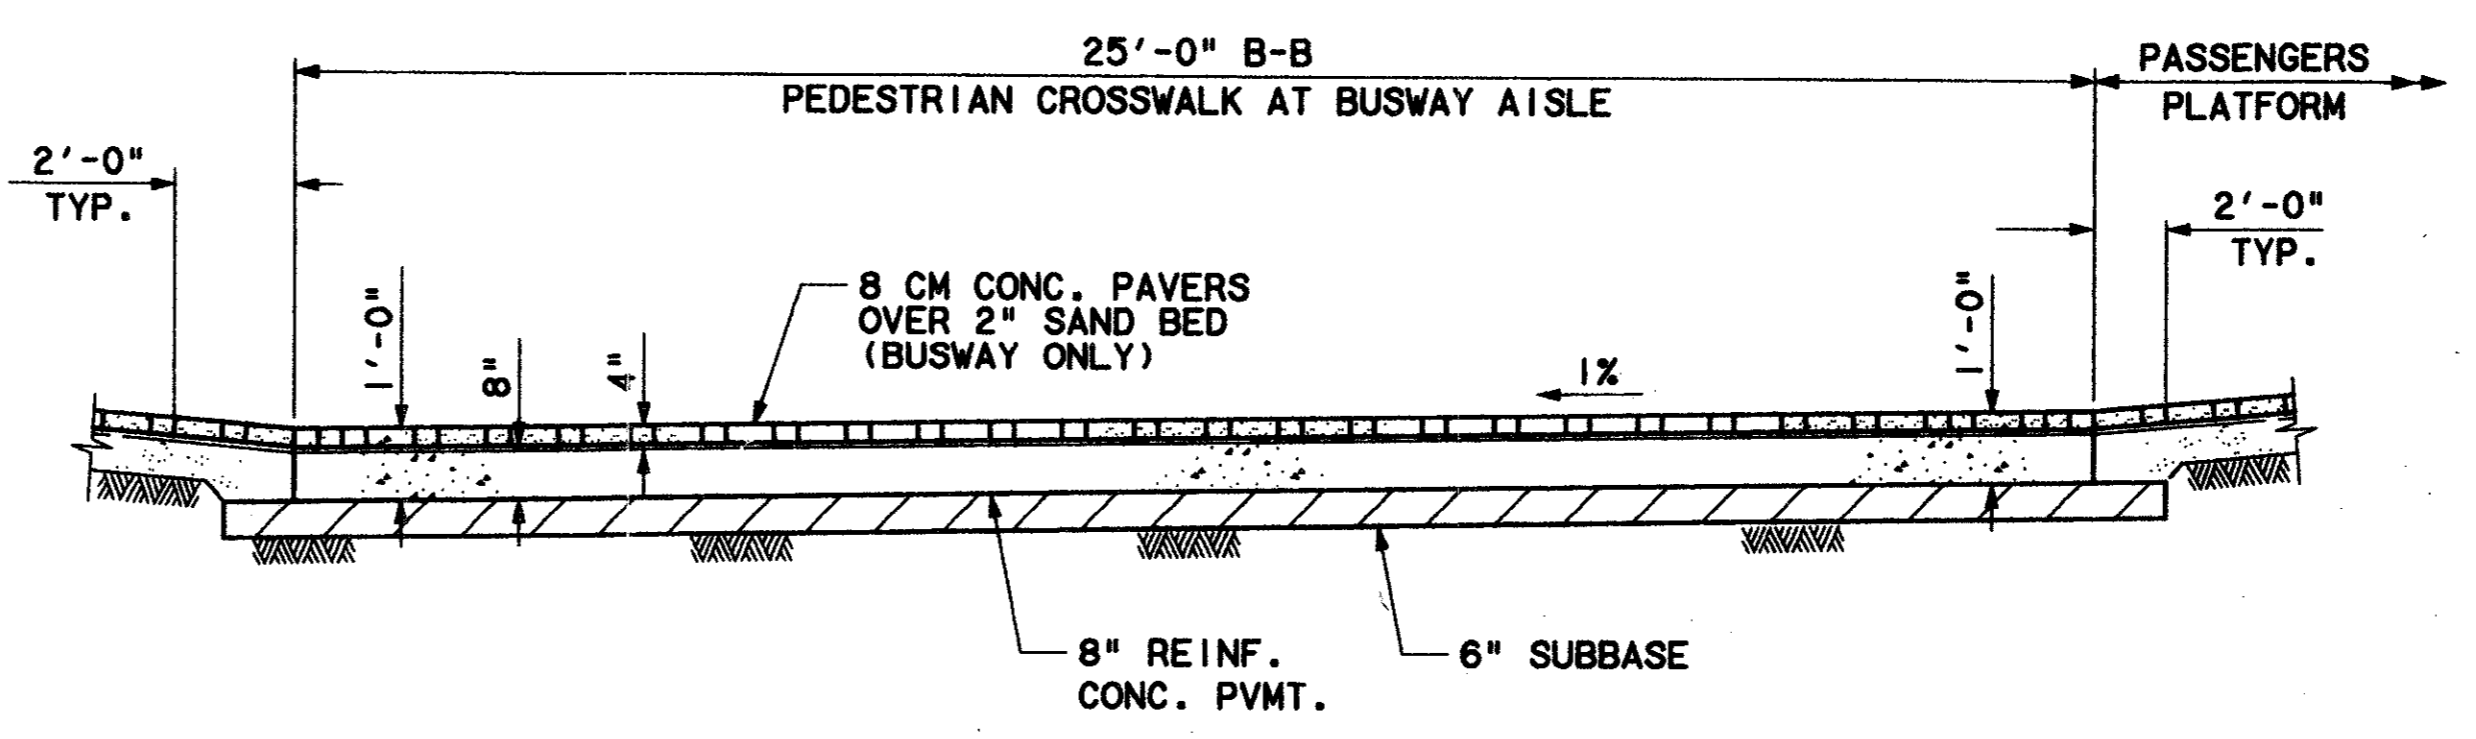

SECTION B
 SCALE: 3/8"=1'-0" CC5-0004

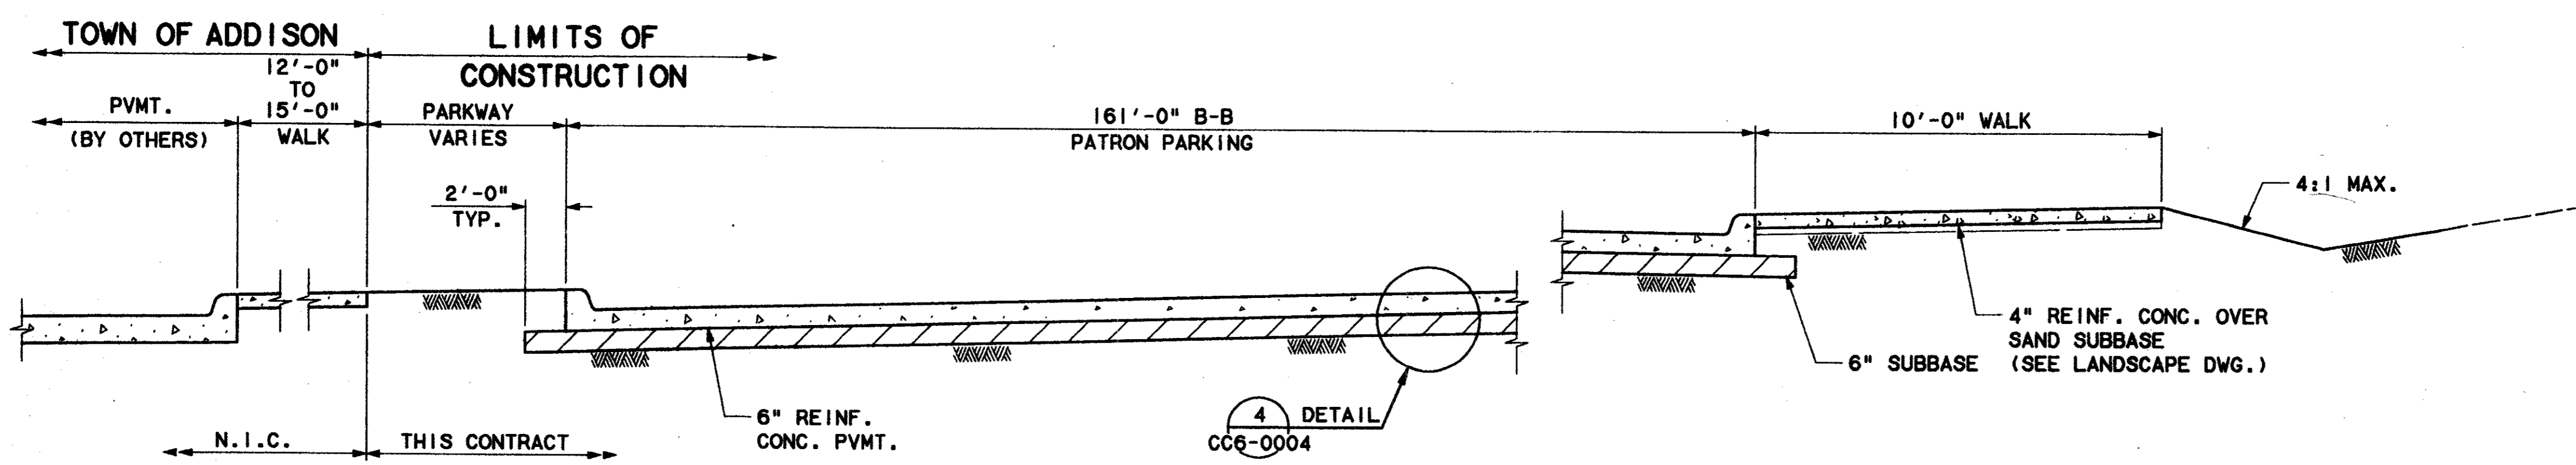

SECTION C
 SCALE: 3/8"=1'-0" CC5-0004


Record (As-built) Certificate
 This certificate is valid only for the project and location specified herein. It is not to be used for any other project or location. The contractor is responsible for the accuracy of the information provided. The engineer is responsible for the accuracy of the information provided. The date of this certificate is 7-7-99.

[Signature]
 PRESIDENT



CONFORMED

CONTRACT SHEET No. 24 OF 95

REV	DATE	DESCRIPTION	BY	ENG	CHK	APP	REV	DATE	DESCRIPTION	BY	ENG	CHK	APP

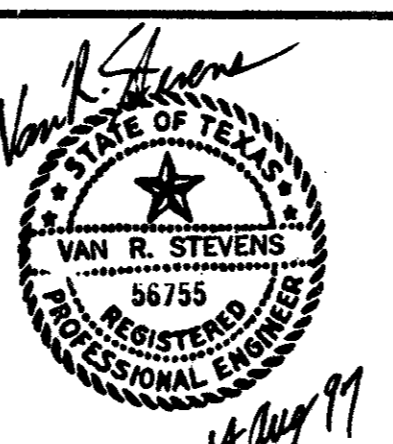

WENDY LOPEZ & ASSOC.
 LOCKWOOD, ANDREWS & NEWNAM
 THE SWA GROUP
 GERARD & ASSOCIATES
 ZAXON

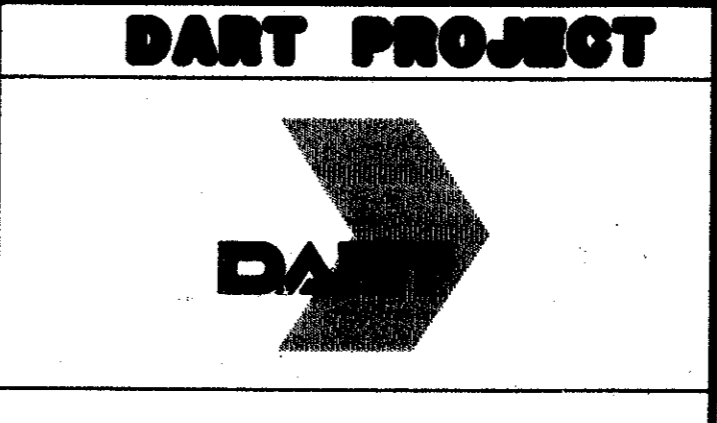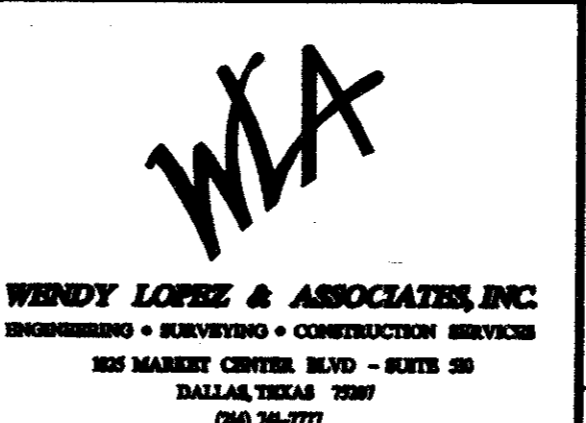

SCALE 3/8"=1'-0"
 DRAWN N. DEREMER
 DESIGNED P. ZHAO
 CHECKED V. STEVENS
 IN CHARGE V. STEVENS
 DATE 14 AUG. 1997

ADDISON TRANSIT CENTER
TYPICAL SECTIONS

CONTRACT C-97000136 DWG No. CC6-0003 REV 0