




F:\TRANSIT CENTERS\ABTC\ABTCPR1.040, 1-11, 13, 15-32, 34-49, 51-62, 64, 66, 68, 998, 1000

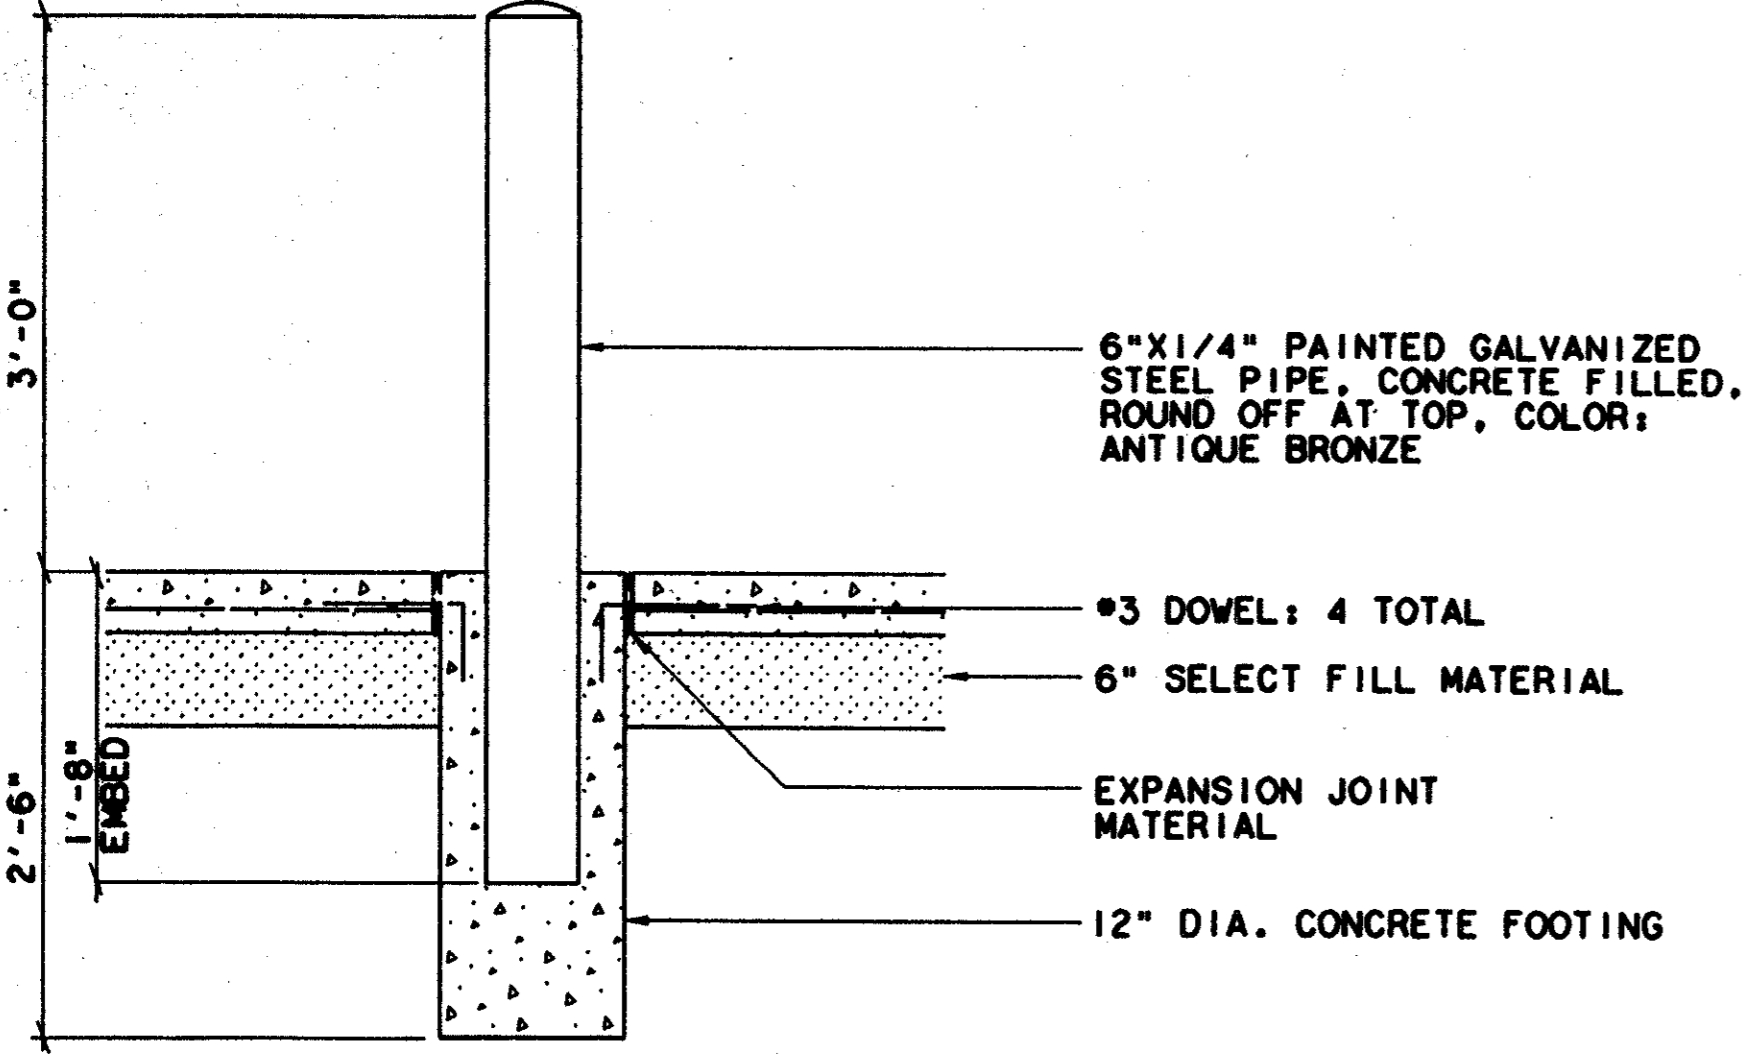


PEDESTRIAN PIPE BOLLARD - SECTION
SCALE: 1"=1'-0"

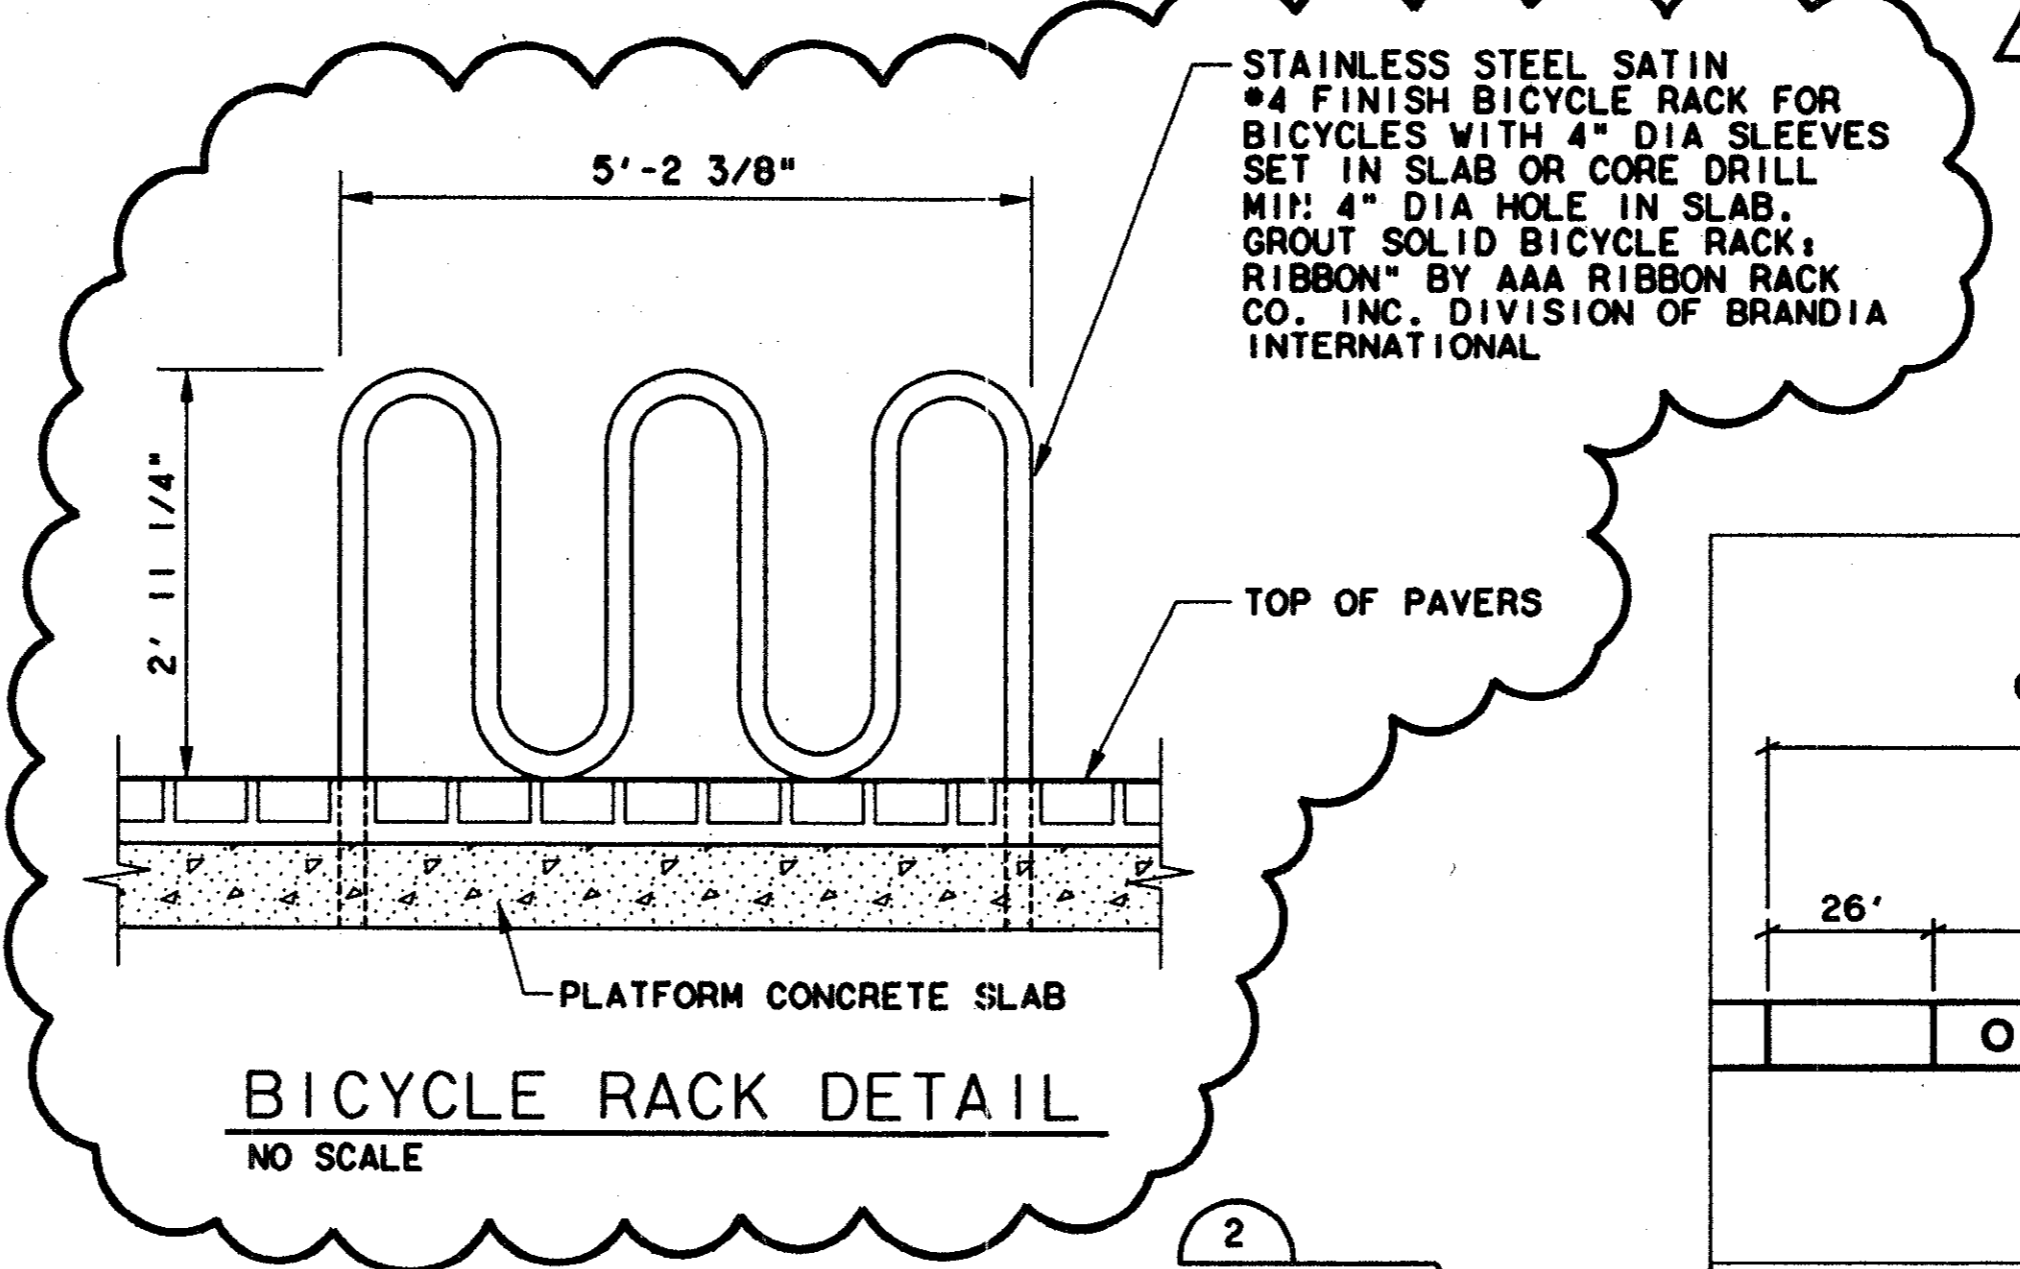


STAINLESS STEEL SATIN #4 FINISH BICYCLE RACK FOR BICYCLES WITH 4" DIA SLEEVES SET IN SLAB OR CORE DRILL MIN: 4" DIA HOLE IN SLAB. GROUT SOLID BICYCLE RACK; RIBBON" BY AAA RIBBON RACK CO. INC. DIVISION OF BRANDIA INTERNATIONAL

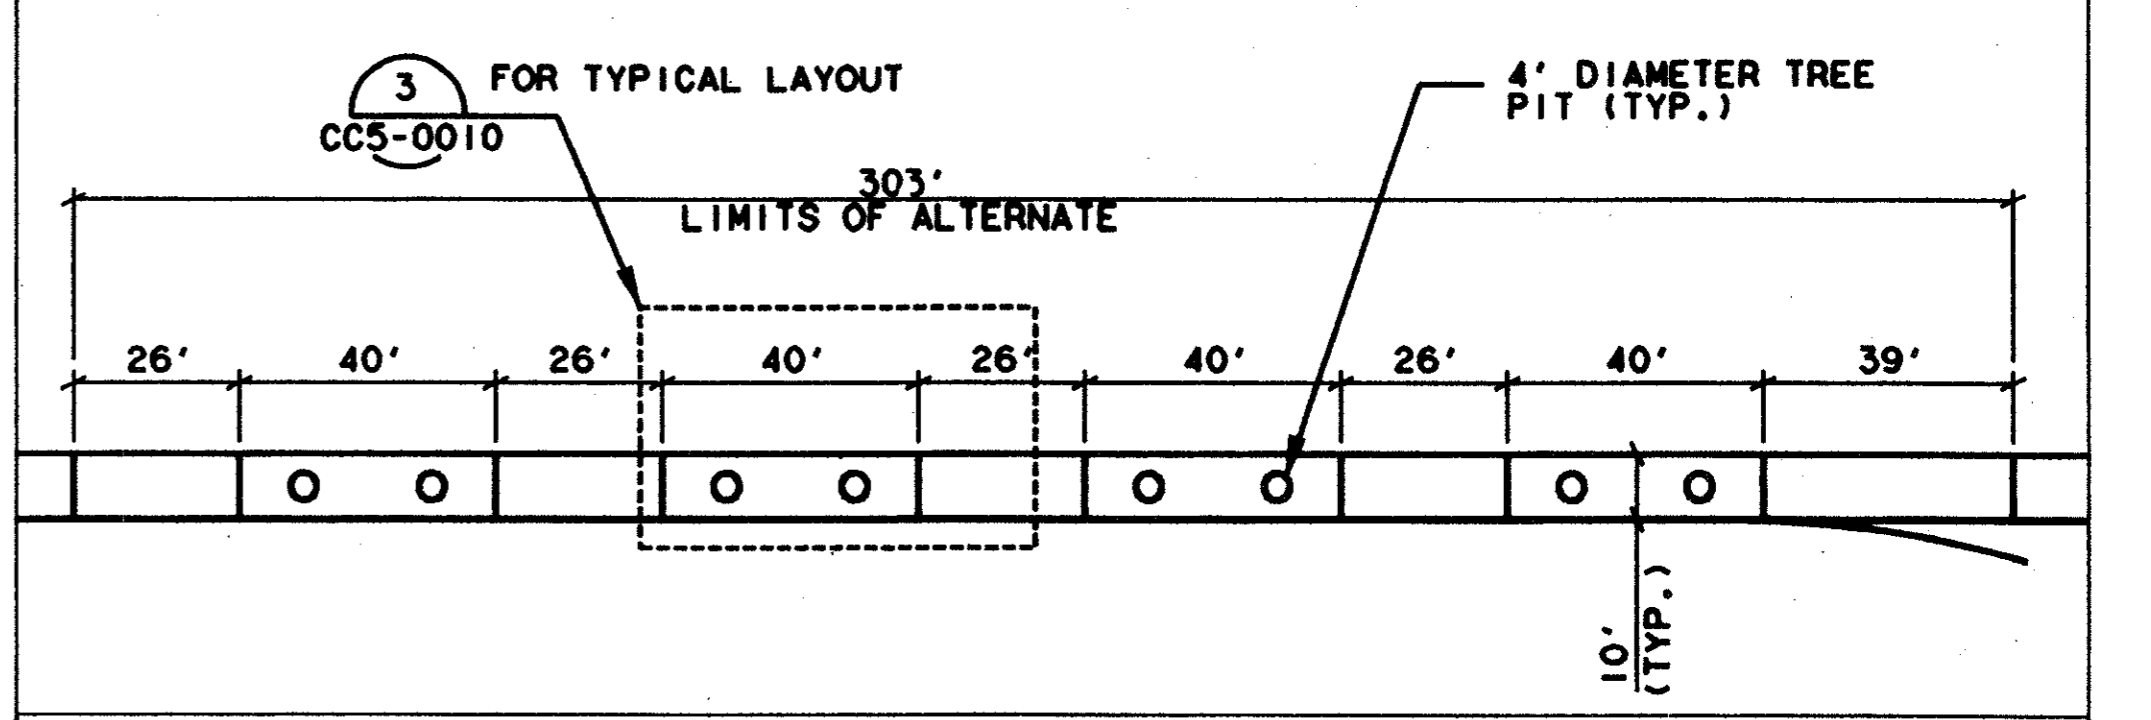

BRICK PAVER ALTERNATE - PLAN
SCALE: 1"=30'-0"

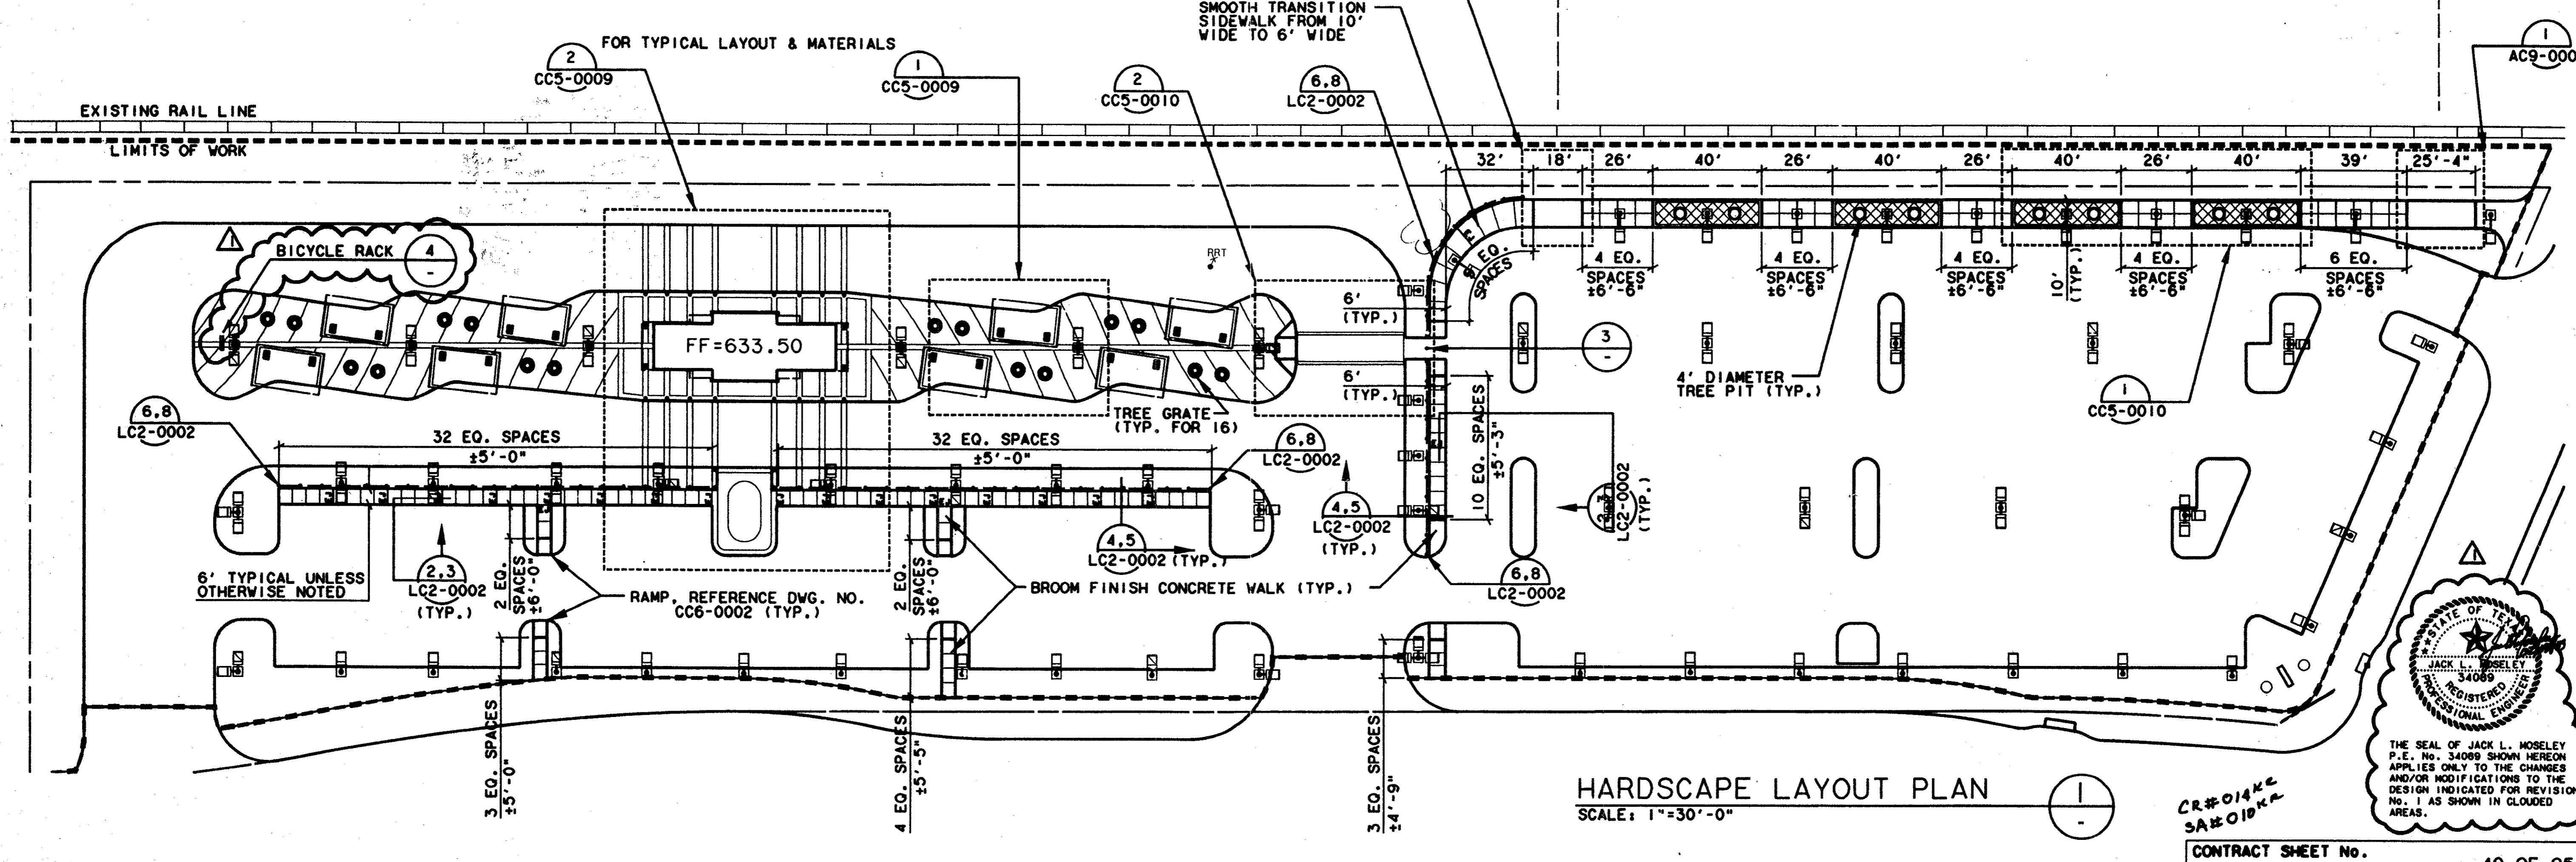

HARDSCAPE LAYOUT PLAN
SCALE: 1"=30'-0"

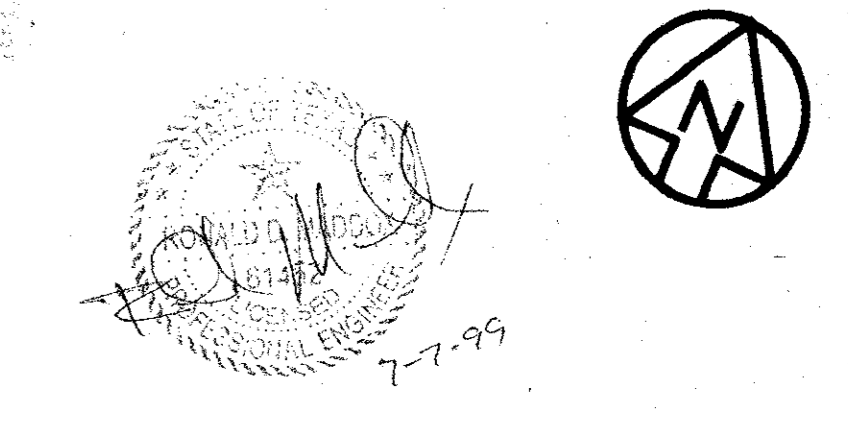

CR#01AK
SA#01DK

REV	DATE	DESCRIPTION	BY	ENG	CHK	APP	REV	DATE	DESCRIPTION	BY	ENG	CHK	APP

ORIGINAL SEAL(S) RESIDE IN DART FOR THE FOLLOWING REVISION(S):

REV 0: SEALED BY CHRISTOPHER L. MILLER, LANDSCAPE ARCHITECT No. 682

WLA
WENDY LOPEZ & ASSOCIATES, INC.
ENGINEERING • SURVEYING • CONSTRUCTION SERVICES
105 MARKET CENTER BLVD - SUITE 30
DALLAS, TEXAS 75207
(214) 741-7777

DART PROJECT
 DART

SCALE	1"=30'-0"
DRAWN	N. AVETON
DESIGNED	C. MILLER
CHECKED	C. MILLER
IN CHARGE	V. STEVENS
DATE	AUG. 14, 1997

CONTRACT SHEET No. 40 OF 95

ADDISON TRANSIT CENTER
HARDSCAPE LAYOUT PLAN

CONTRACT C-97000136 DVG No. CC5-0007